


9129

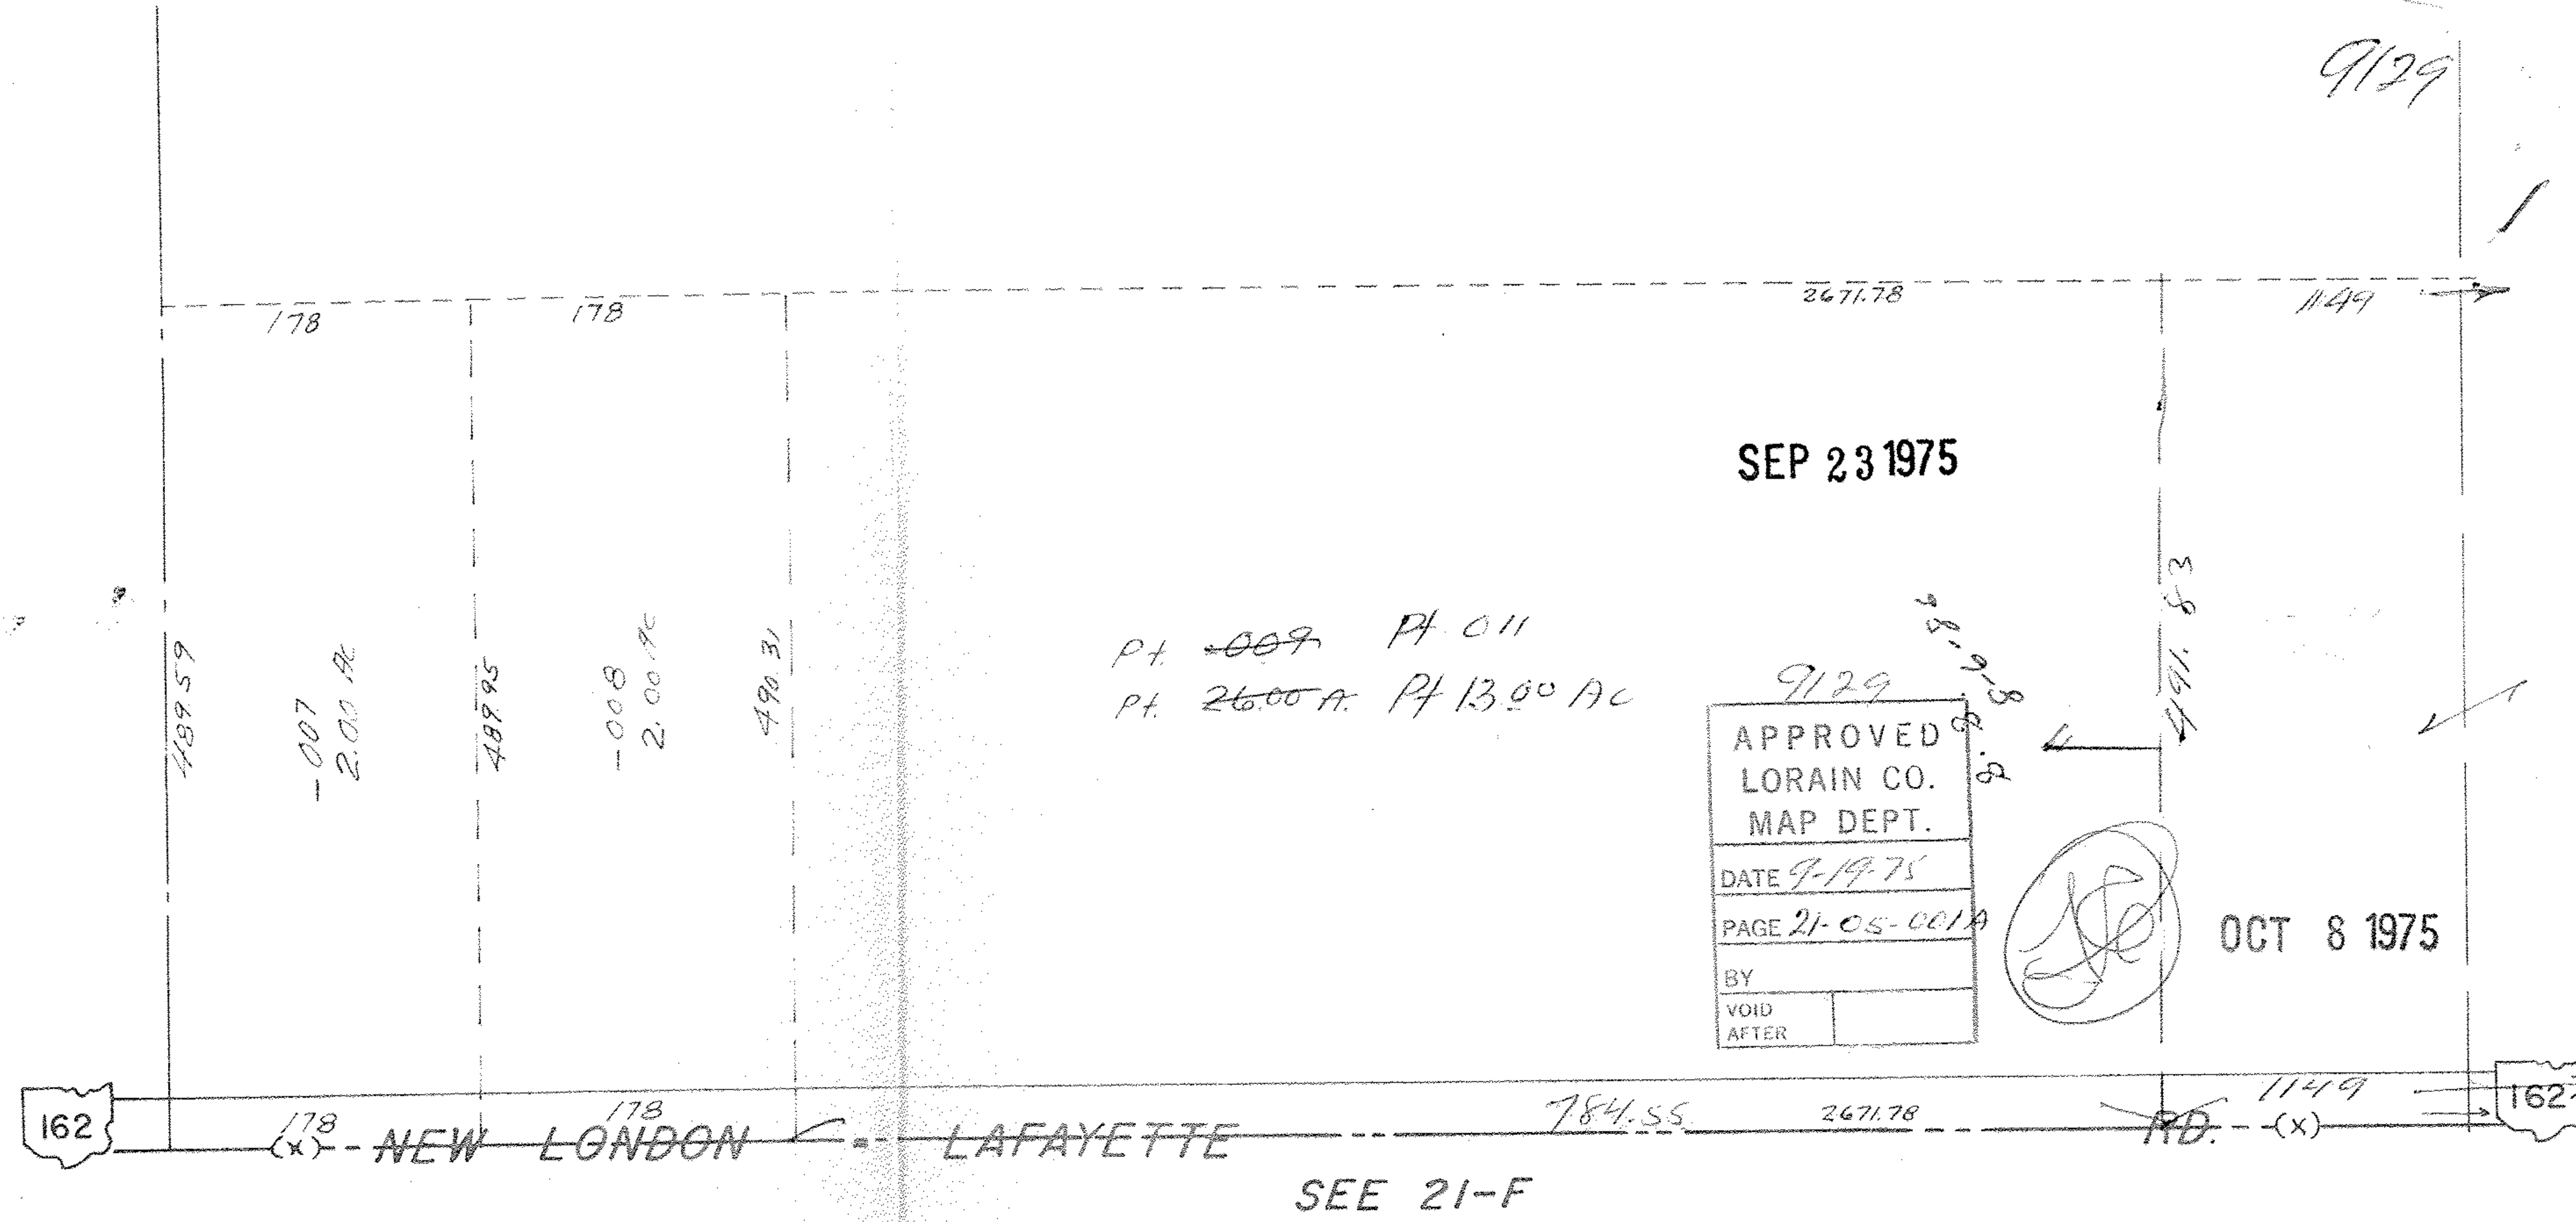

Copyright 1962
21-05-001-A

HUNTINGTON TWP.
SCALE: 1" = 100'

TRACT 5 WLY. PT. LOT 1