


9146

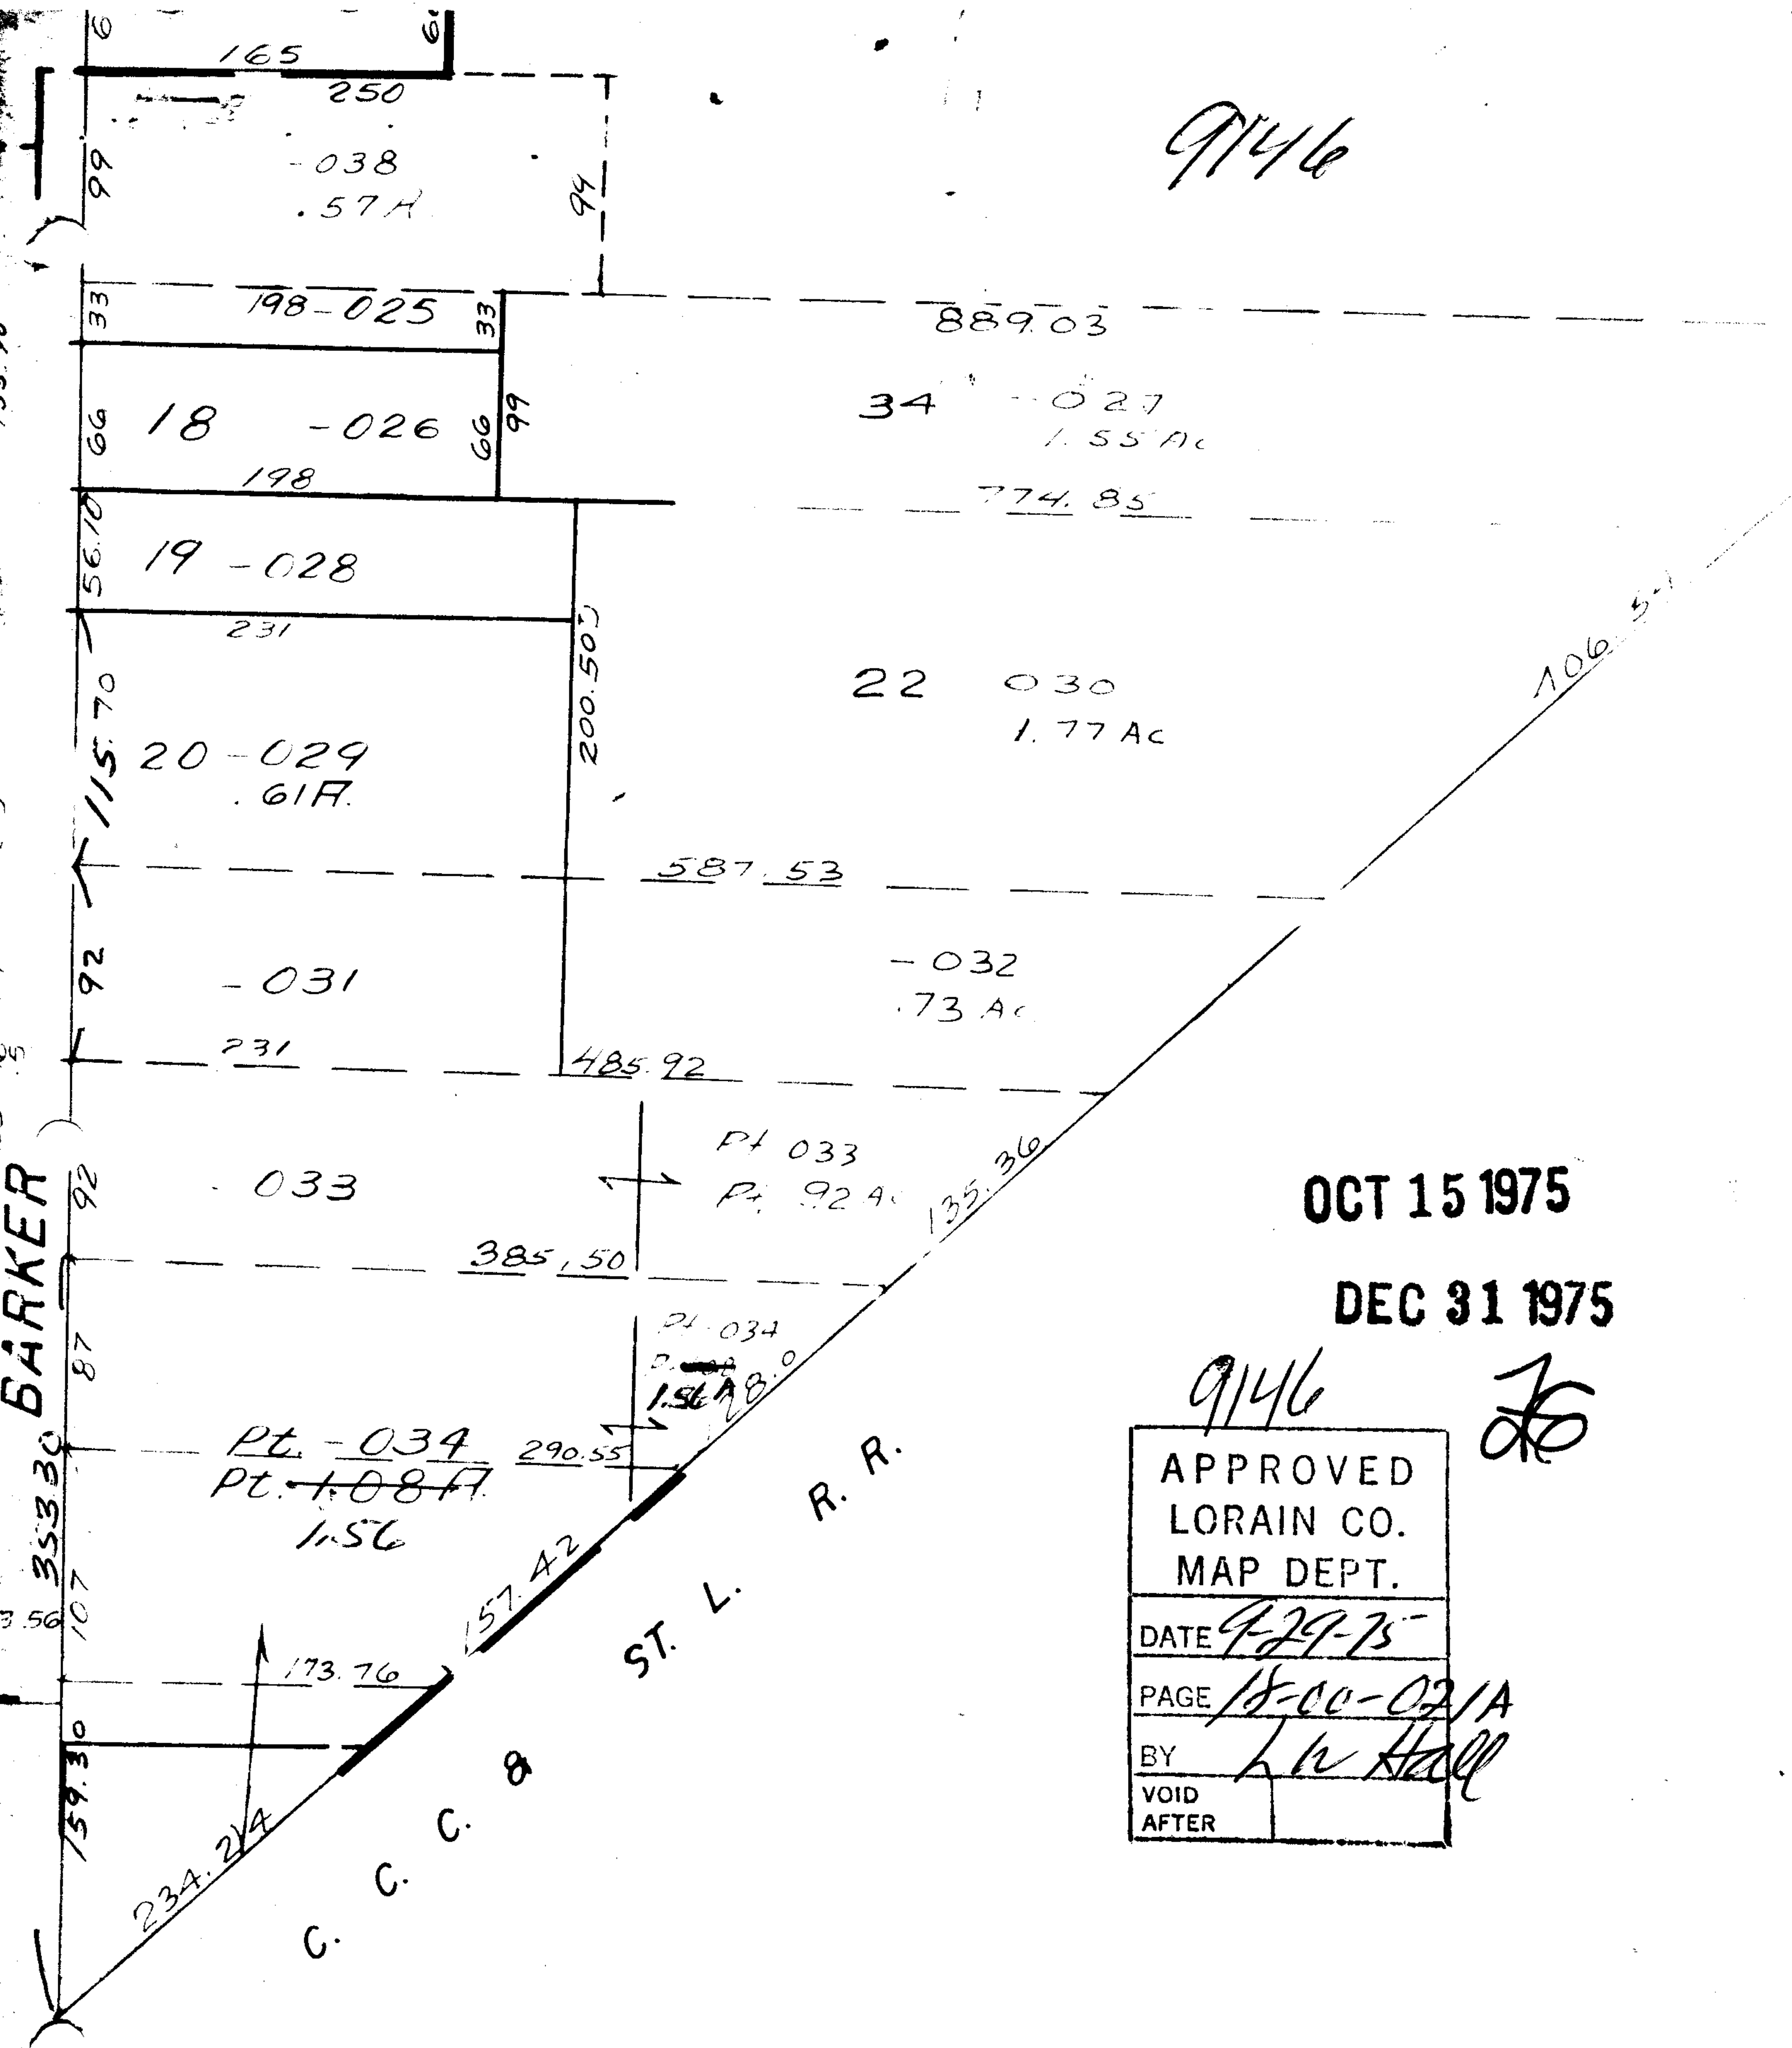

OCT 15 1975

DEC 31 1975

9146

75

APPROVED LORAIN CO. MAP DEPT.	
DATE	9-29-75
PAGE	18-00-02/A
BY	L. H. Hall
VOID AFTER	

NW 1/4 LOT 21