


9153

100
600
700
125
825
115.86
940.86

950.00
940.86
9.14

VOID THIS
Split

Correct Parcel
Numbers

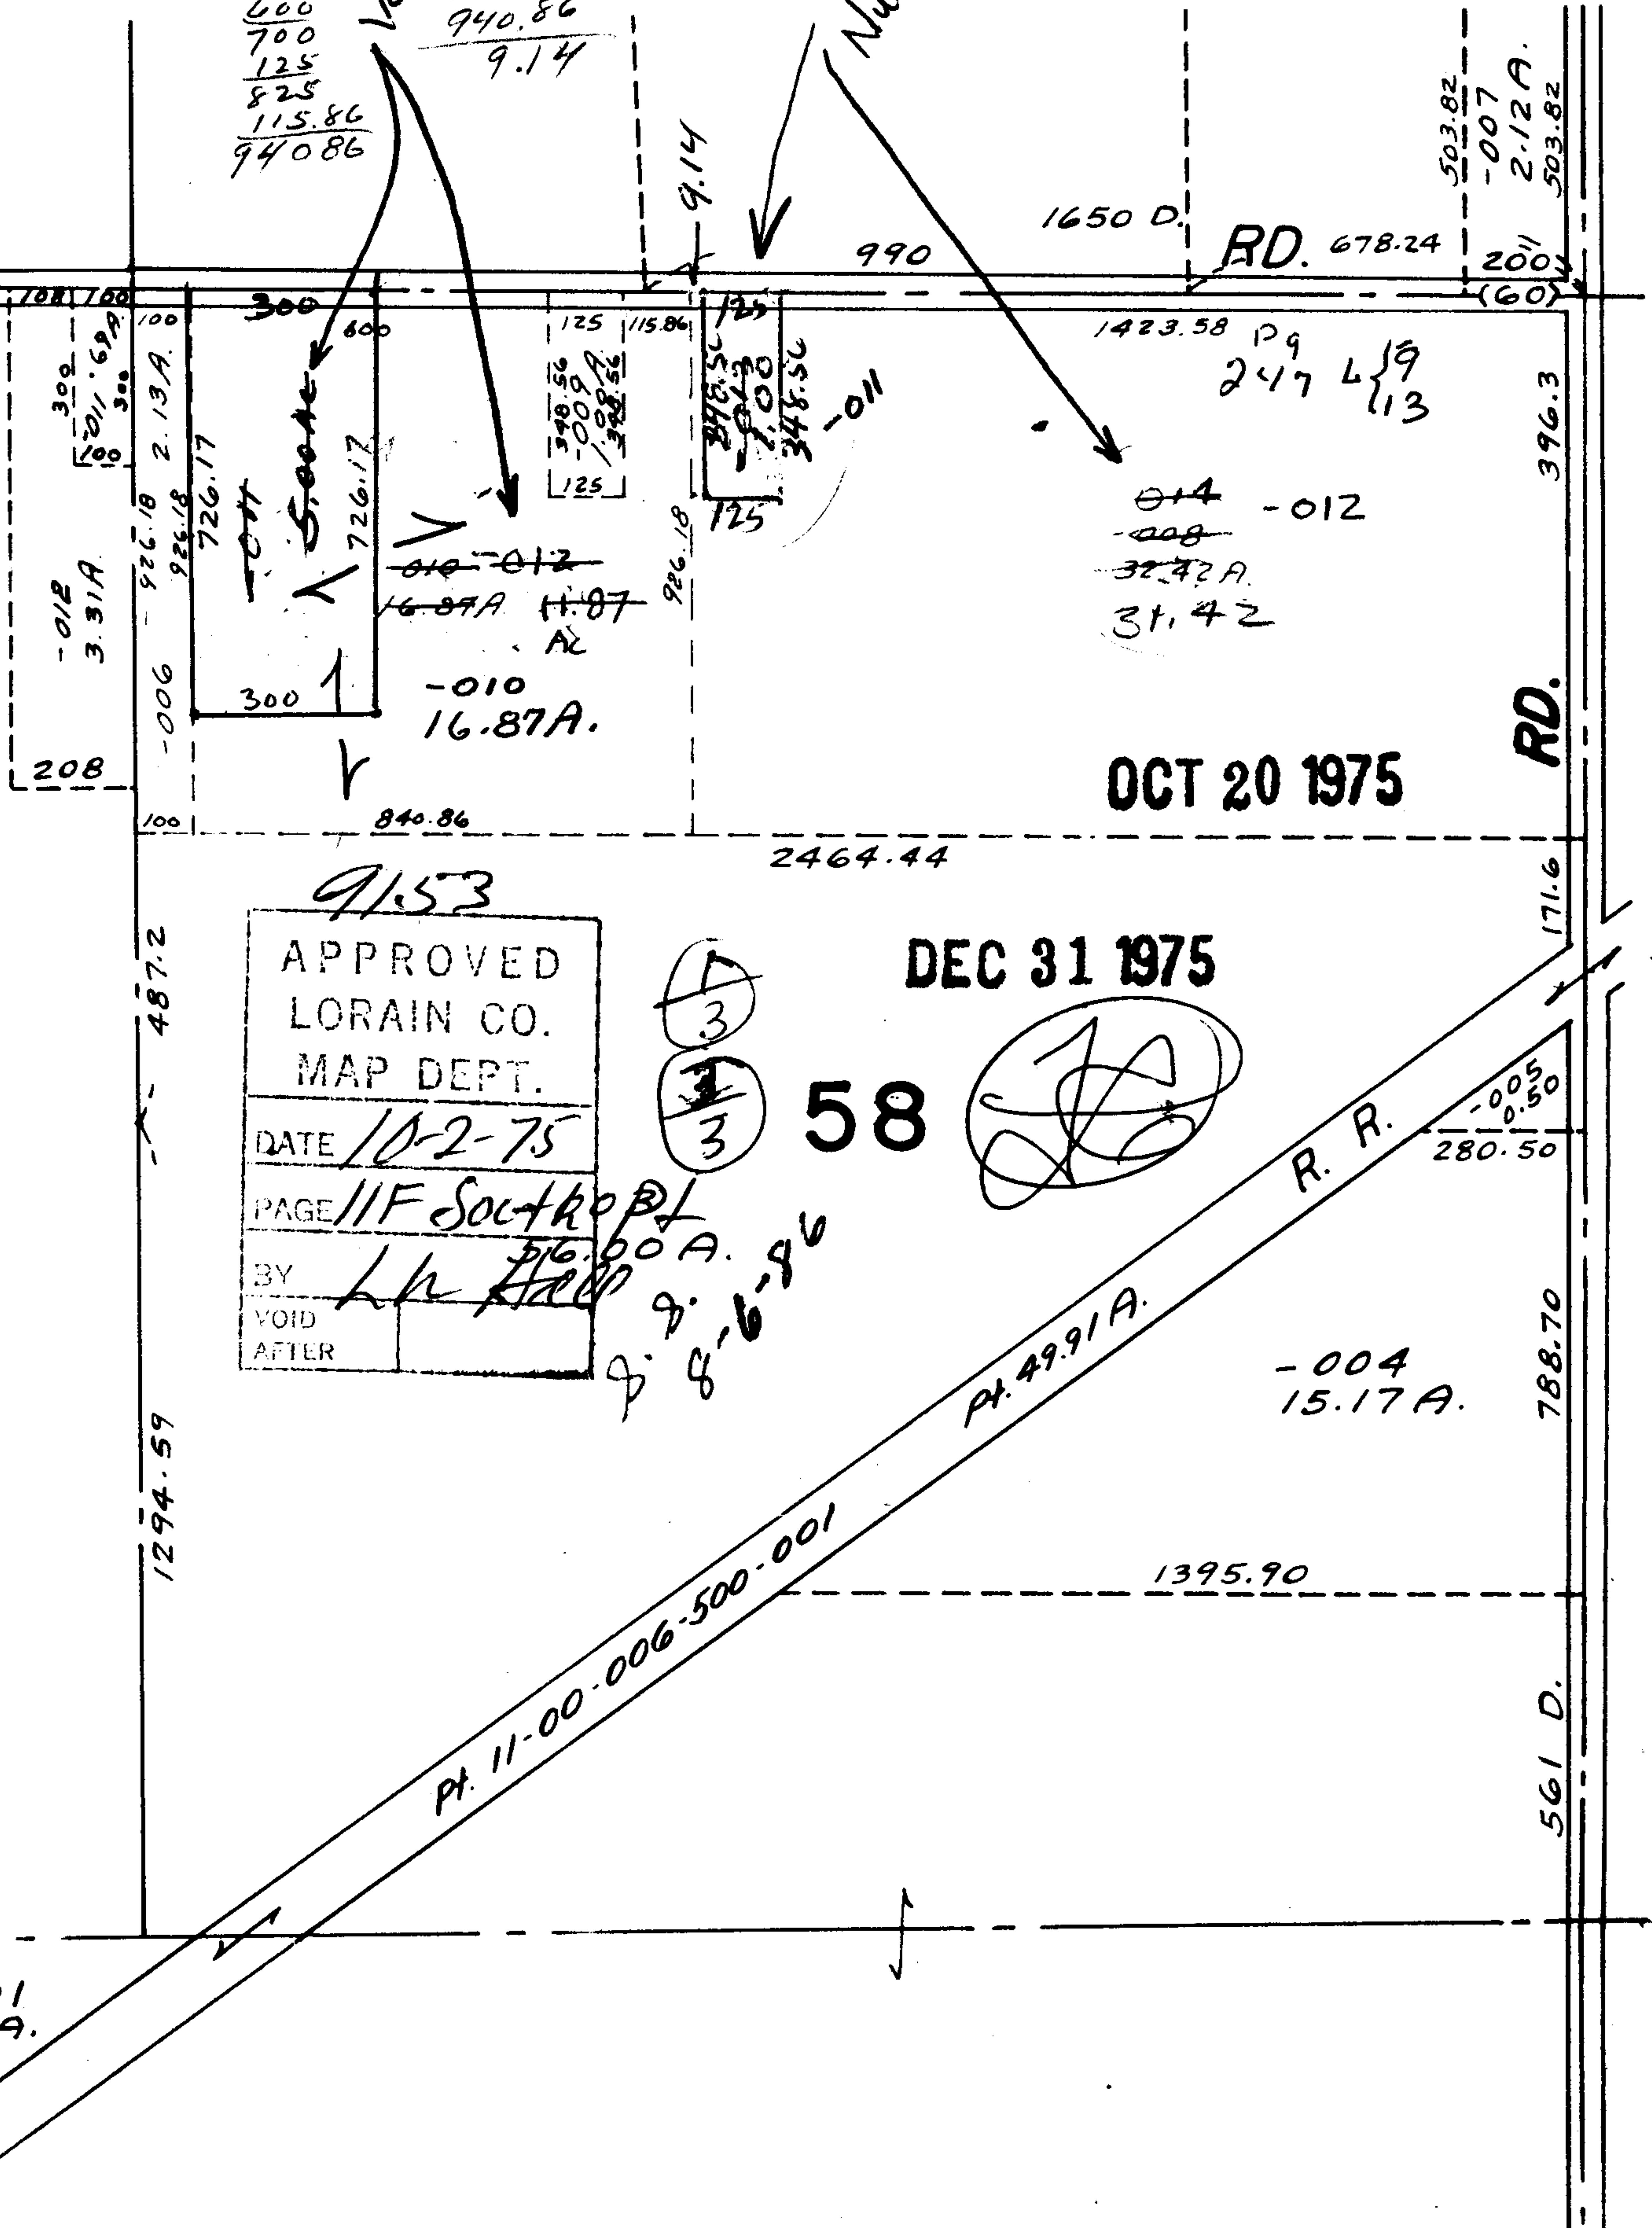

1081.760
300
300
100
300
-012
3.31A

300
600
726.17
926.18
2.13A
100
926.18
926.18
726.17

300
600
726.17
16.87A
11.87
AL
-010
16.87A

125
115.86
348.56
-005
300
300
300
125

125
115.86
348.56
-005
300
300
300
125

125
115.86
348.56
-005
300
300
300
125

1423.58
2476.19
31.42
32.42A
-014
-008
-012

1423.58
2476.19
31.42
32.42A
-014
-008
-012

503.82
-007
2.12A
503.82
200
(60)

OCT 20 1975

RD.

9153
APPROVED
LORAIN CO.
MAP DEPT.
DATE 10-2-75
PAGE 11F Southrop
BY L.H. [Signature]
VOID AFTER

DEC 31 1975

58

[Handwritten signature]

3
3
3
8-6-86

R. R.

-004
15.17A

Pt. 11-00-006-500-001

1395.90

561 D.

1294.59

487.2

2464.44

926.18

9.14

1650 D.

RD. 678.24

503.82
-007
2.12A
503.82

-004
42.50 A.

-001
437.59
37
50A.