


VICTORIA

FRANCES


ANSETT DEDICATION

PLAT V. 24 P. 70 BLVD. OCT 24 1975

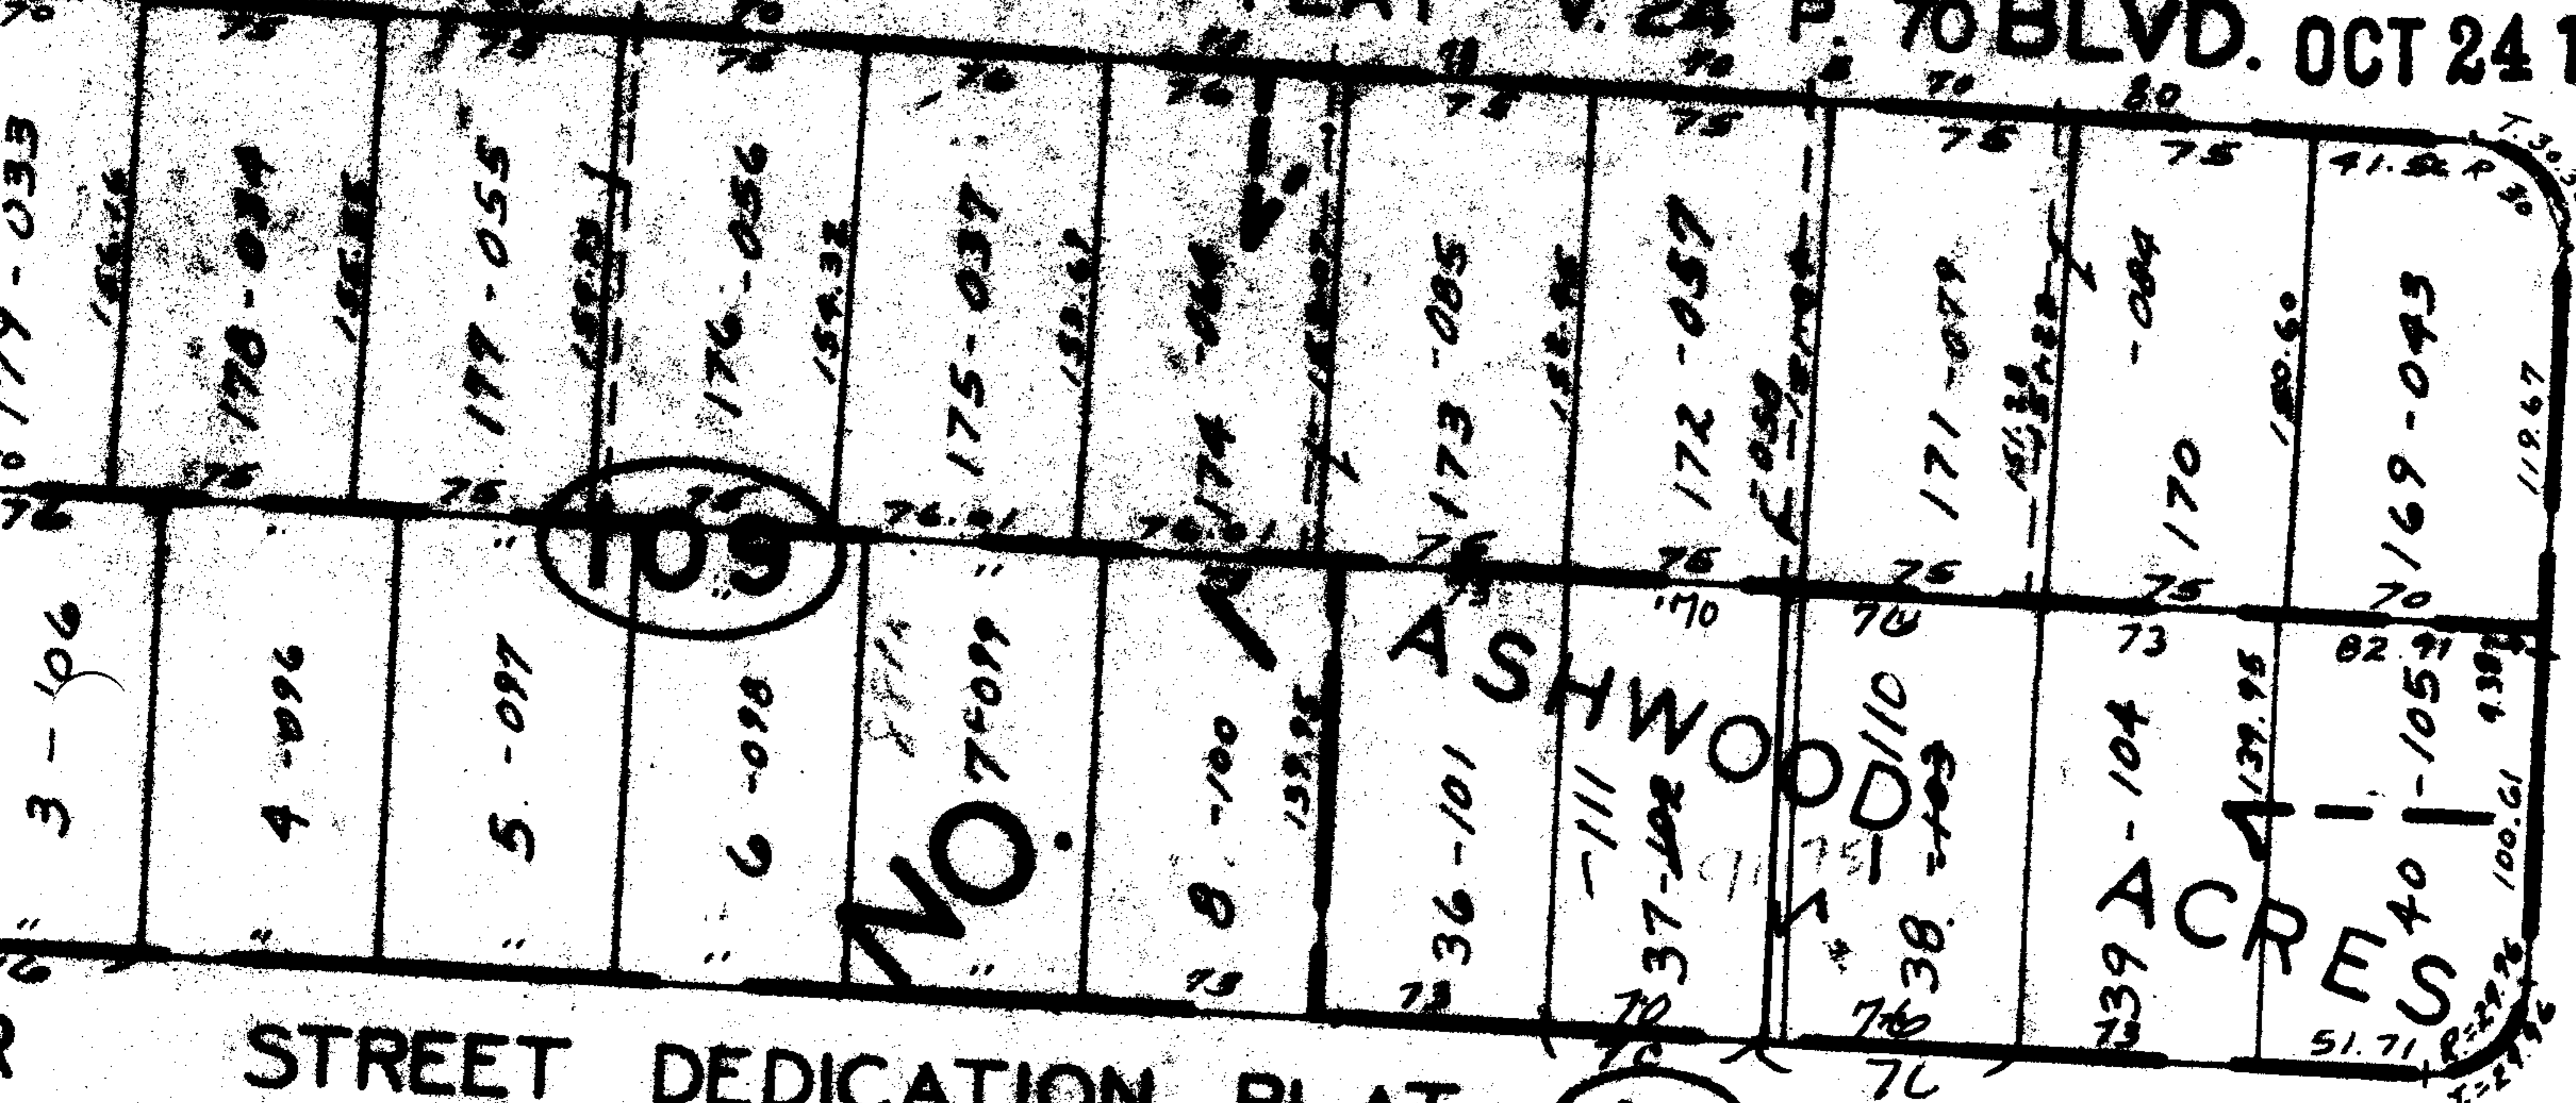

STREET DEDICATION PLAT

900

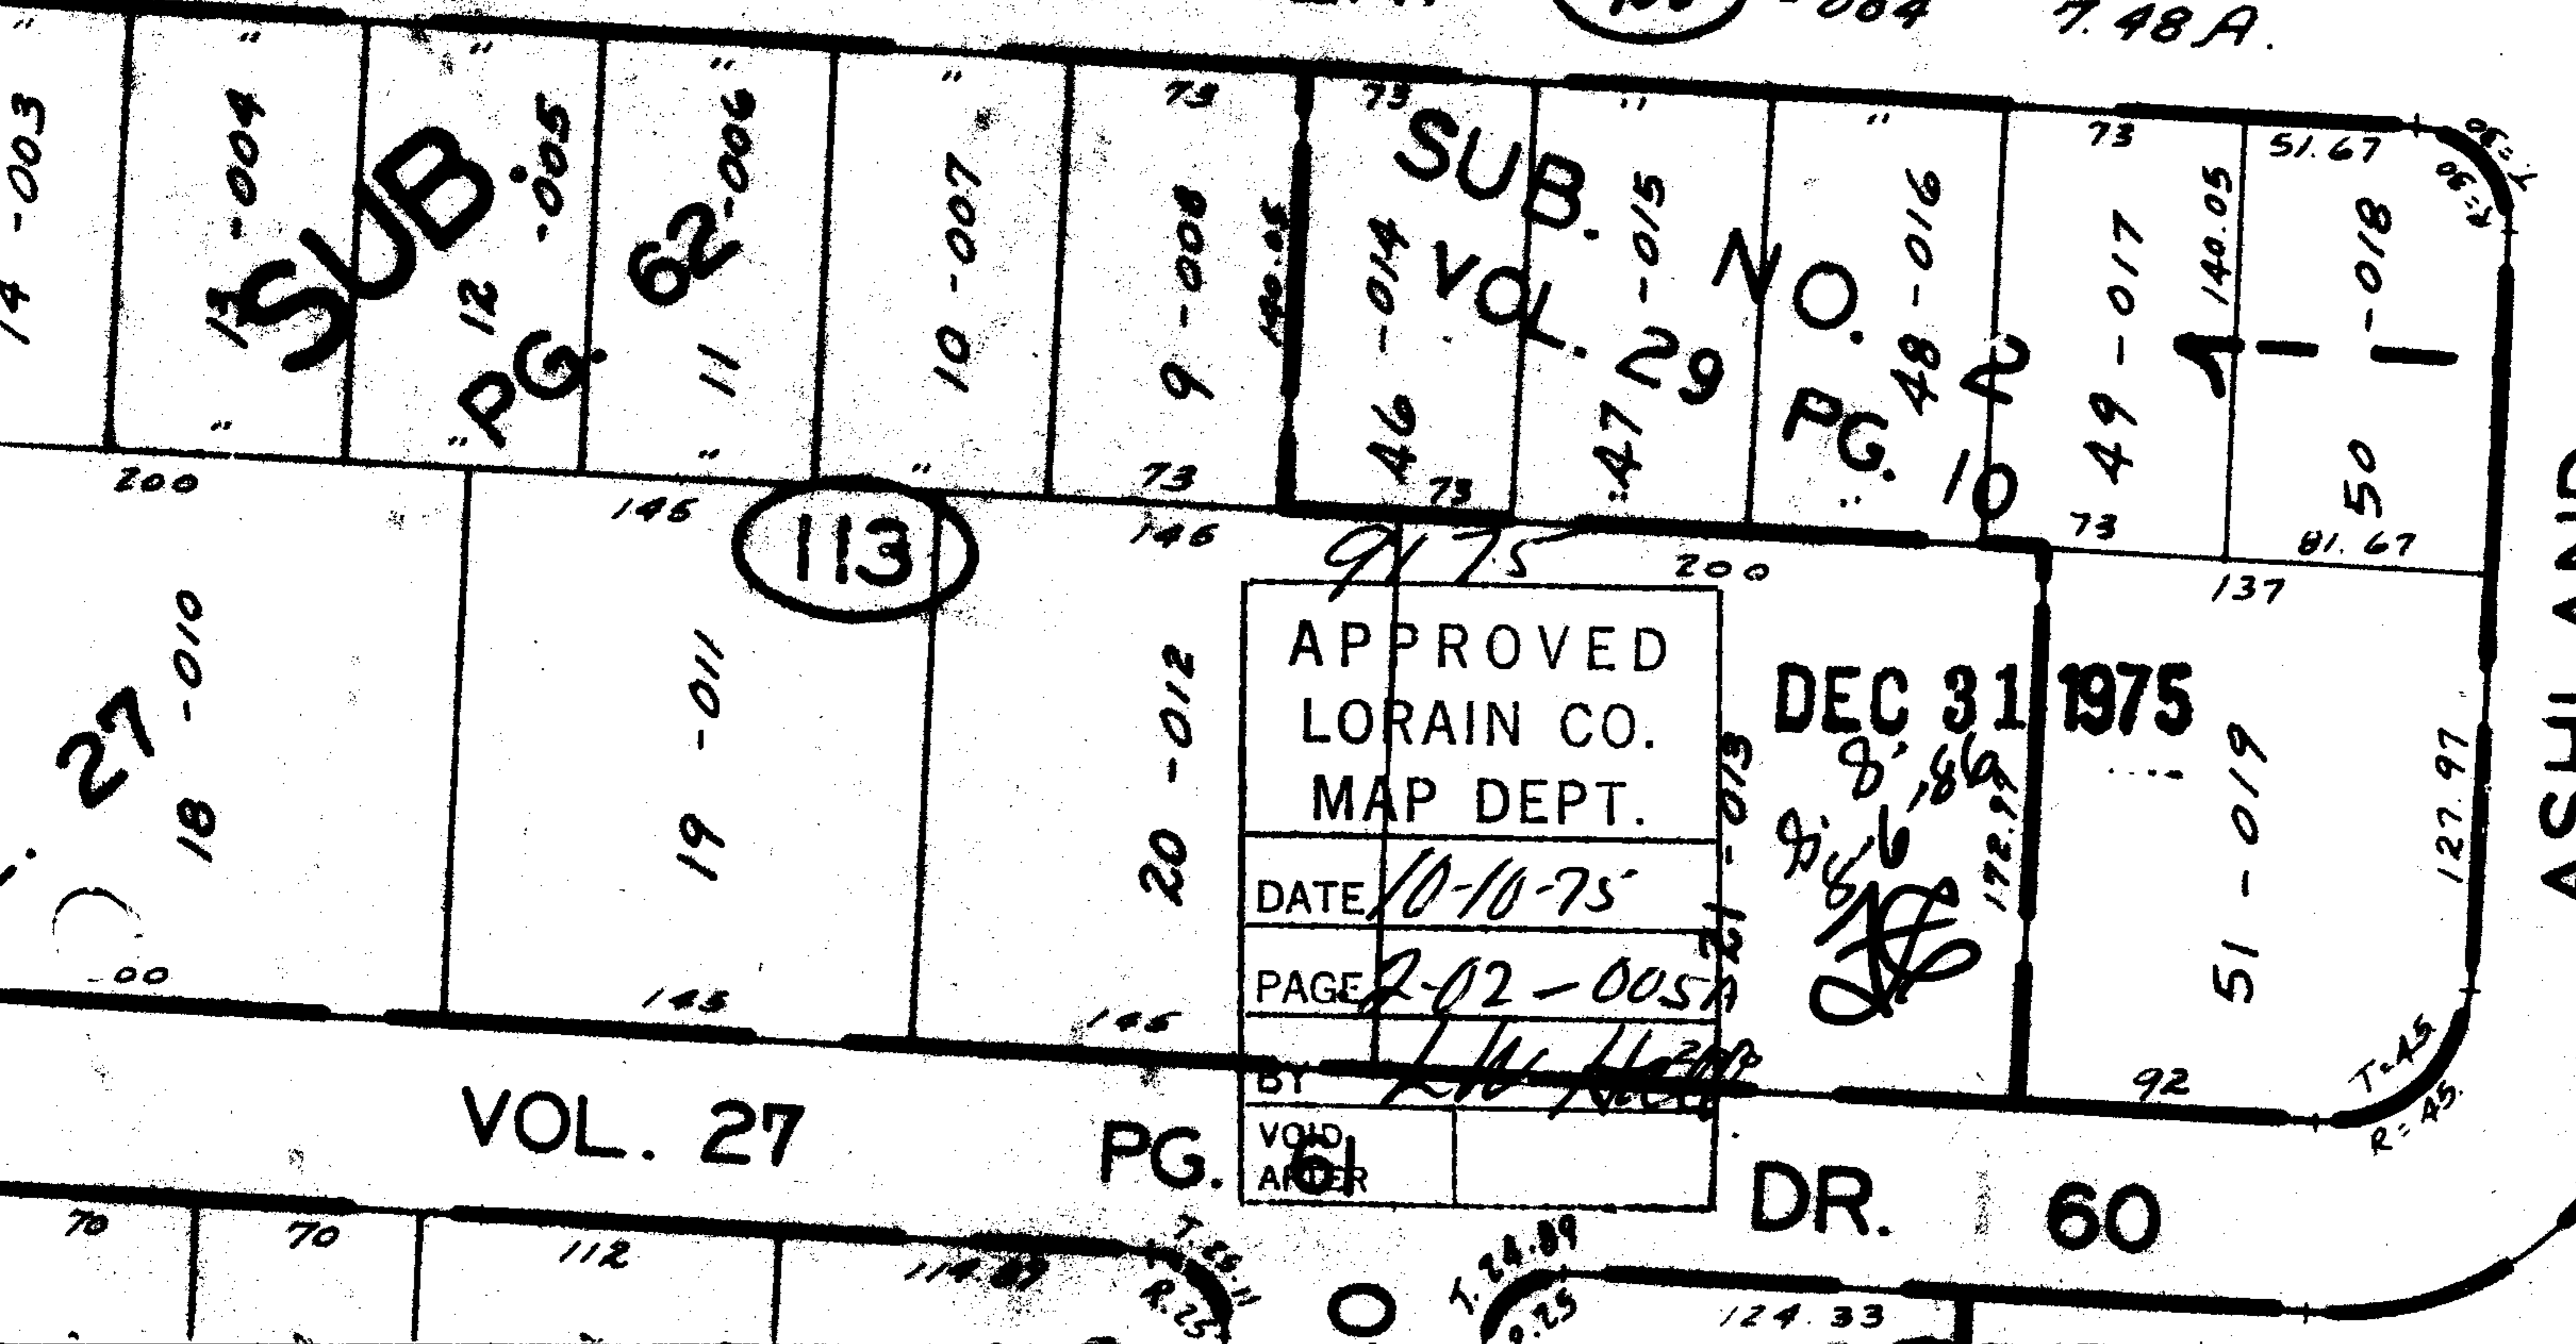

VOL. 27

PG. 61

DR. 60

APPROVED LORAIN CO. MAP DEPT.	
DATE	10-10-75
PAGE	2-02-005A
BY	[Signature]
VOID AFTER	

DEC 31 1975

ASHLAND