


9/86

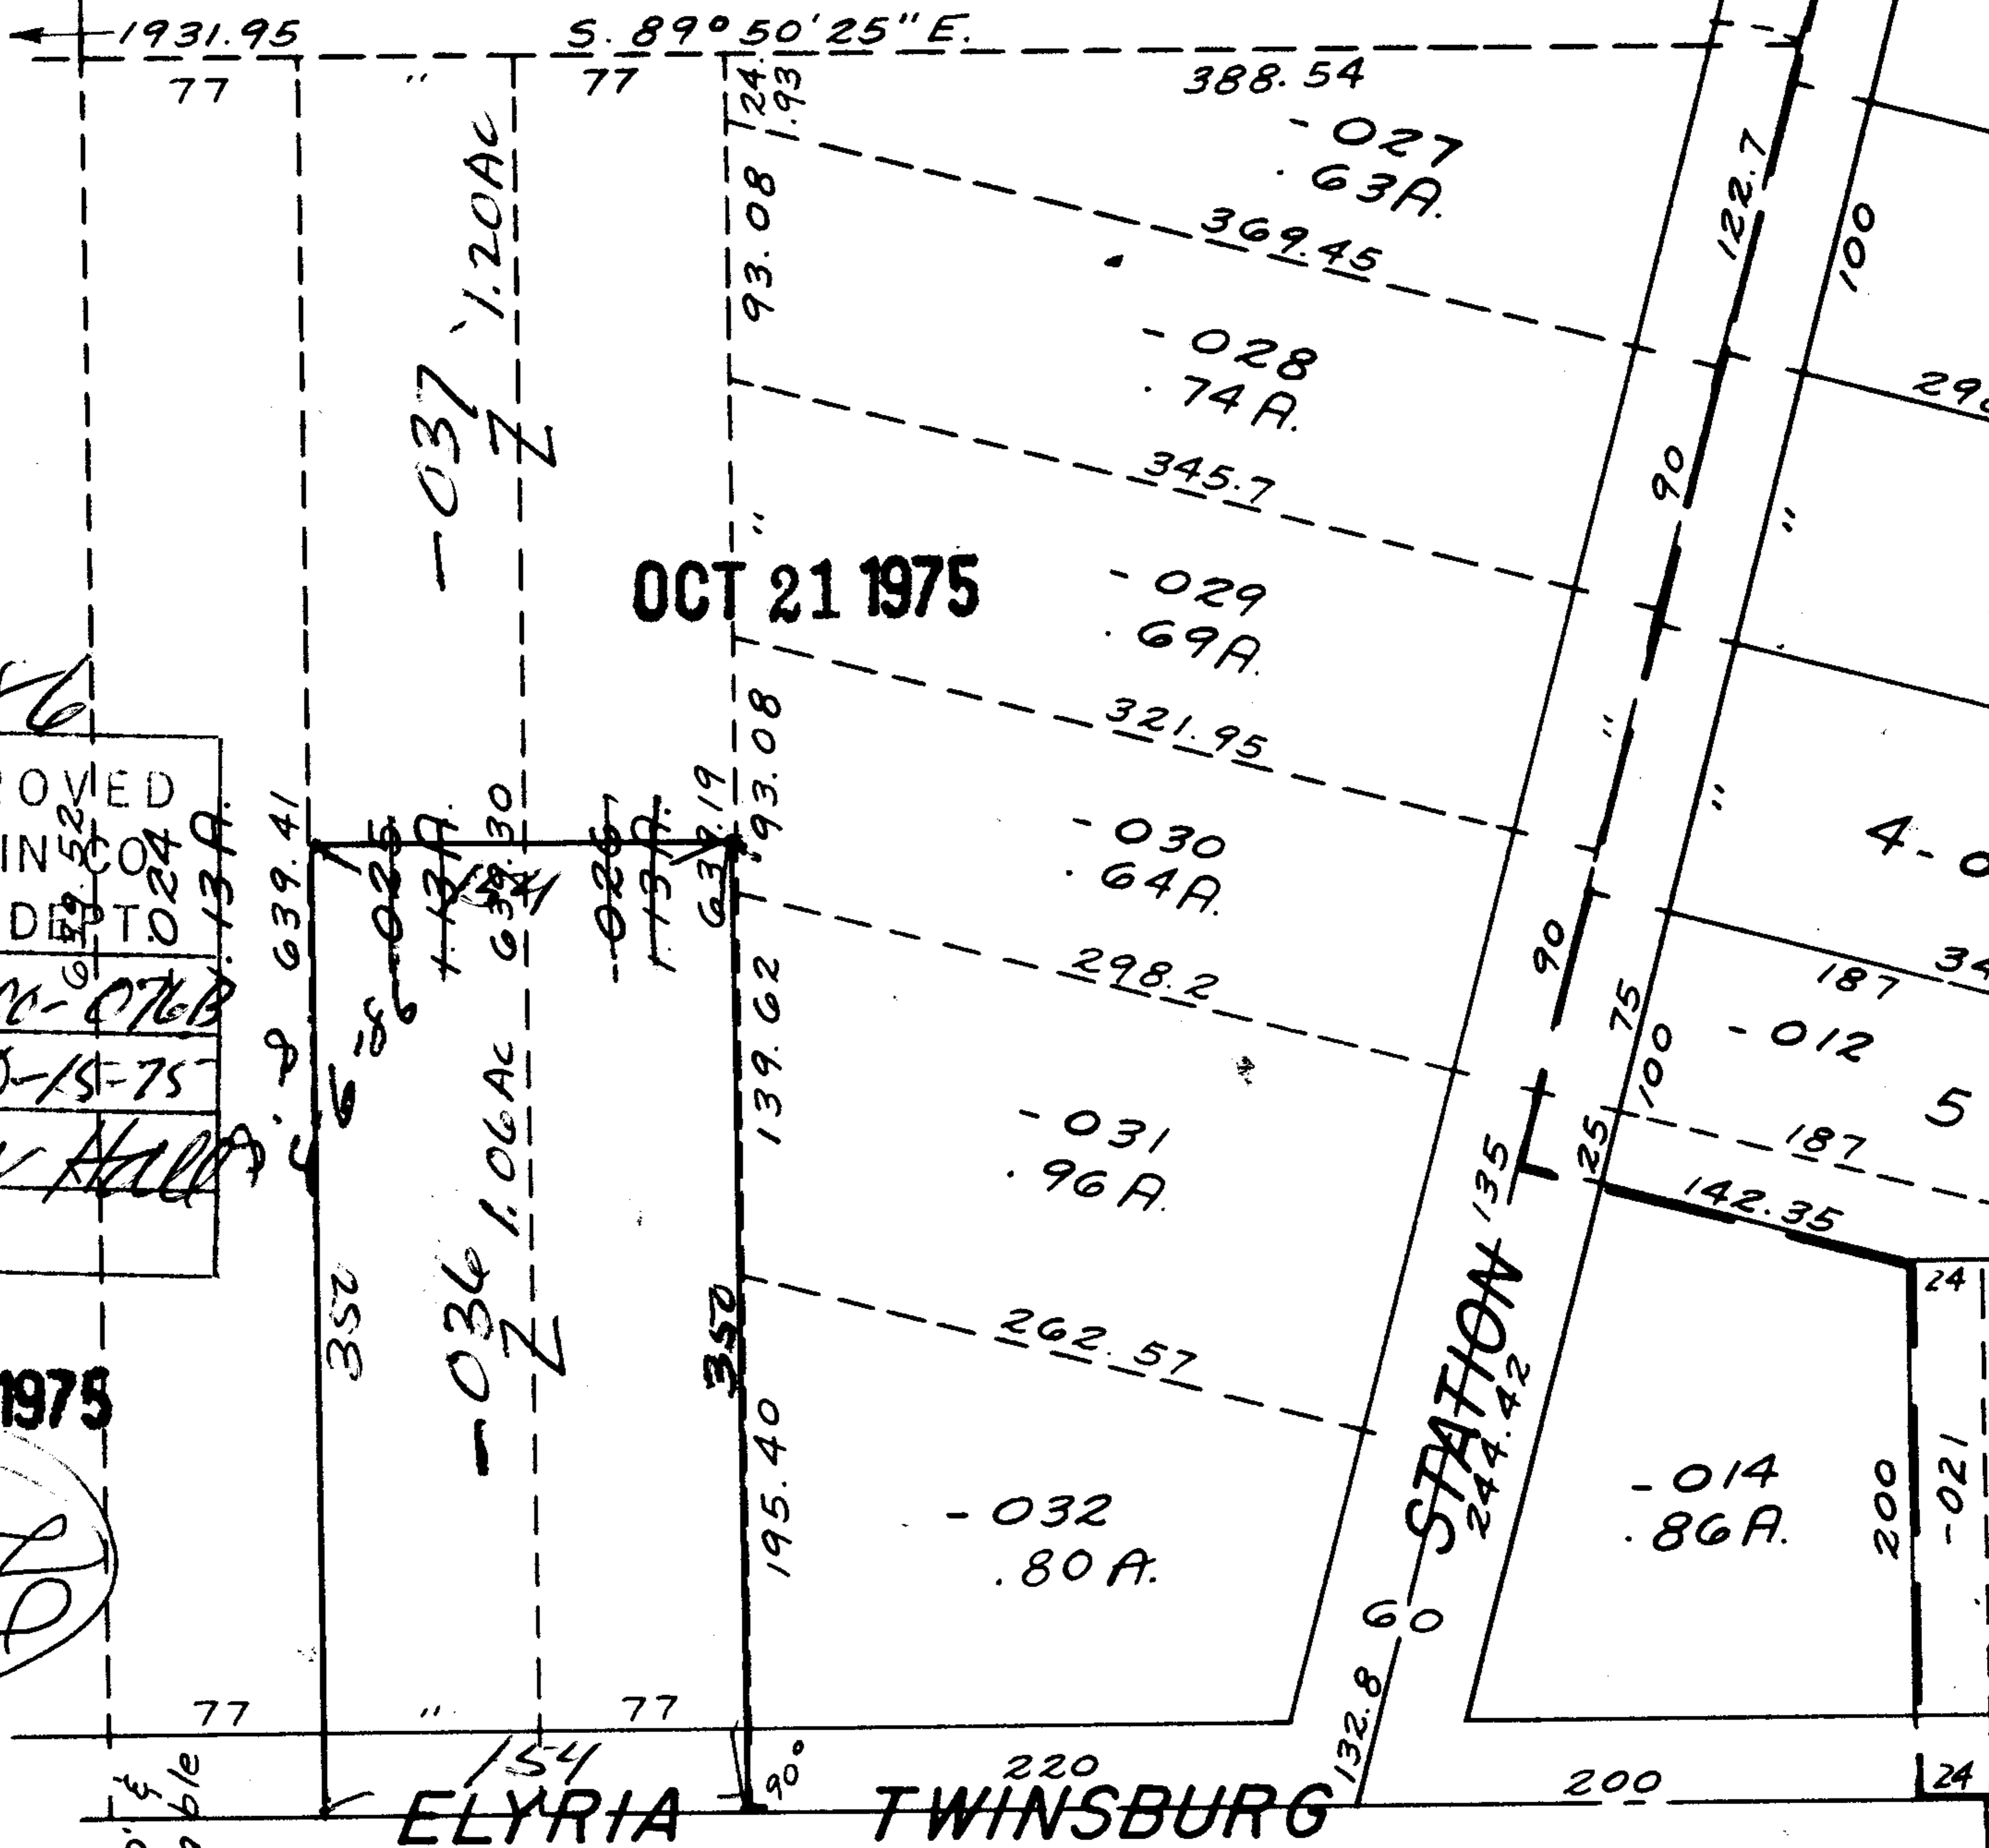

OCT 21 1975

9/86

APPROVED	
LORAIN CO	
MAP DEPT	
DATE	12-00-076B
PAGE	10-15-75
BY	LW Hall
VOID	
AFTER	

DEC 31 1975

COLUMBIA TWP.

SCALE: 1" = 100'

SEE 12-00-075-B