


OCT 20 1975

1200
1002.60

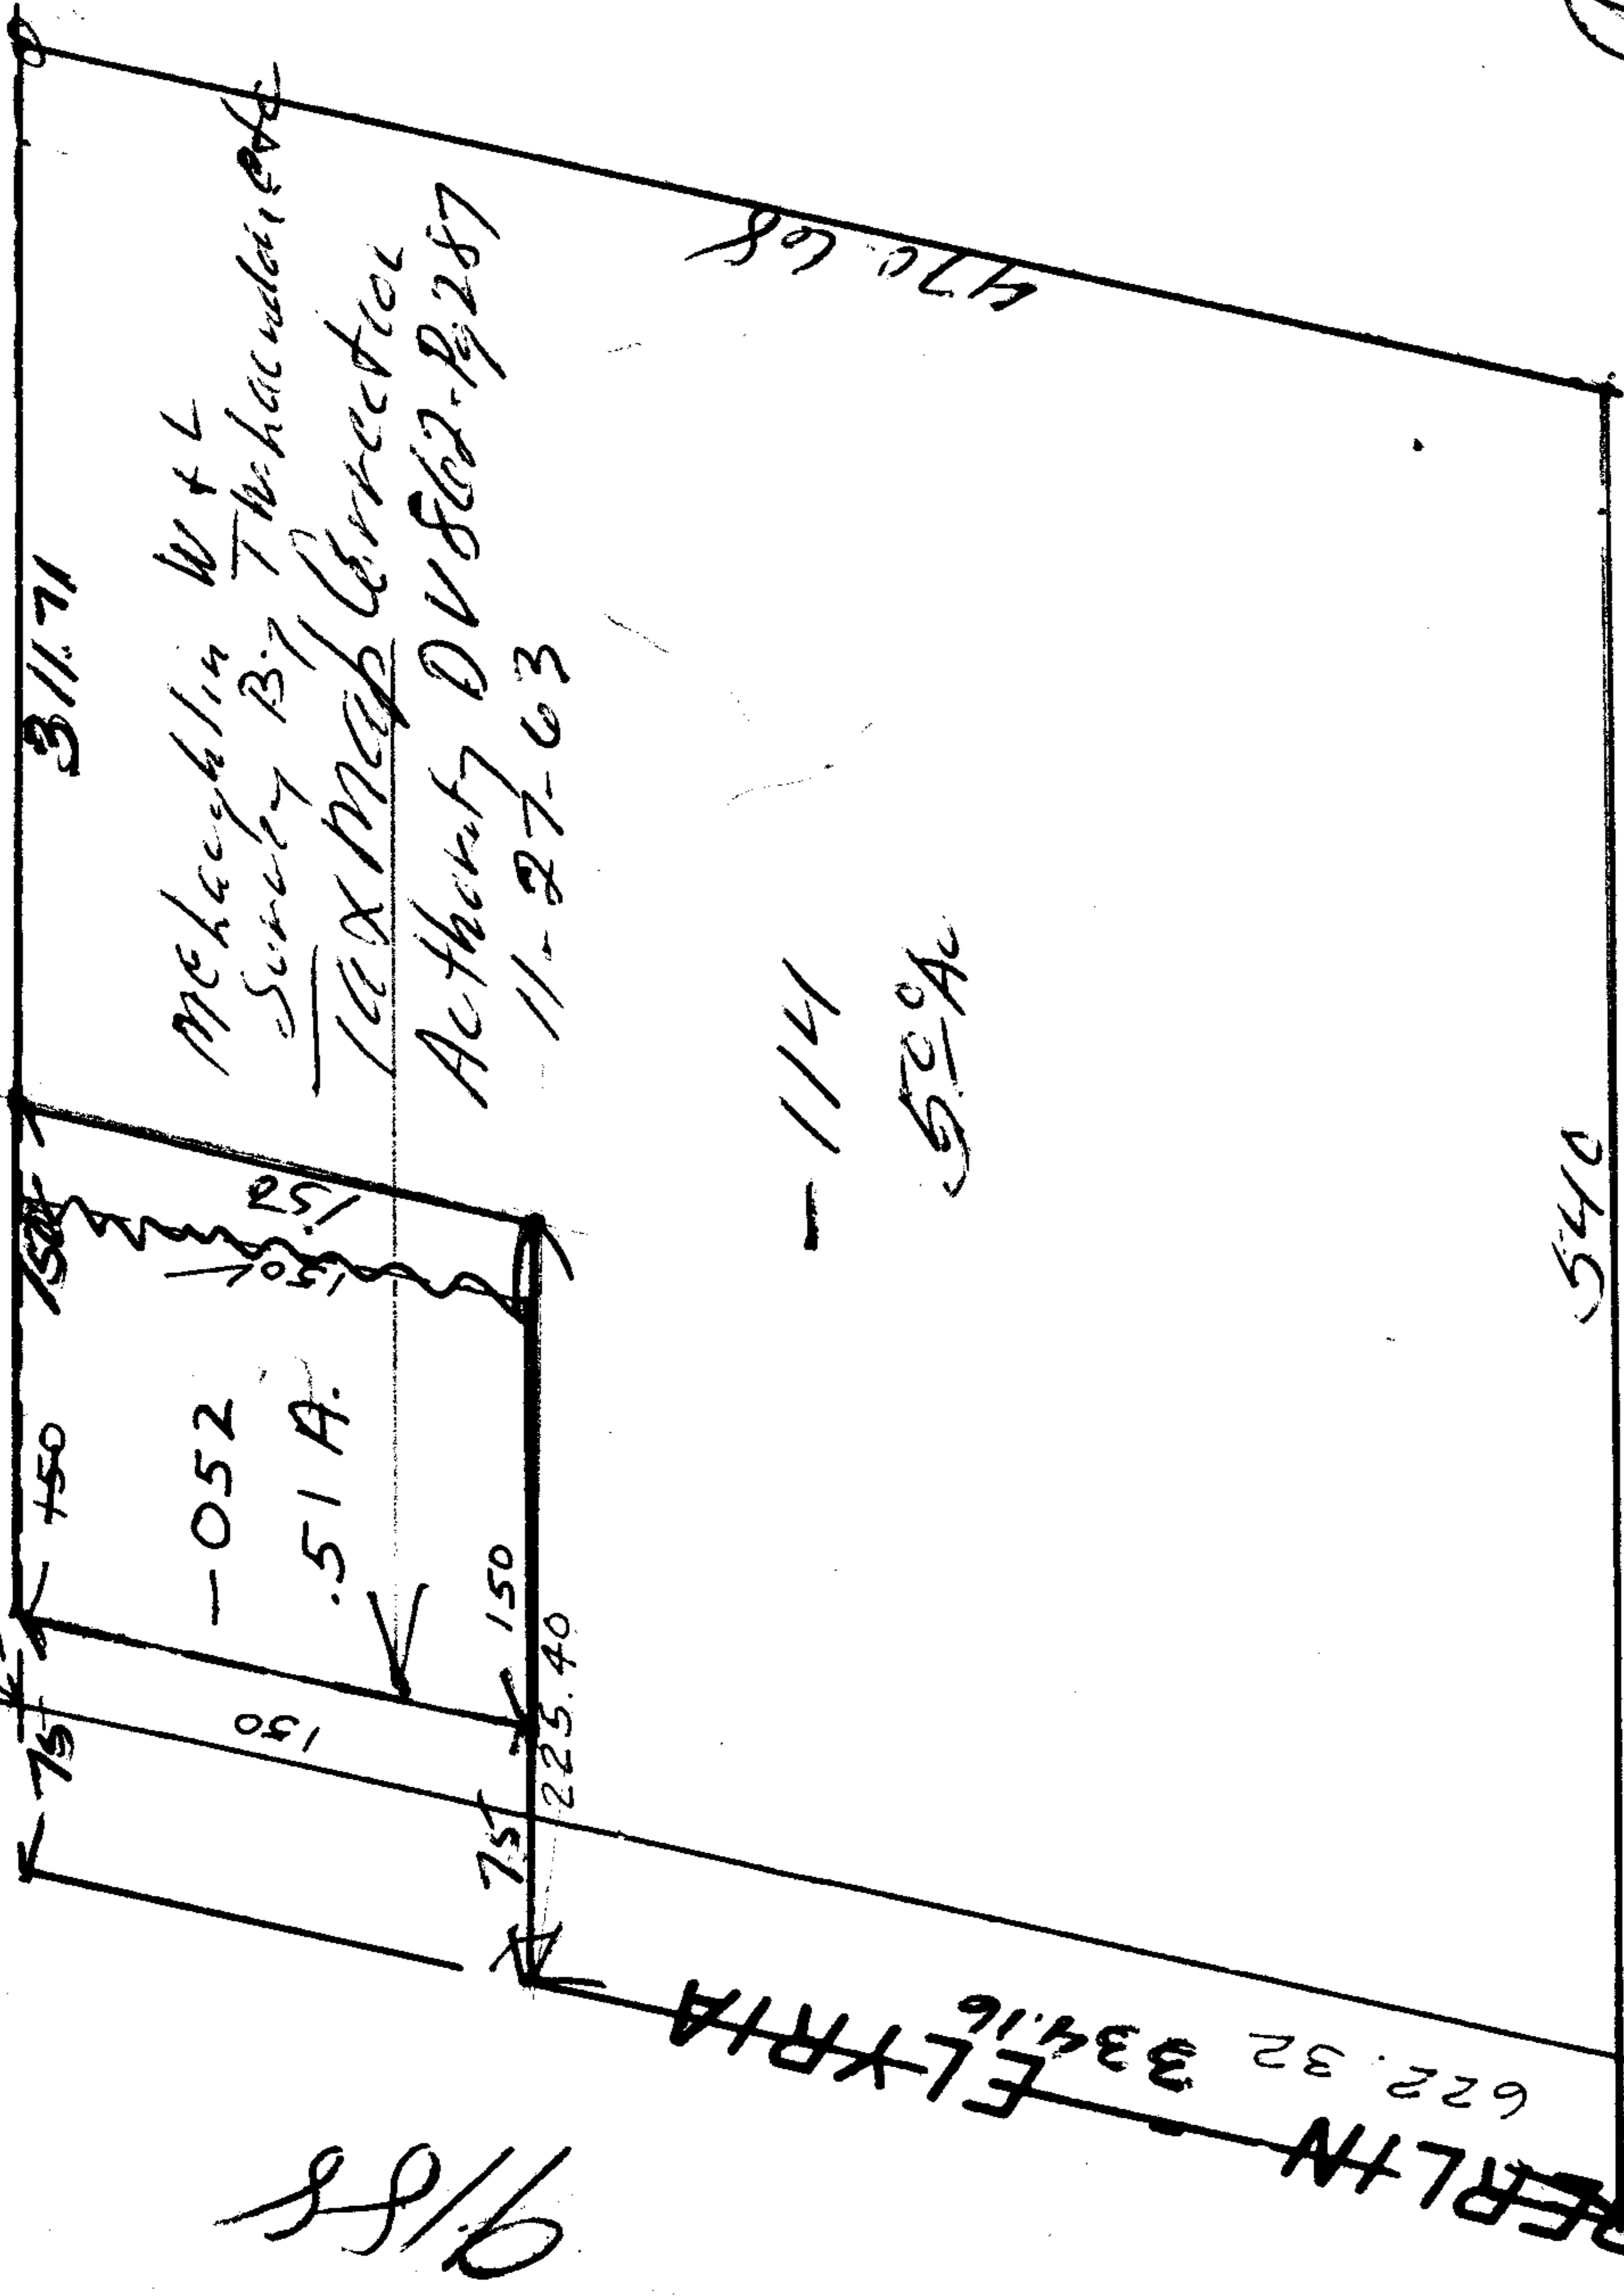

Mechanical W & L
Survey By Theodor
TEX Map Correction
Authority DV 562-P-287
11-27-63

OBERTLN 622.32 334.16
ELYRIA

9/88

- 114
55% Ac

- 115
Pt. ~~082~~
Pt. ~~1890 A.~~
1390

9/88

10-17-75

APPROVED
LORAIN CO.
MAP DEPT.
DEC 31 1975

APPROVED	
LORAIN CO.	
MAP DEPT.	
DATE	10-17-75
PAGE	10-00-012B
BY	LW
VOID AFTER	

8.8.
8-6-82

2085.0



1585

1450
CLEVELAND - OBERTLN

60

288

SEE 10-00-01