


9204

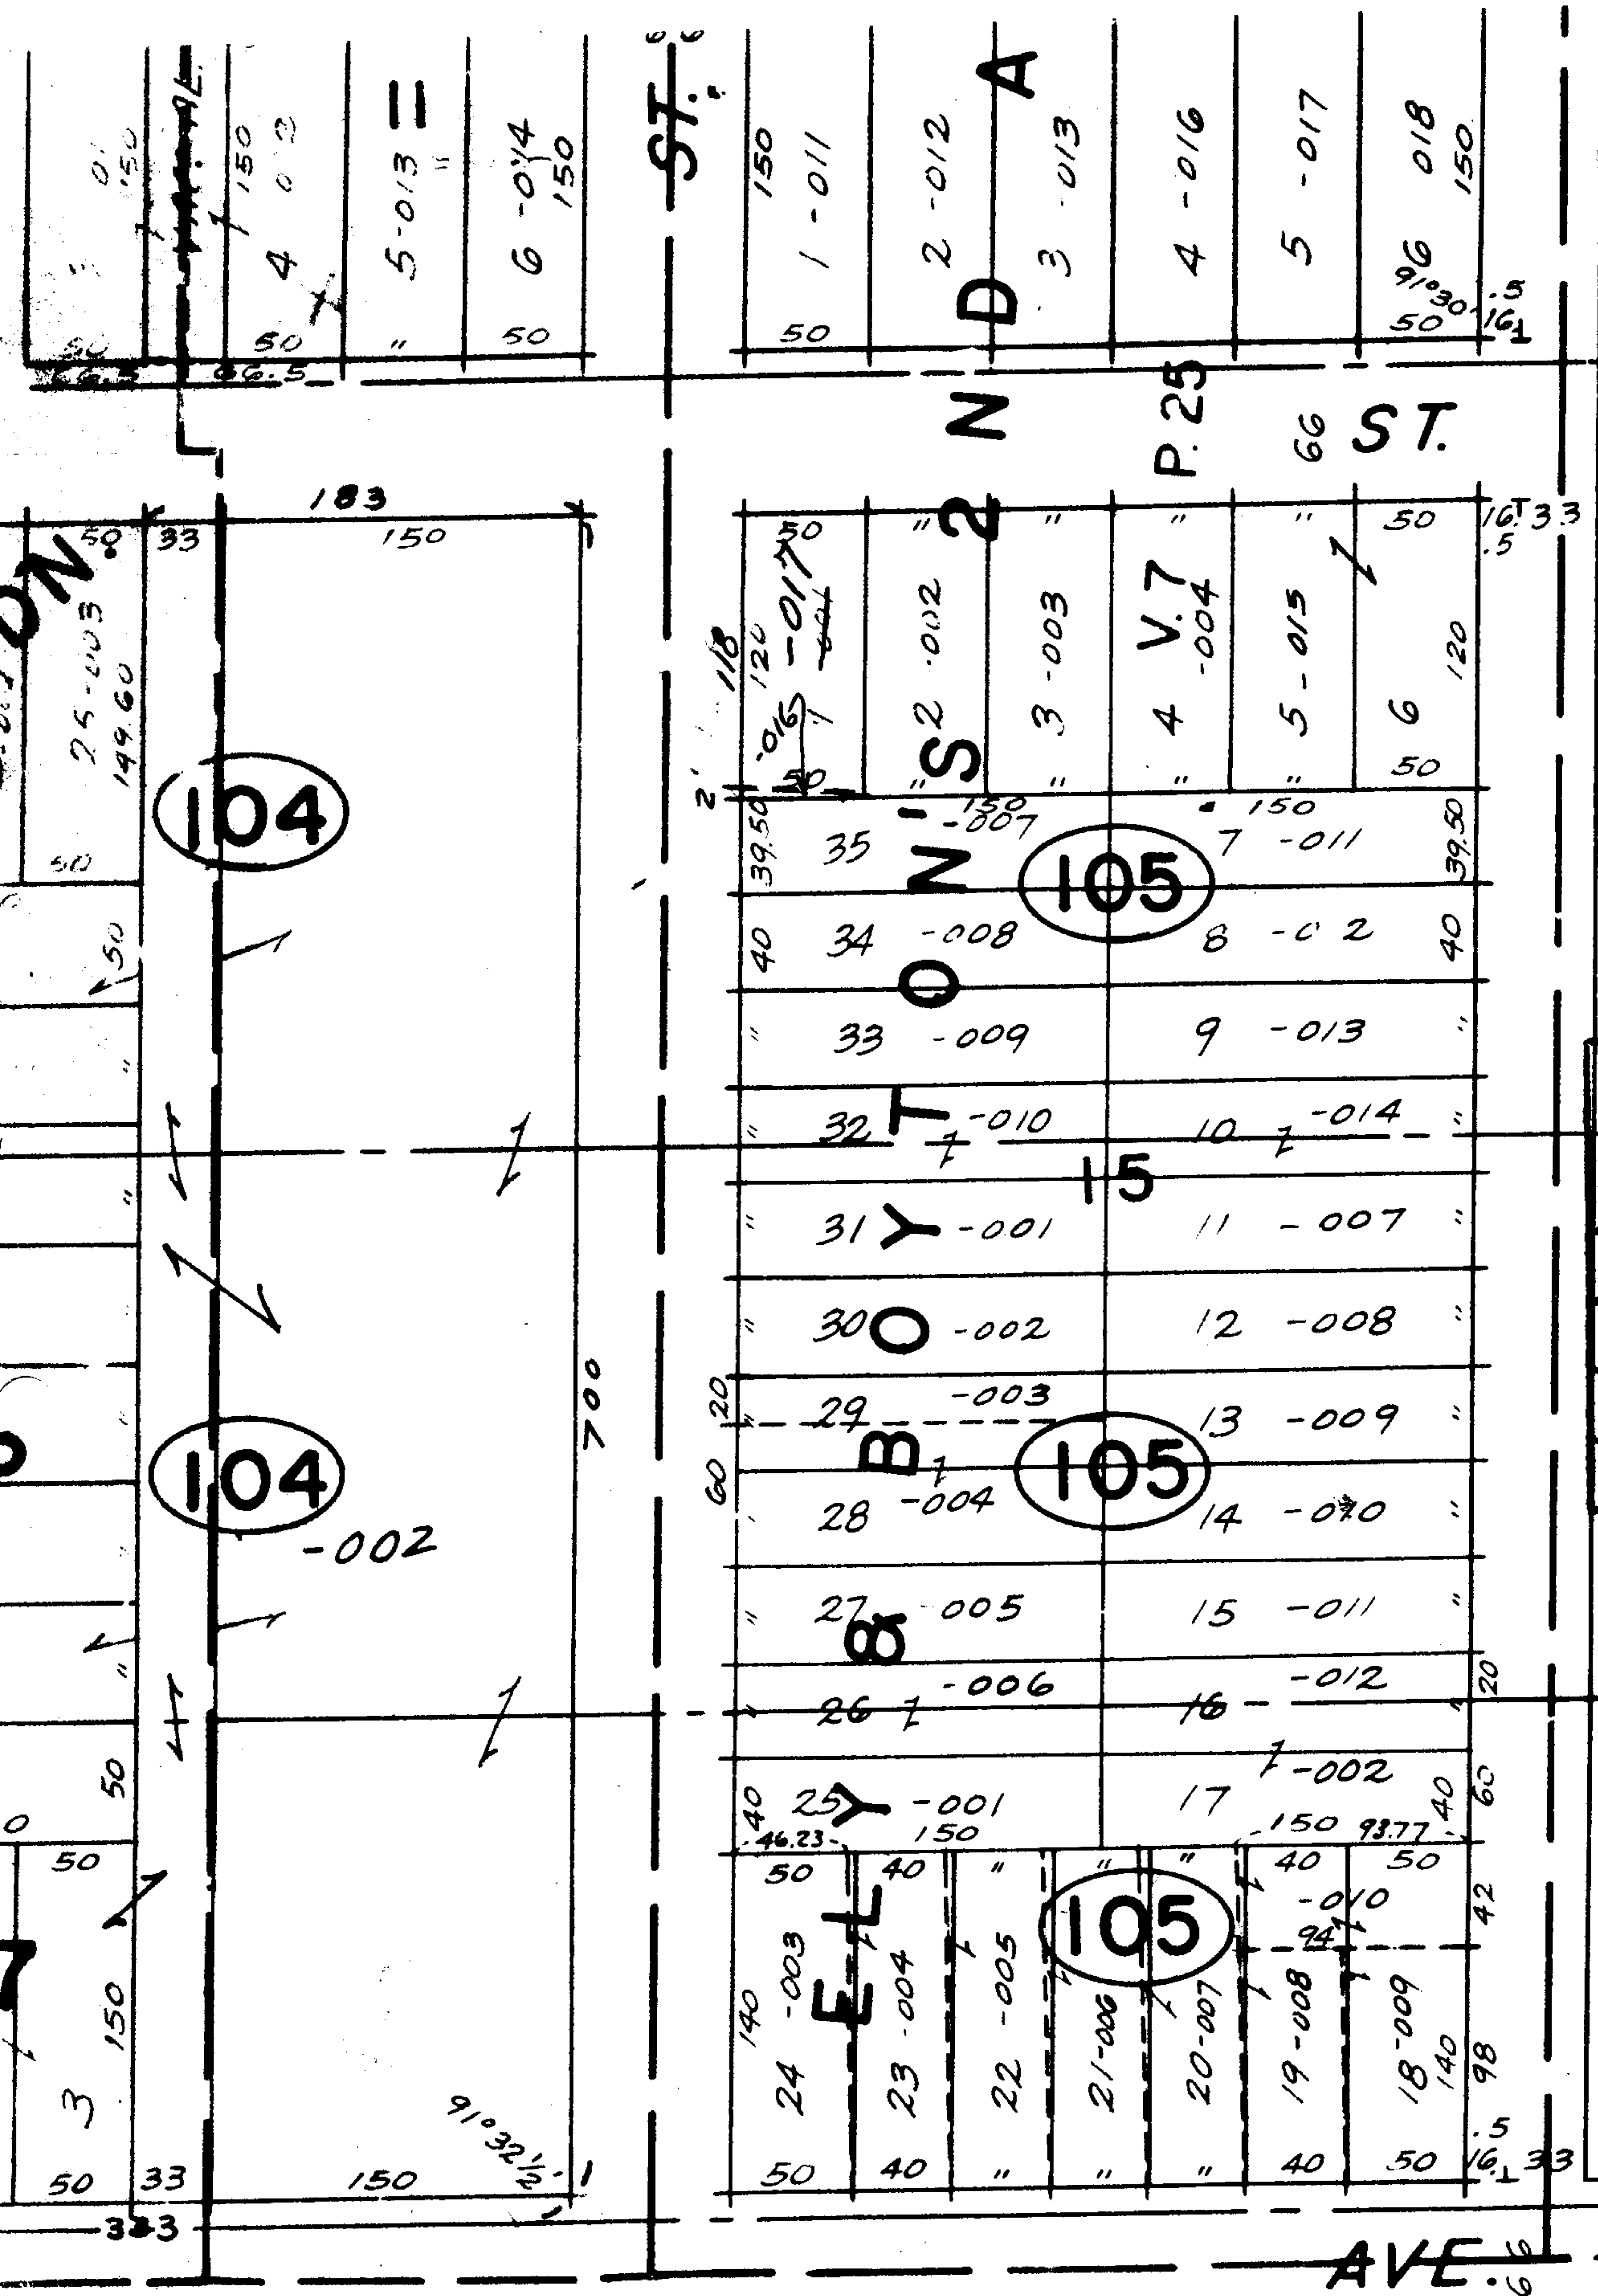

OCT 29 1975

9204

APPROVED  
LORAIN CO.  
MAP DEPT.


DATE 10-27-75

PAGE 6-81

BY *J. Collier*

VOID  
AFTER

DEC 1 1975

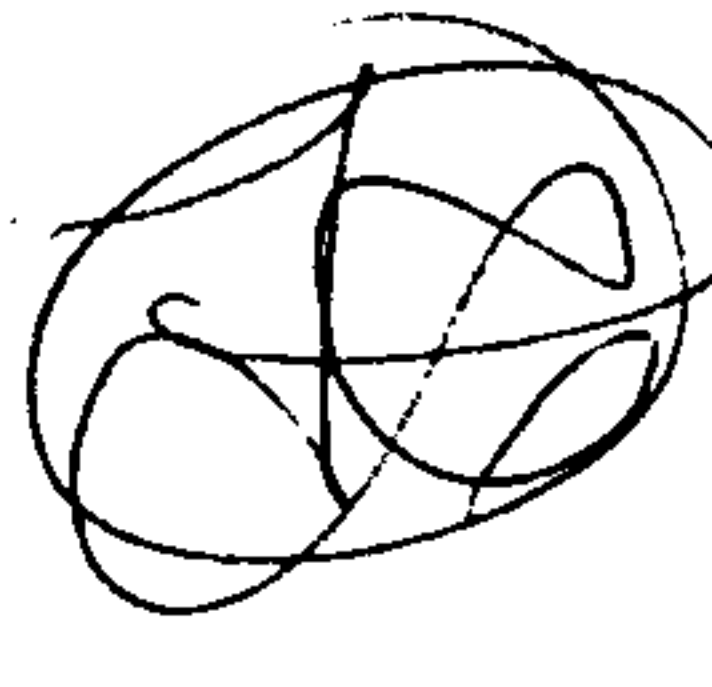

030	"	6	"	62-016	"
031	"	"	"	63-017	"
032	"	"	"	64-018	"
033	"	"	"	65-019	"
034	"	"	"	66-020	40
035	"	"	"	93.18	"

DISON 66

009	41.60	67-001	41.60
010	"	68-002	"
011	"	69-003	"
012	"	70-004	"
013	"	71-005	"
014	"	72-006	"
015	"	73-007	"
016	41.60	74-008	41.60
		92.80	

66