



9240

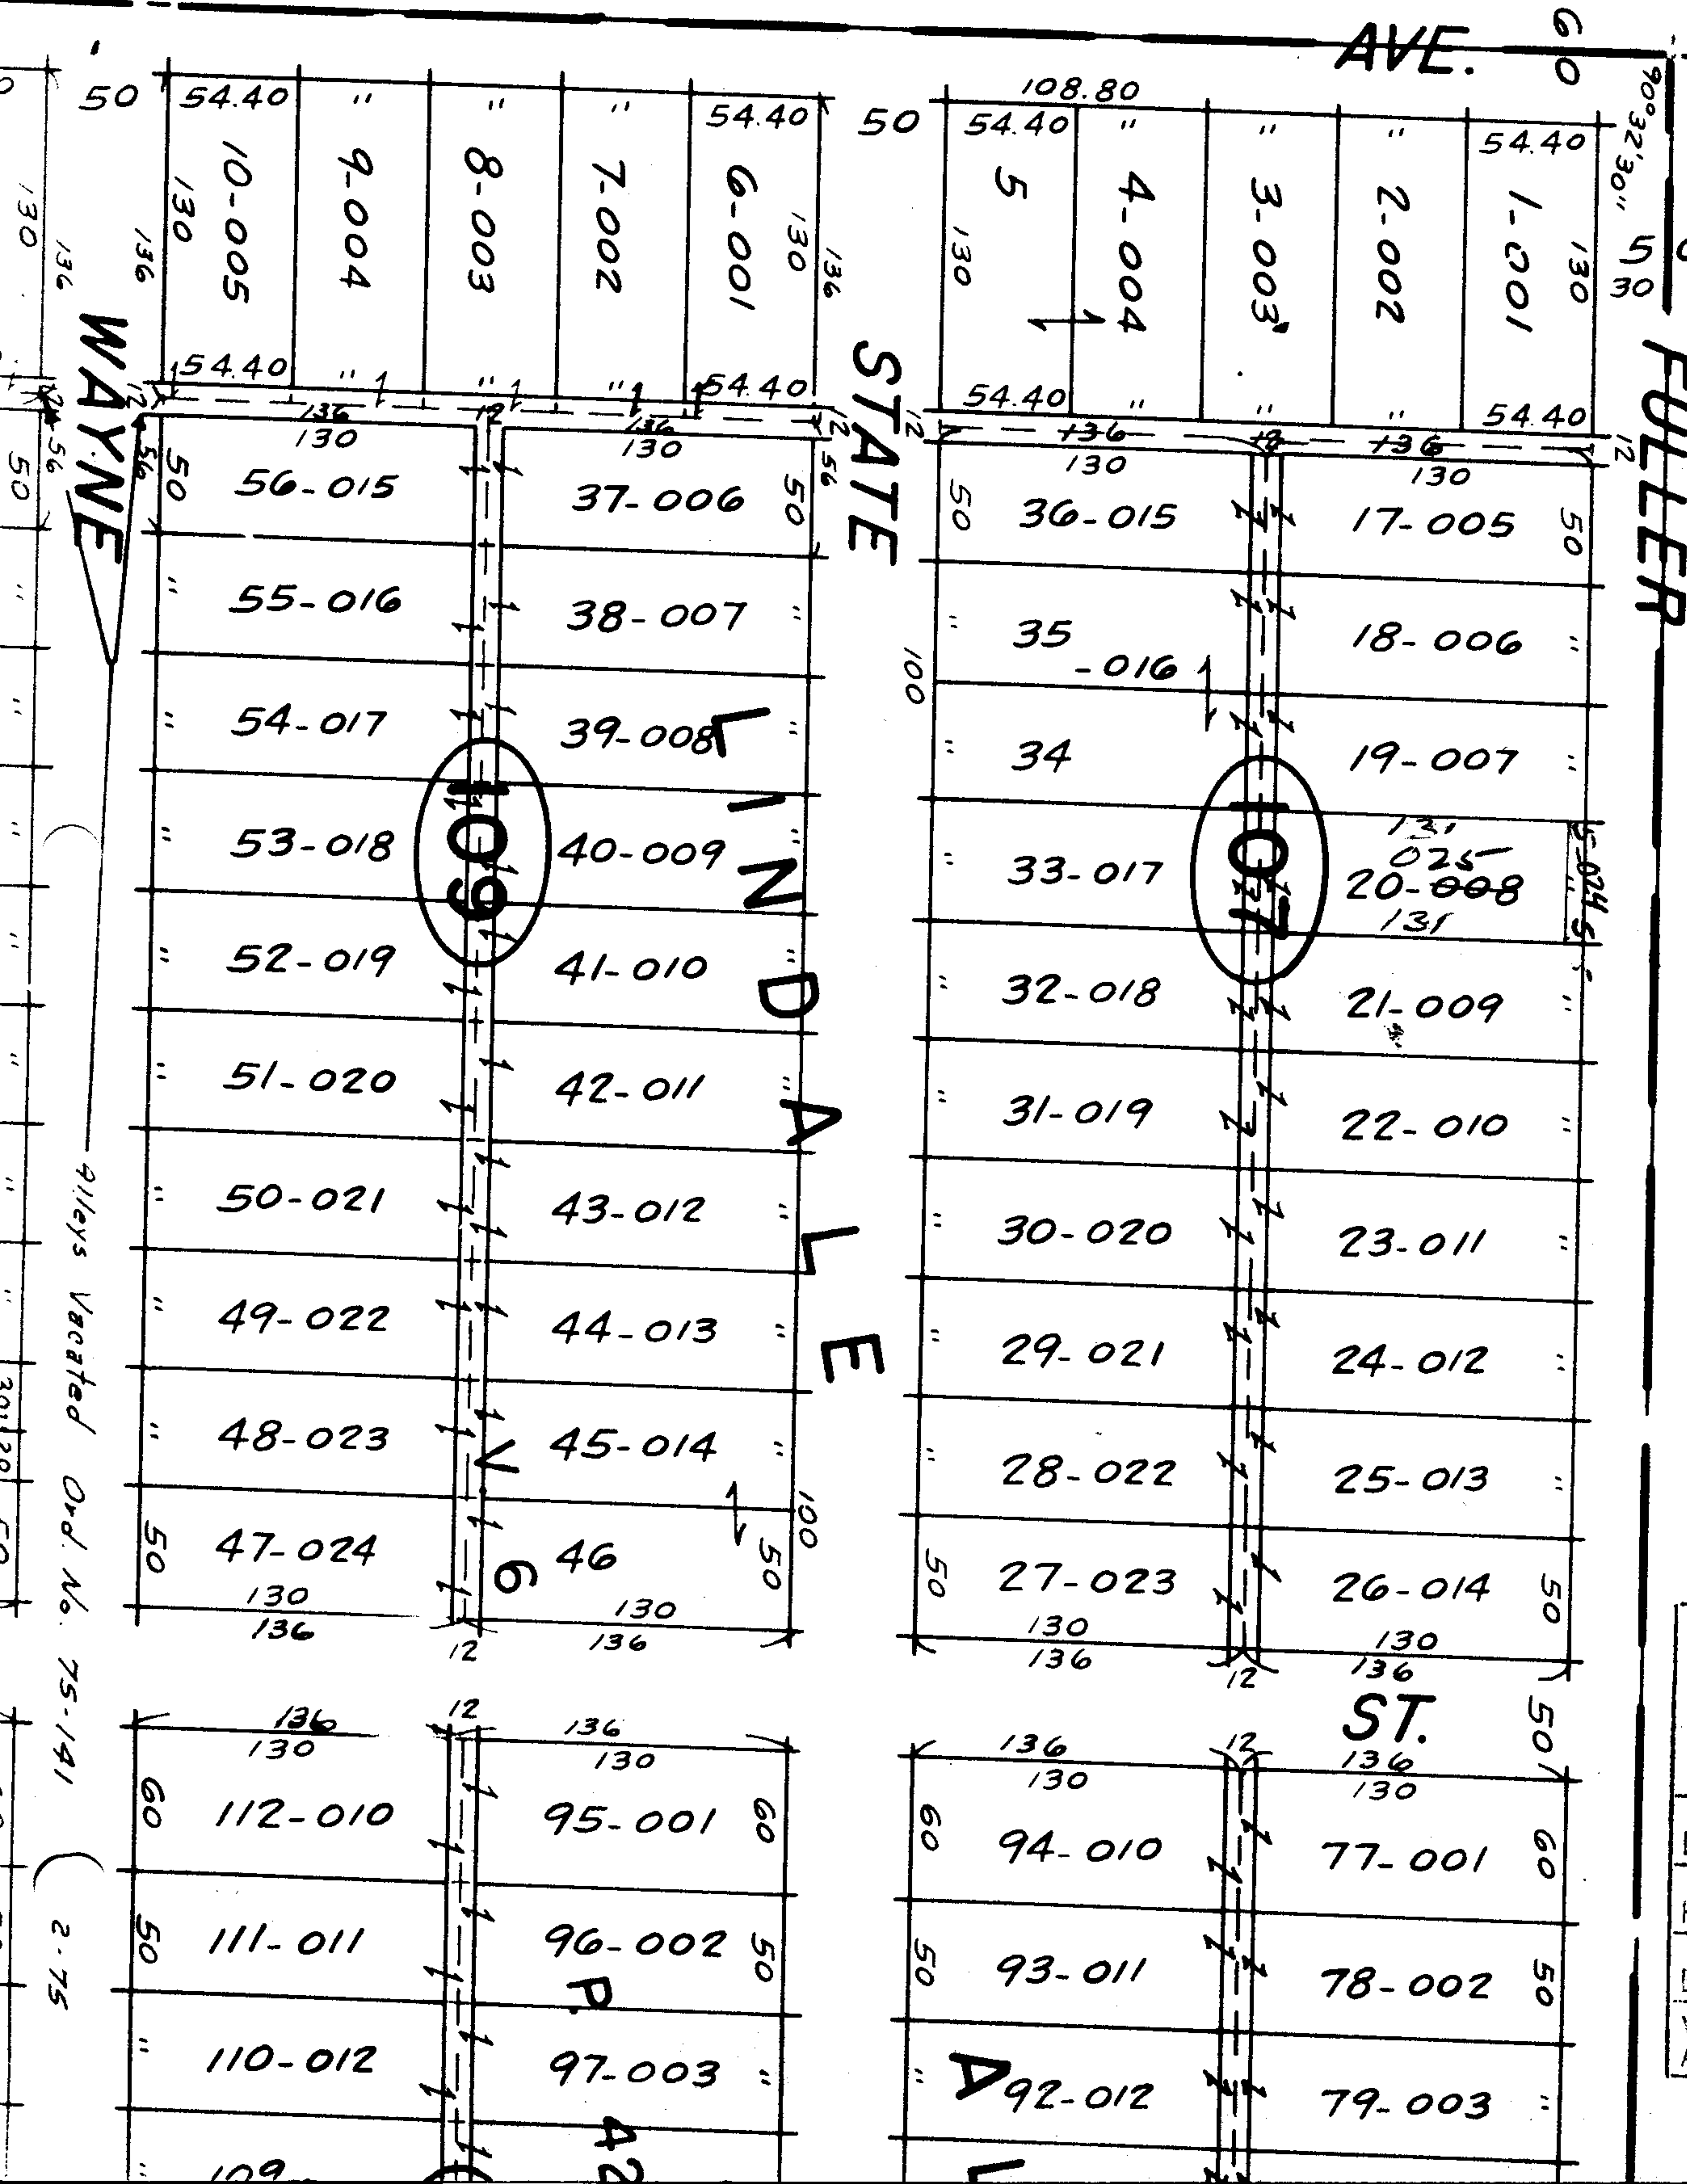

NOV 18 1975
 DEC 31 1975

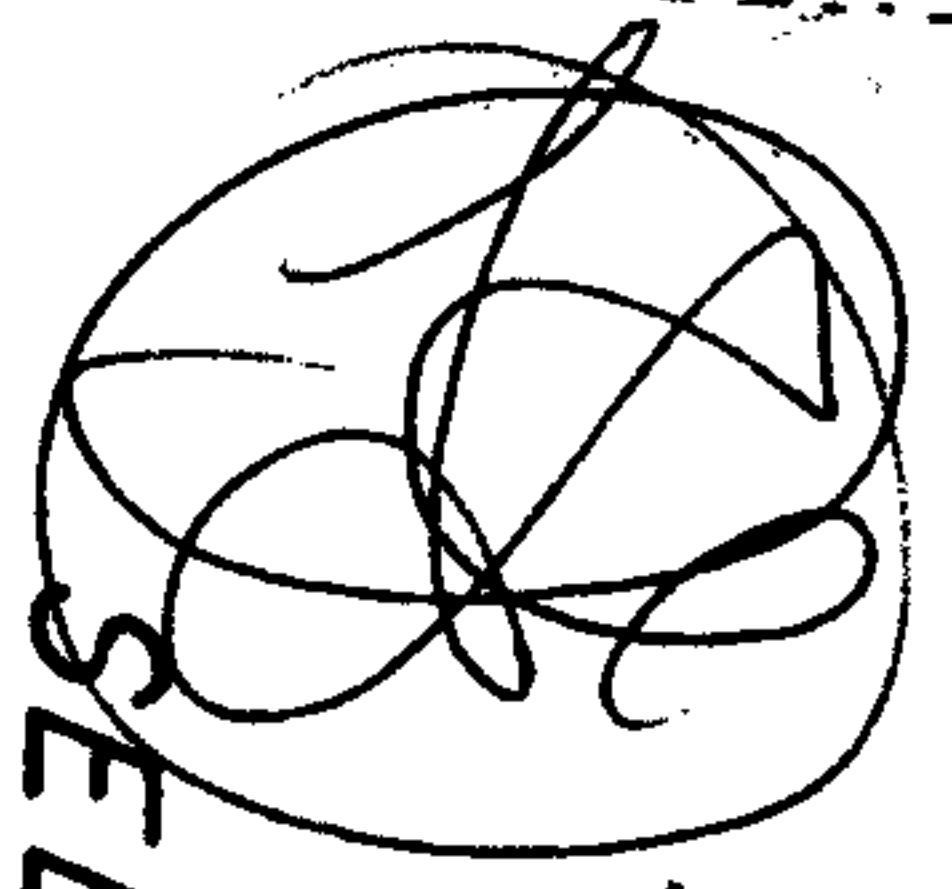

SEE 10-00-004
 9240

APPROVED	
DRAIN CO.	
MAP DEPT.	
DATE	11-13-75
PAGE	10-00-004
BY	LW Hall
VOID AFTER	

911eys Vacated Ord. No. 75-141

2.75