

SEE 6-142

~~1745.92~~

~~033~~

1.26 Ac. 1 to 599 Ac.

101

0.33 Ac. RD.

40

NOV 13 1975

-102
~~-088~~
2.95
2.62 Ac.


~~-033~~
~~-001~~
~~-007~~
~~20-26A~~
19.36 Ac.
18.10 Ac.

PI 795+25.21
A 340.35'-45"
D 1°-30'
T 1189.56
L 2306.39
E 180.94

383
377.13

797+03.50
108

800+00
108.5

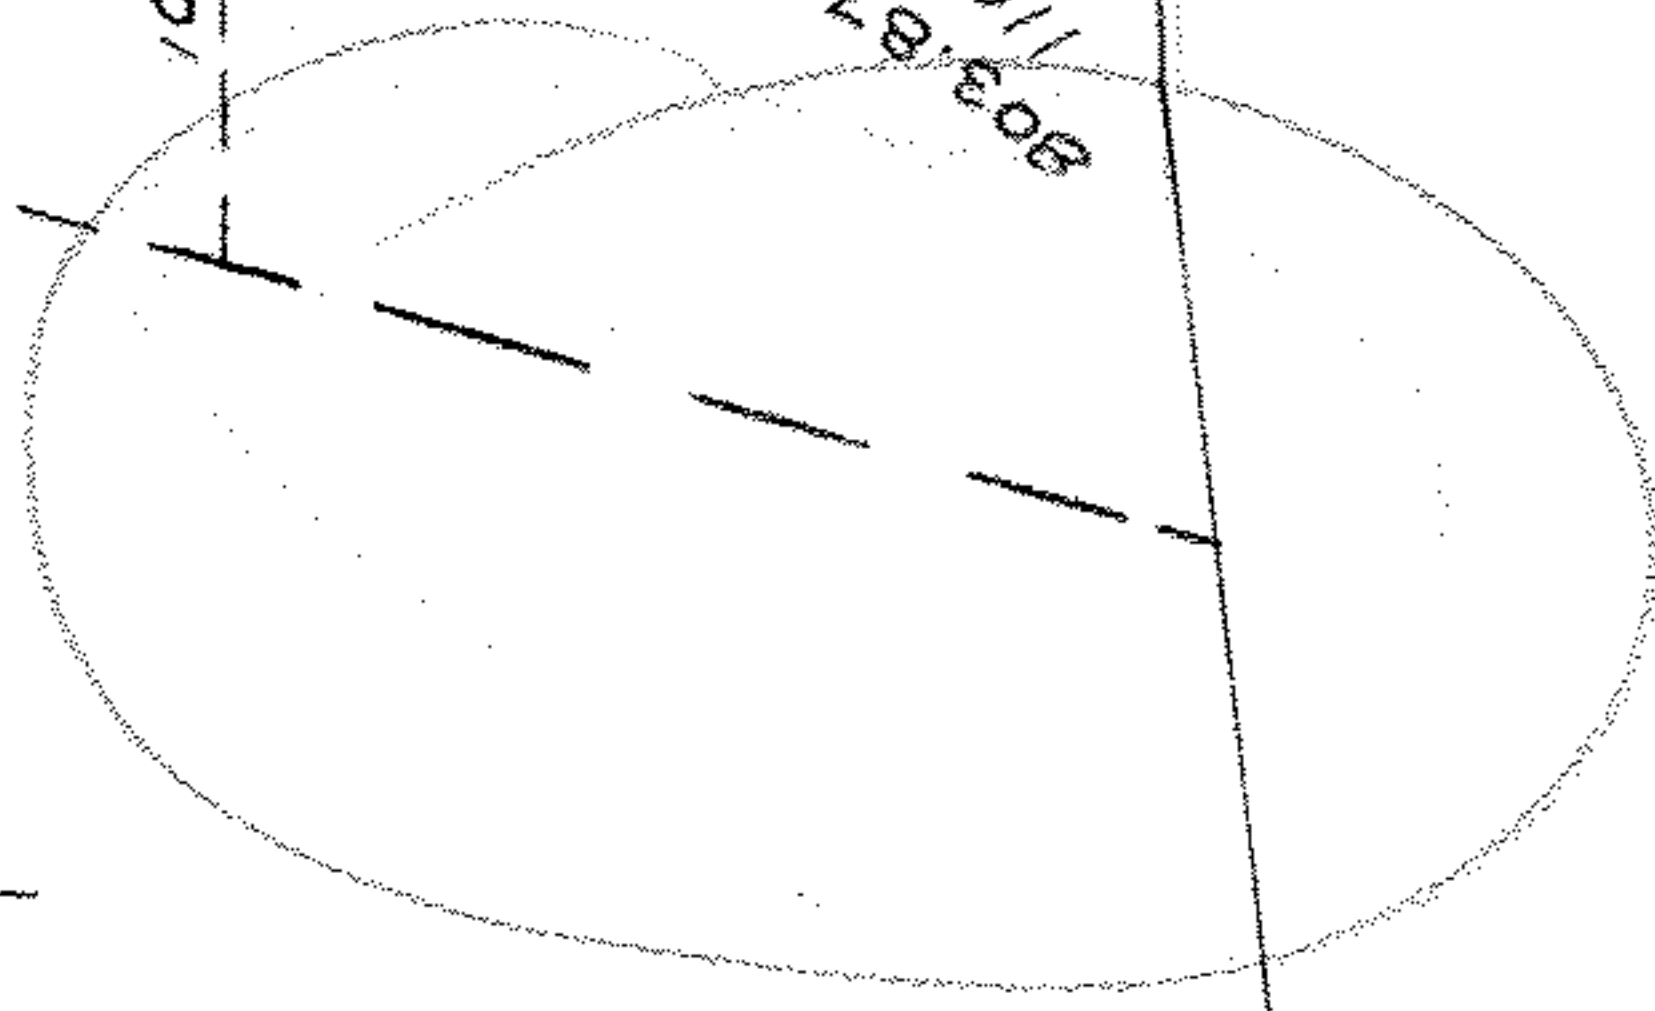

7

SOUTHEAST

9245

APPROVED LORAIN CO. MAP DEPT.	
DATE 11-12-75	
PAGE 6-143	
BY <i>J. Ballant</i>	
VOID AFTER	



DEC 1 1975

3-19-75

192+54
110
1296

-005 .24A

17 40

17