

9262

SE

3.00A.

43

2.09

26°05'

550.09

NOV 18 1975

-026

~~-021~~

~~36.49A.~~

36.26 Ac

224.6
-006
.41A.
224.6

224.63
-008
.41A.

125
-007
.41A.
224.63
-025 23AC
125

224.63
-009
.36A.

-010
.36A.
224.63

-011 1.00A.

544.63

1244.57


8,087

4.0

25-9-38
9262.8.7

| | |
|------------|------------|
| APPROVED | |
| LORAIN CO. | |
| MAP DEPT. | |
| DATE | 11-17-75 |
| PAGE | 11-00-080A |
| BY | L. R. Hall |
| VOID AFTER | |

DEC 31 1975

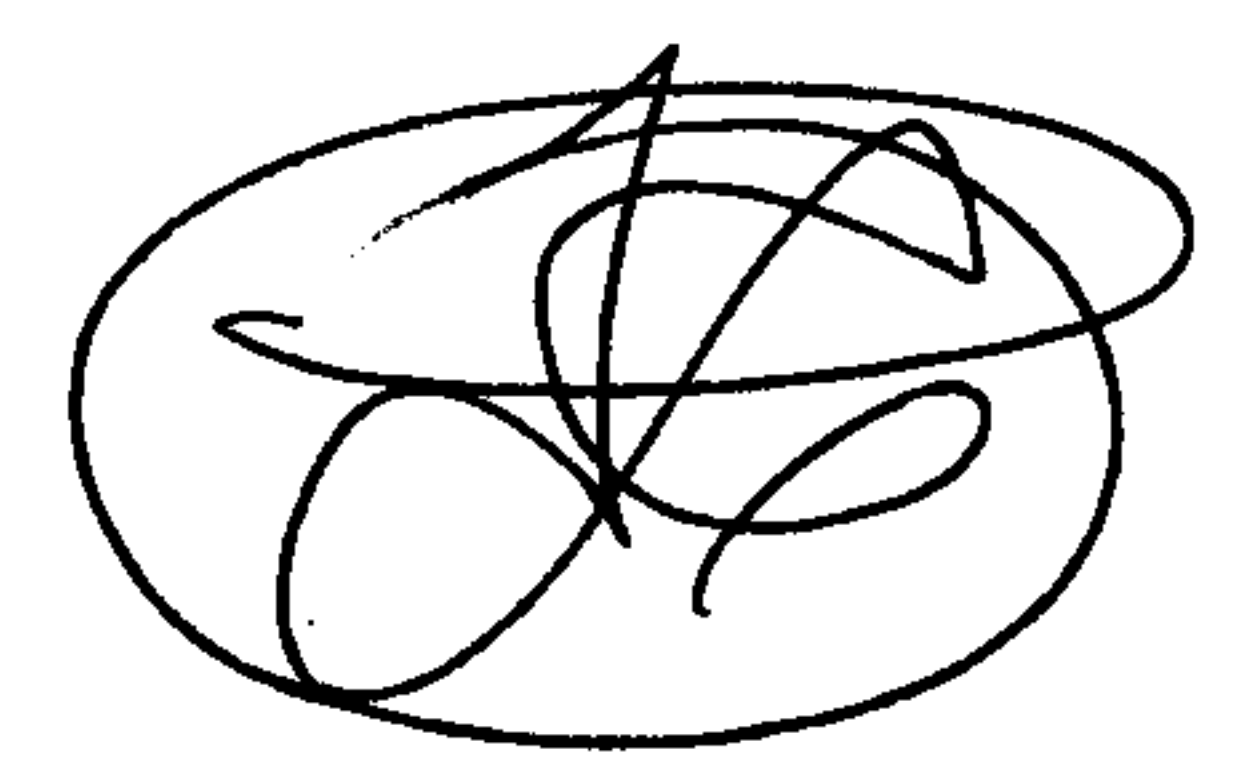

1254.8.
115 1153

375

80

80

80

70

70

80

30

80

80

80

70

70

80