


9278

7.74 A.

276.92

1936.

~~008~~ 030  
~~9.11A.~~ 9.03Ac

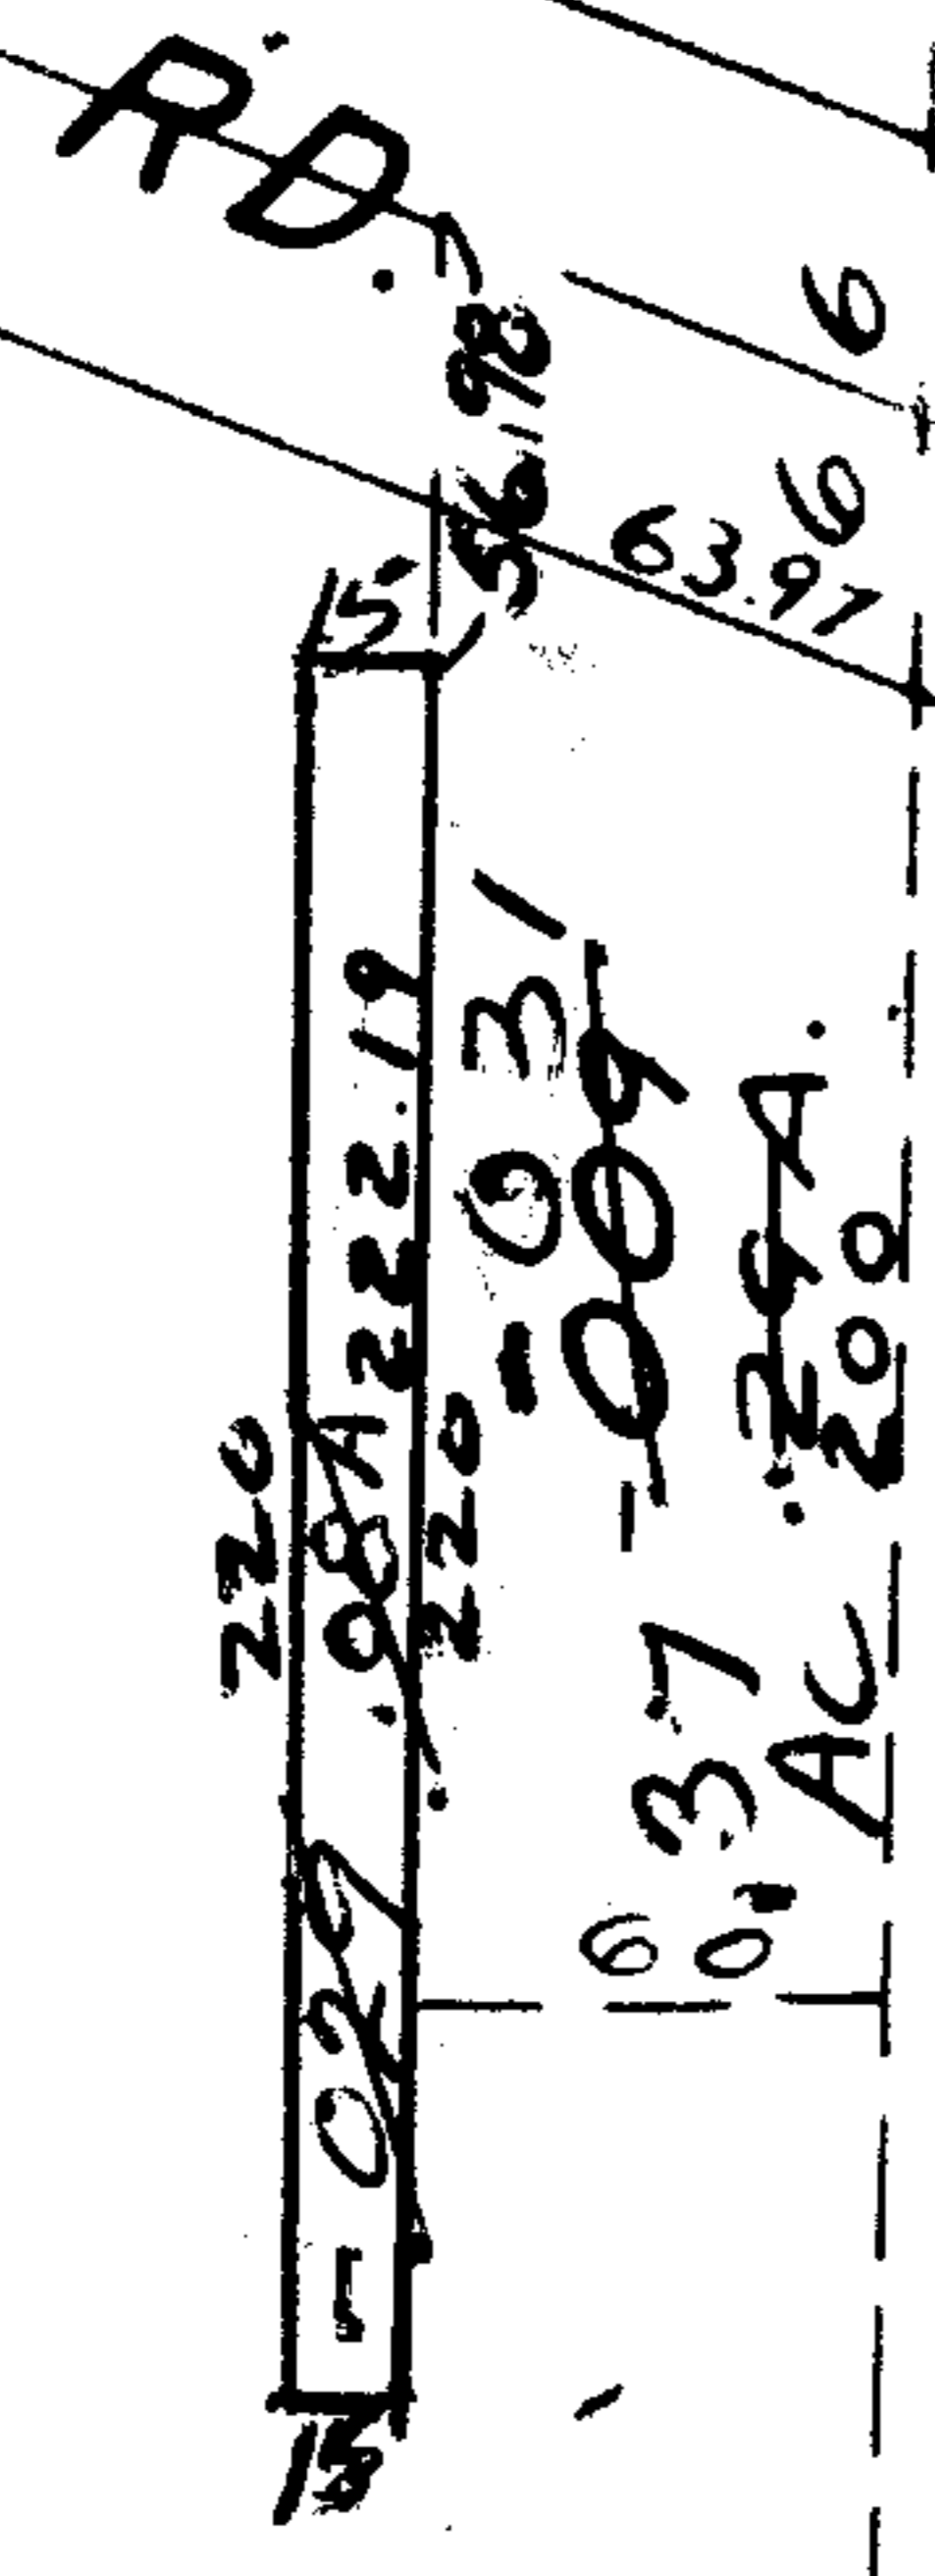

1864.50

SEE 4-00-022-F

NOV 26 1975

DEC 31 1975

04-00-022-103-009  
29Ac  
Jmdr Georg J & Mary E  
10-22-75

9278

APPROVED	
LORAIN CO.	
MAP DEPT.	
DATE	11-21-75
PAGE	4-00-022E
BY	LVH/ALC
VOID AFTER	