

-006
47.61A

9296

1056.83

669.90

656.7

311.01 100.7
199.74 300 100.4

610

300
-002
1.45A
300

225

-005
131.56A

-001
56.50 A

36

3811.50
3778.50

004
~~-002~~
55.92 A
54.31

3778.50


48 C

A

374.78
213
587.98

2817.85

R AUG 27 1976

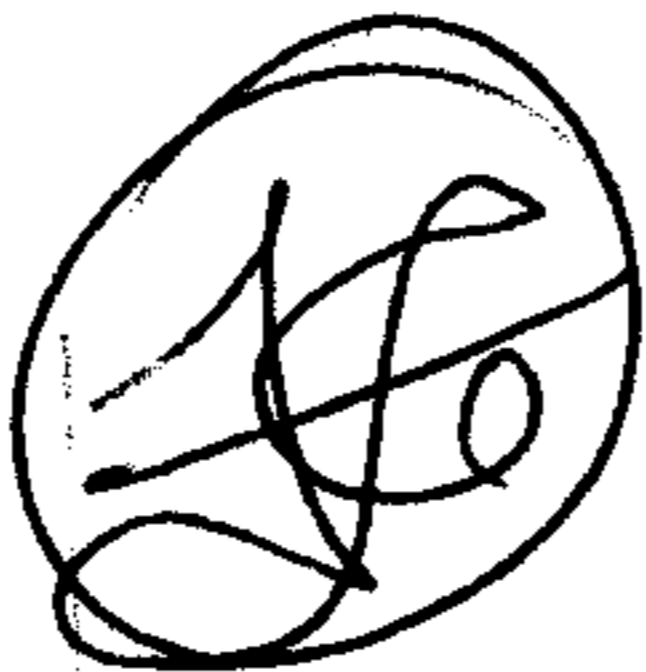

9296

APPROVED
LORAIN CO.
MAP DEPT.
DATE 12-5-75
PAGE 19D
BY L.W. Hall
VOID AFTER

94 96
648.50
587.78
55.72

T

55.72

213
-003
1.61
330

MEDINA - NORWALK TRACT A LOTS 36 4

VERMONT