


Pt. -003
Pt. 91.13 A.

SECS. - S.
W. 1/2 18,

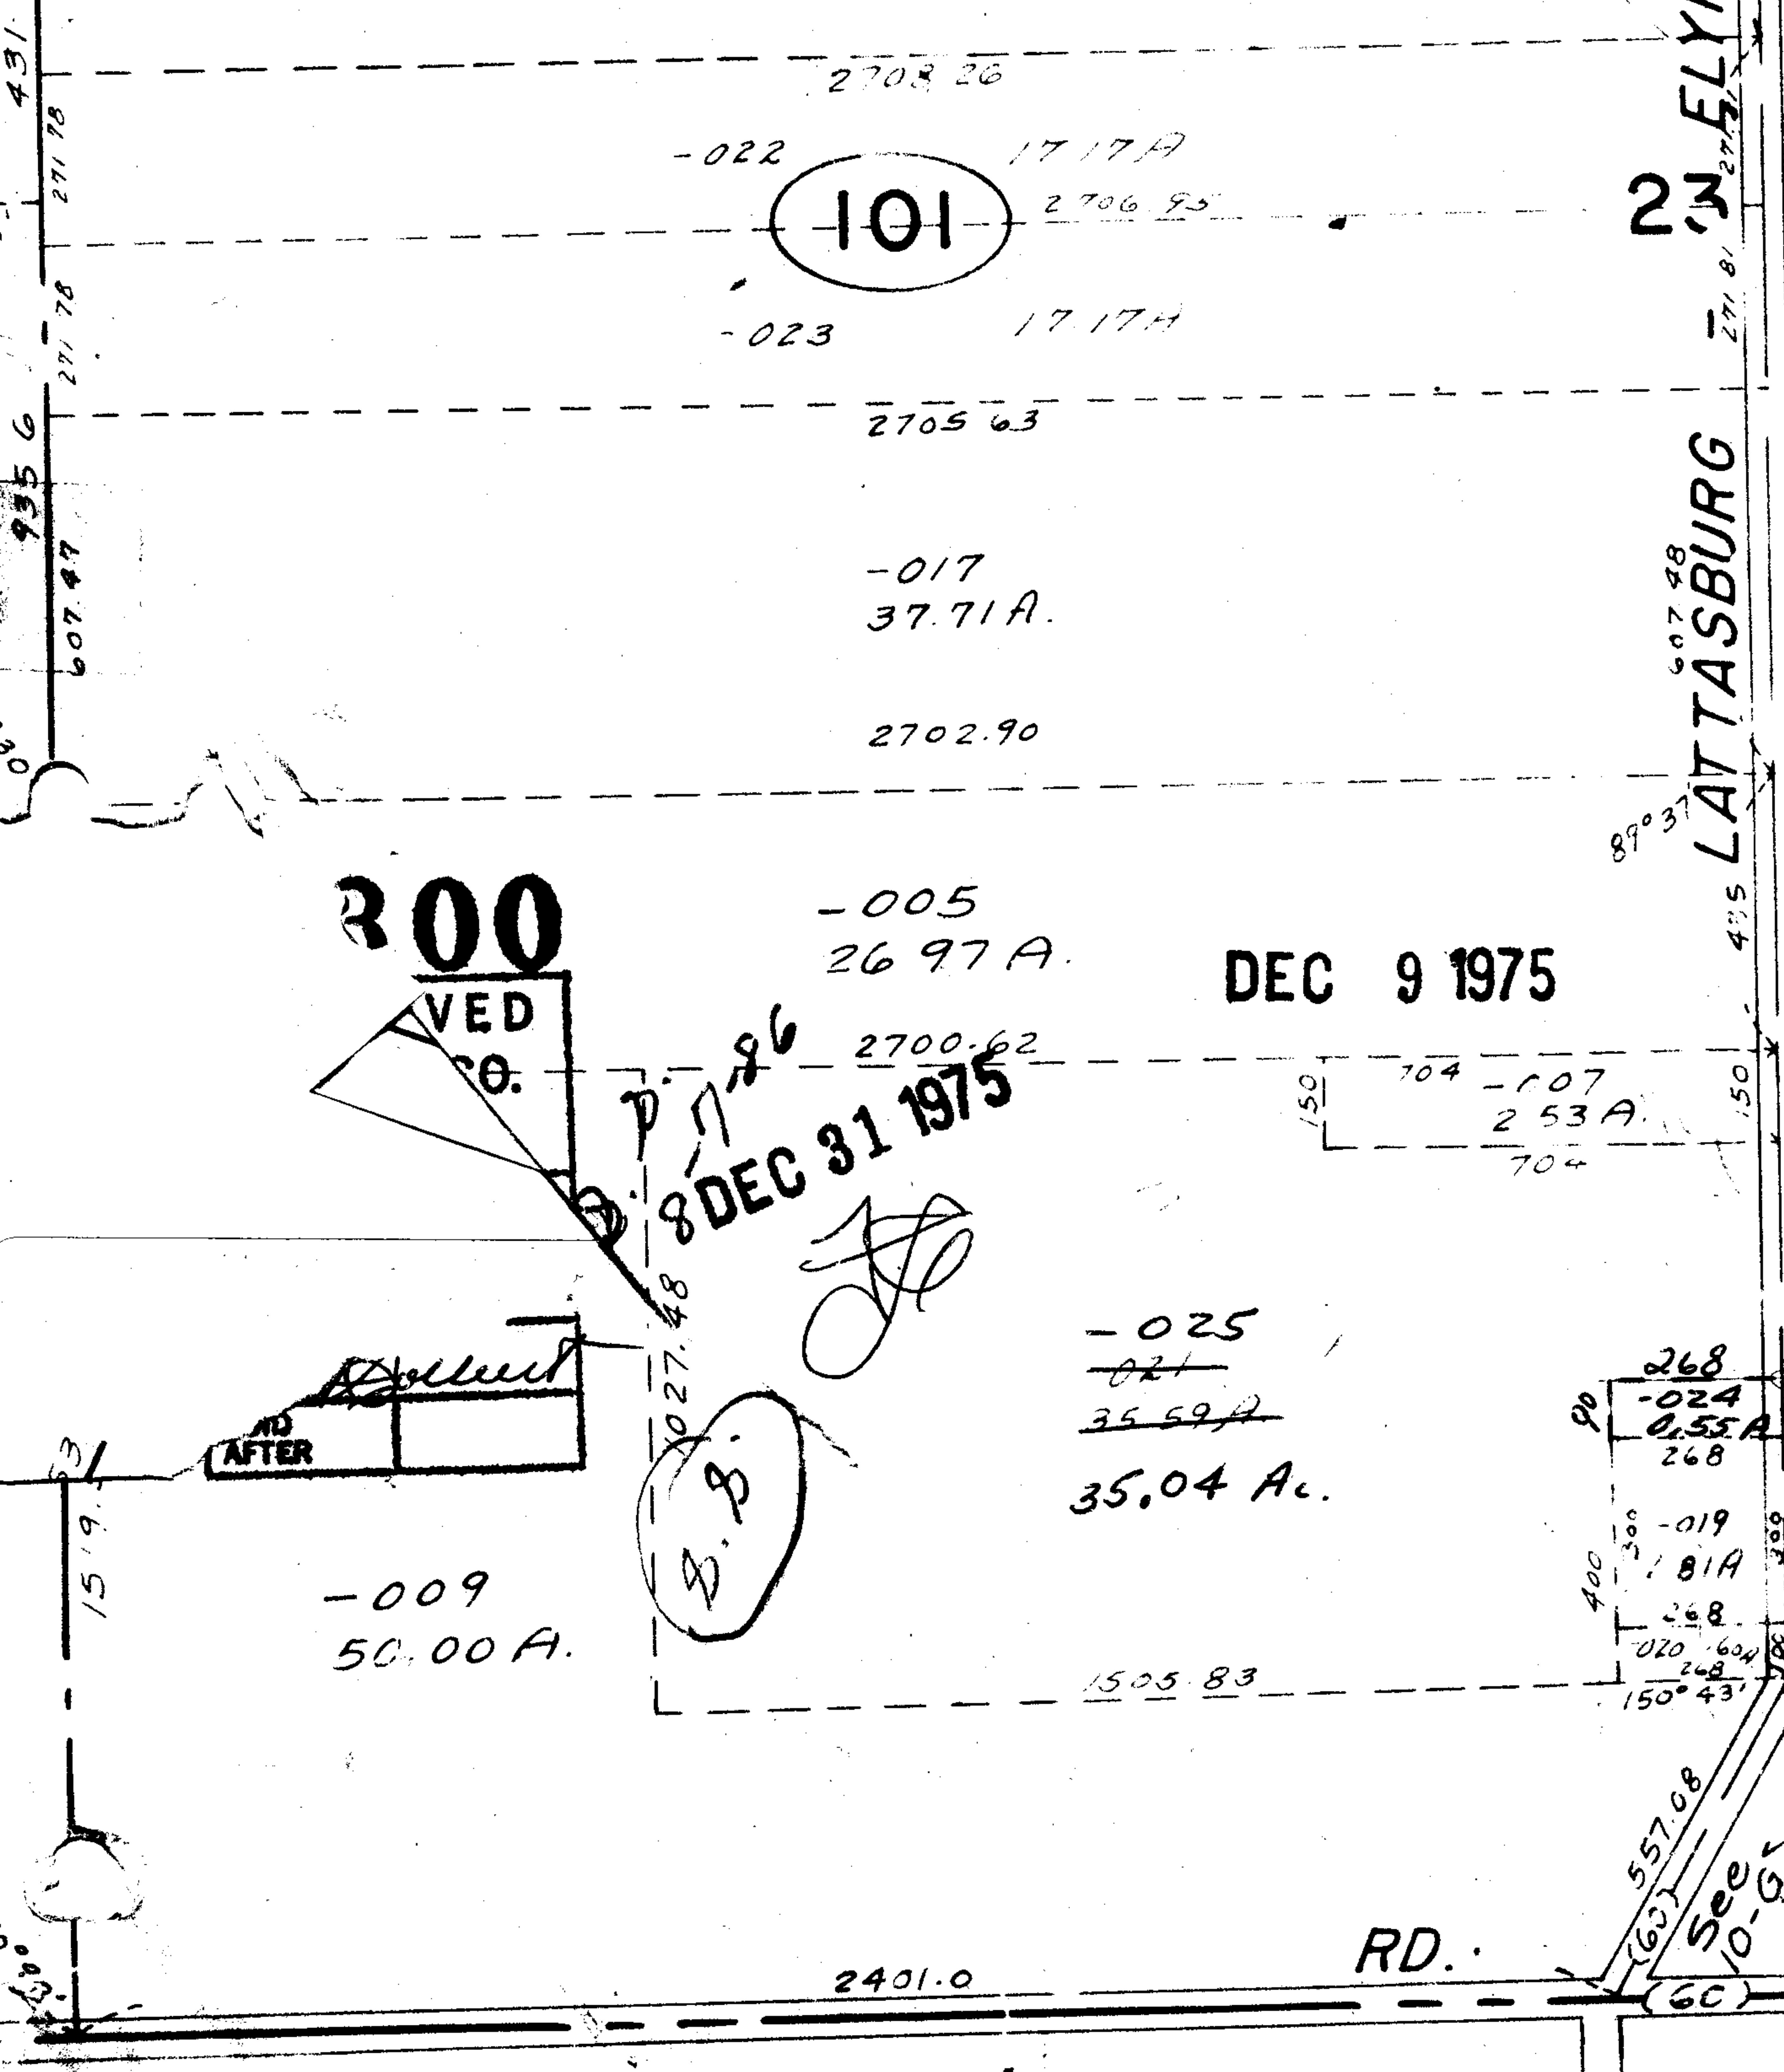

2 N ELYRIA
LATTASBURG

CARLISLE TWP.

SCALE: 1" = 400'

Copyright 1963
Revised 9-29-76

10-F