

PECK - WADSWORTH

1079.76 RD.

BA

132
-006
50A
165

60)

(60)

9307

-001
57.42 A.

-002
36.30 A.

-006
~~-003~~
48.75 A.
39.00 Ac

5

↑

DEC 12 1975

9307

APPROVED
LORAIN CO.
MAP DEPT.

DATE 12-11-75


PAGE 17A+B

BY L.W. Hall

VOID
AFTER

8-5-86 L.I.

DEC 31 1975

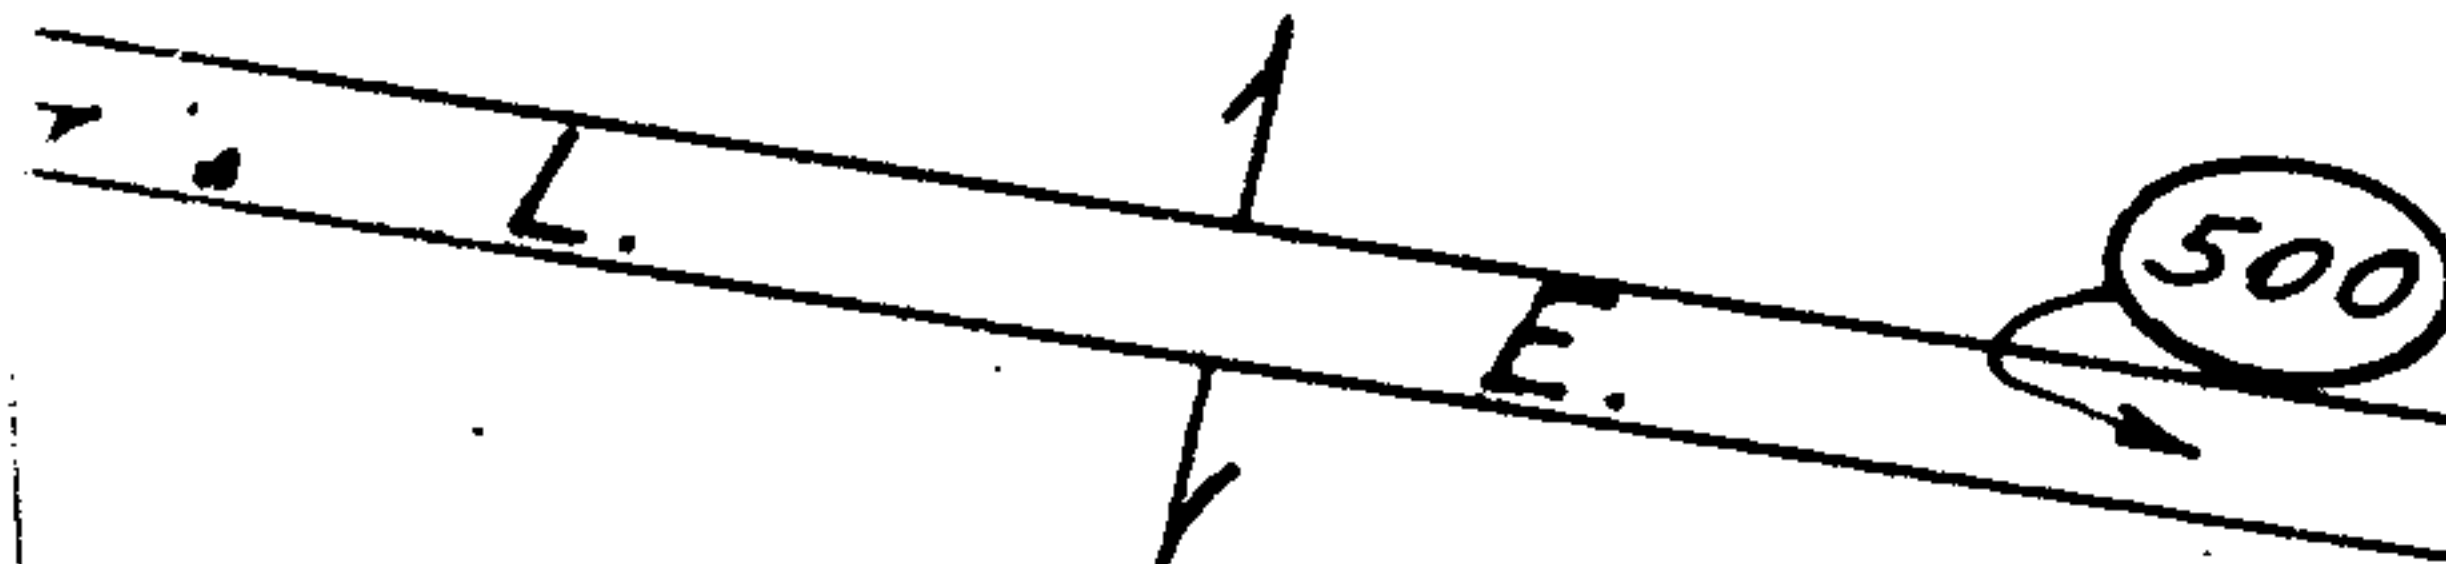

-001
83°40'
1008.5
7.92 A.

-004
22.20 A.

-005
9.75 Ac

R.R.

478.30

-001
20.00 A.

OL6

↑

-002
2.24 A.

Straight Transfer -003
6.75 A.

992
1315.38

257

1147.71

24.5