

9311

DEC 11 1975


DEC 31 1975

9311

APPROVED LORAIN CO. MAP DEPT.	
DATE	12-11-75
PAGE	5-00-095B
BY	L.V. Hall
VOID AFTER	

~~003~~
~~47.43~~
044

~~03~~
43A. 46.43 AC

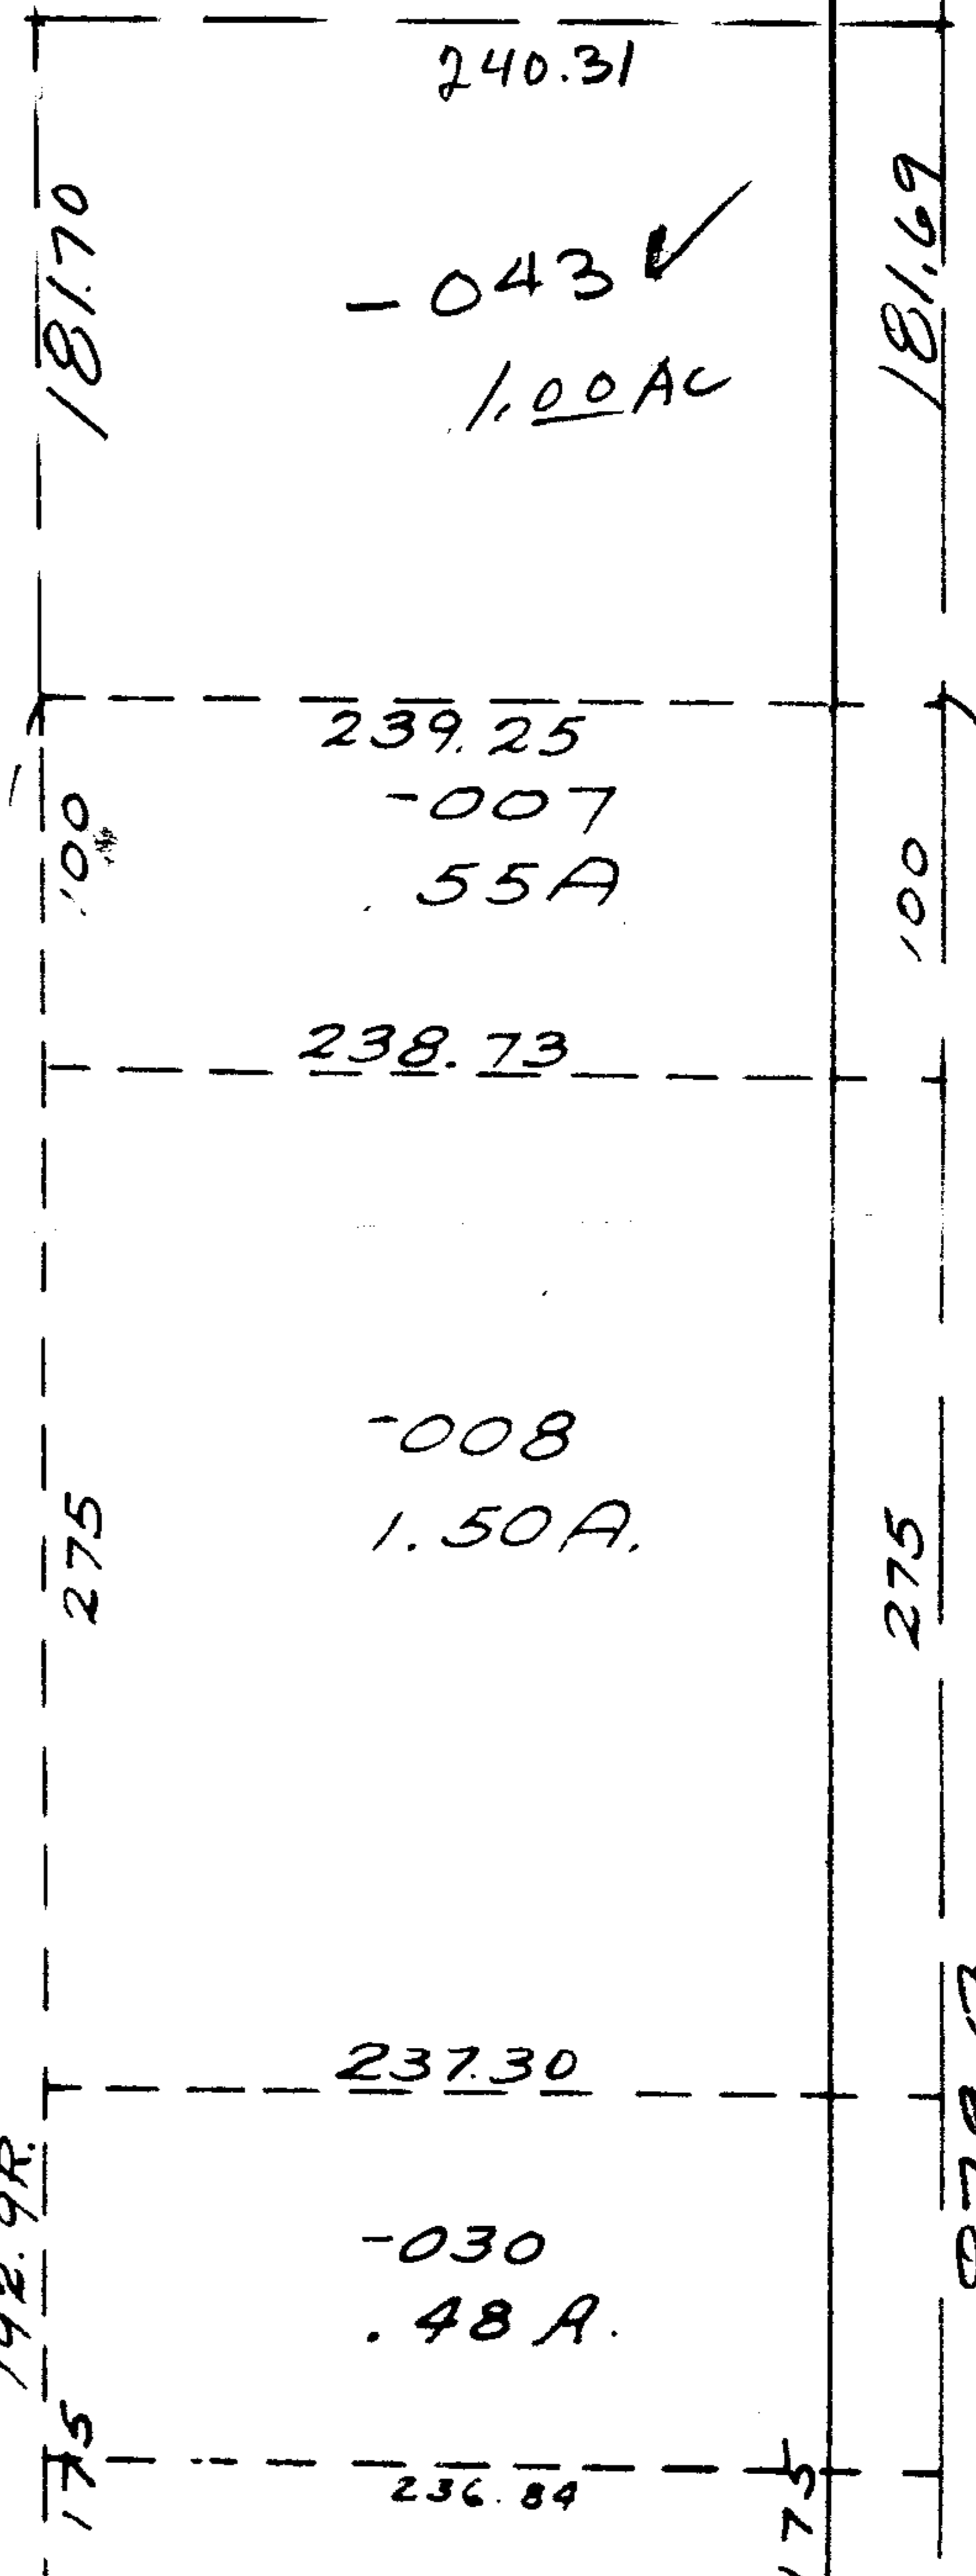

181.69

100

275

879.50

SFF 5-00-095-C