


Co. Comm. Res 75-1,030
9/30/75

CLINTON

ROOSEVELT E

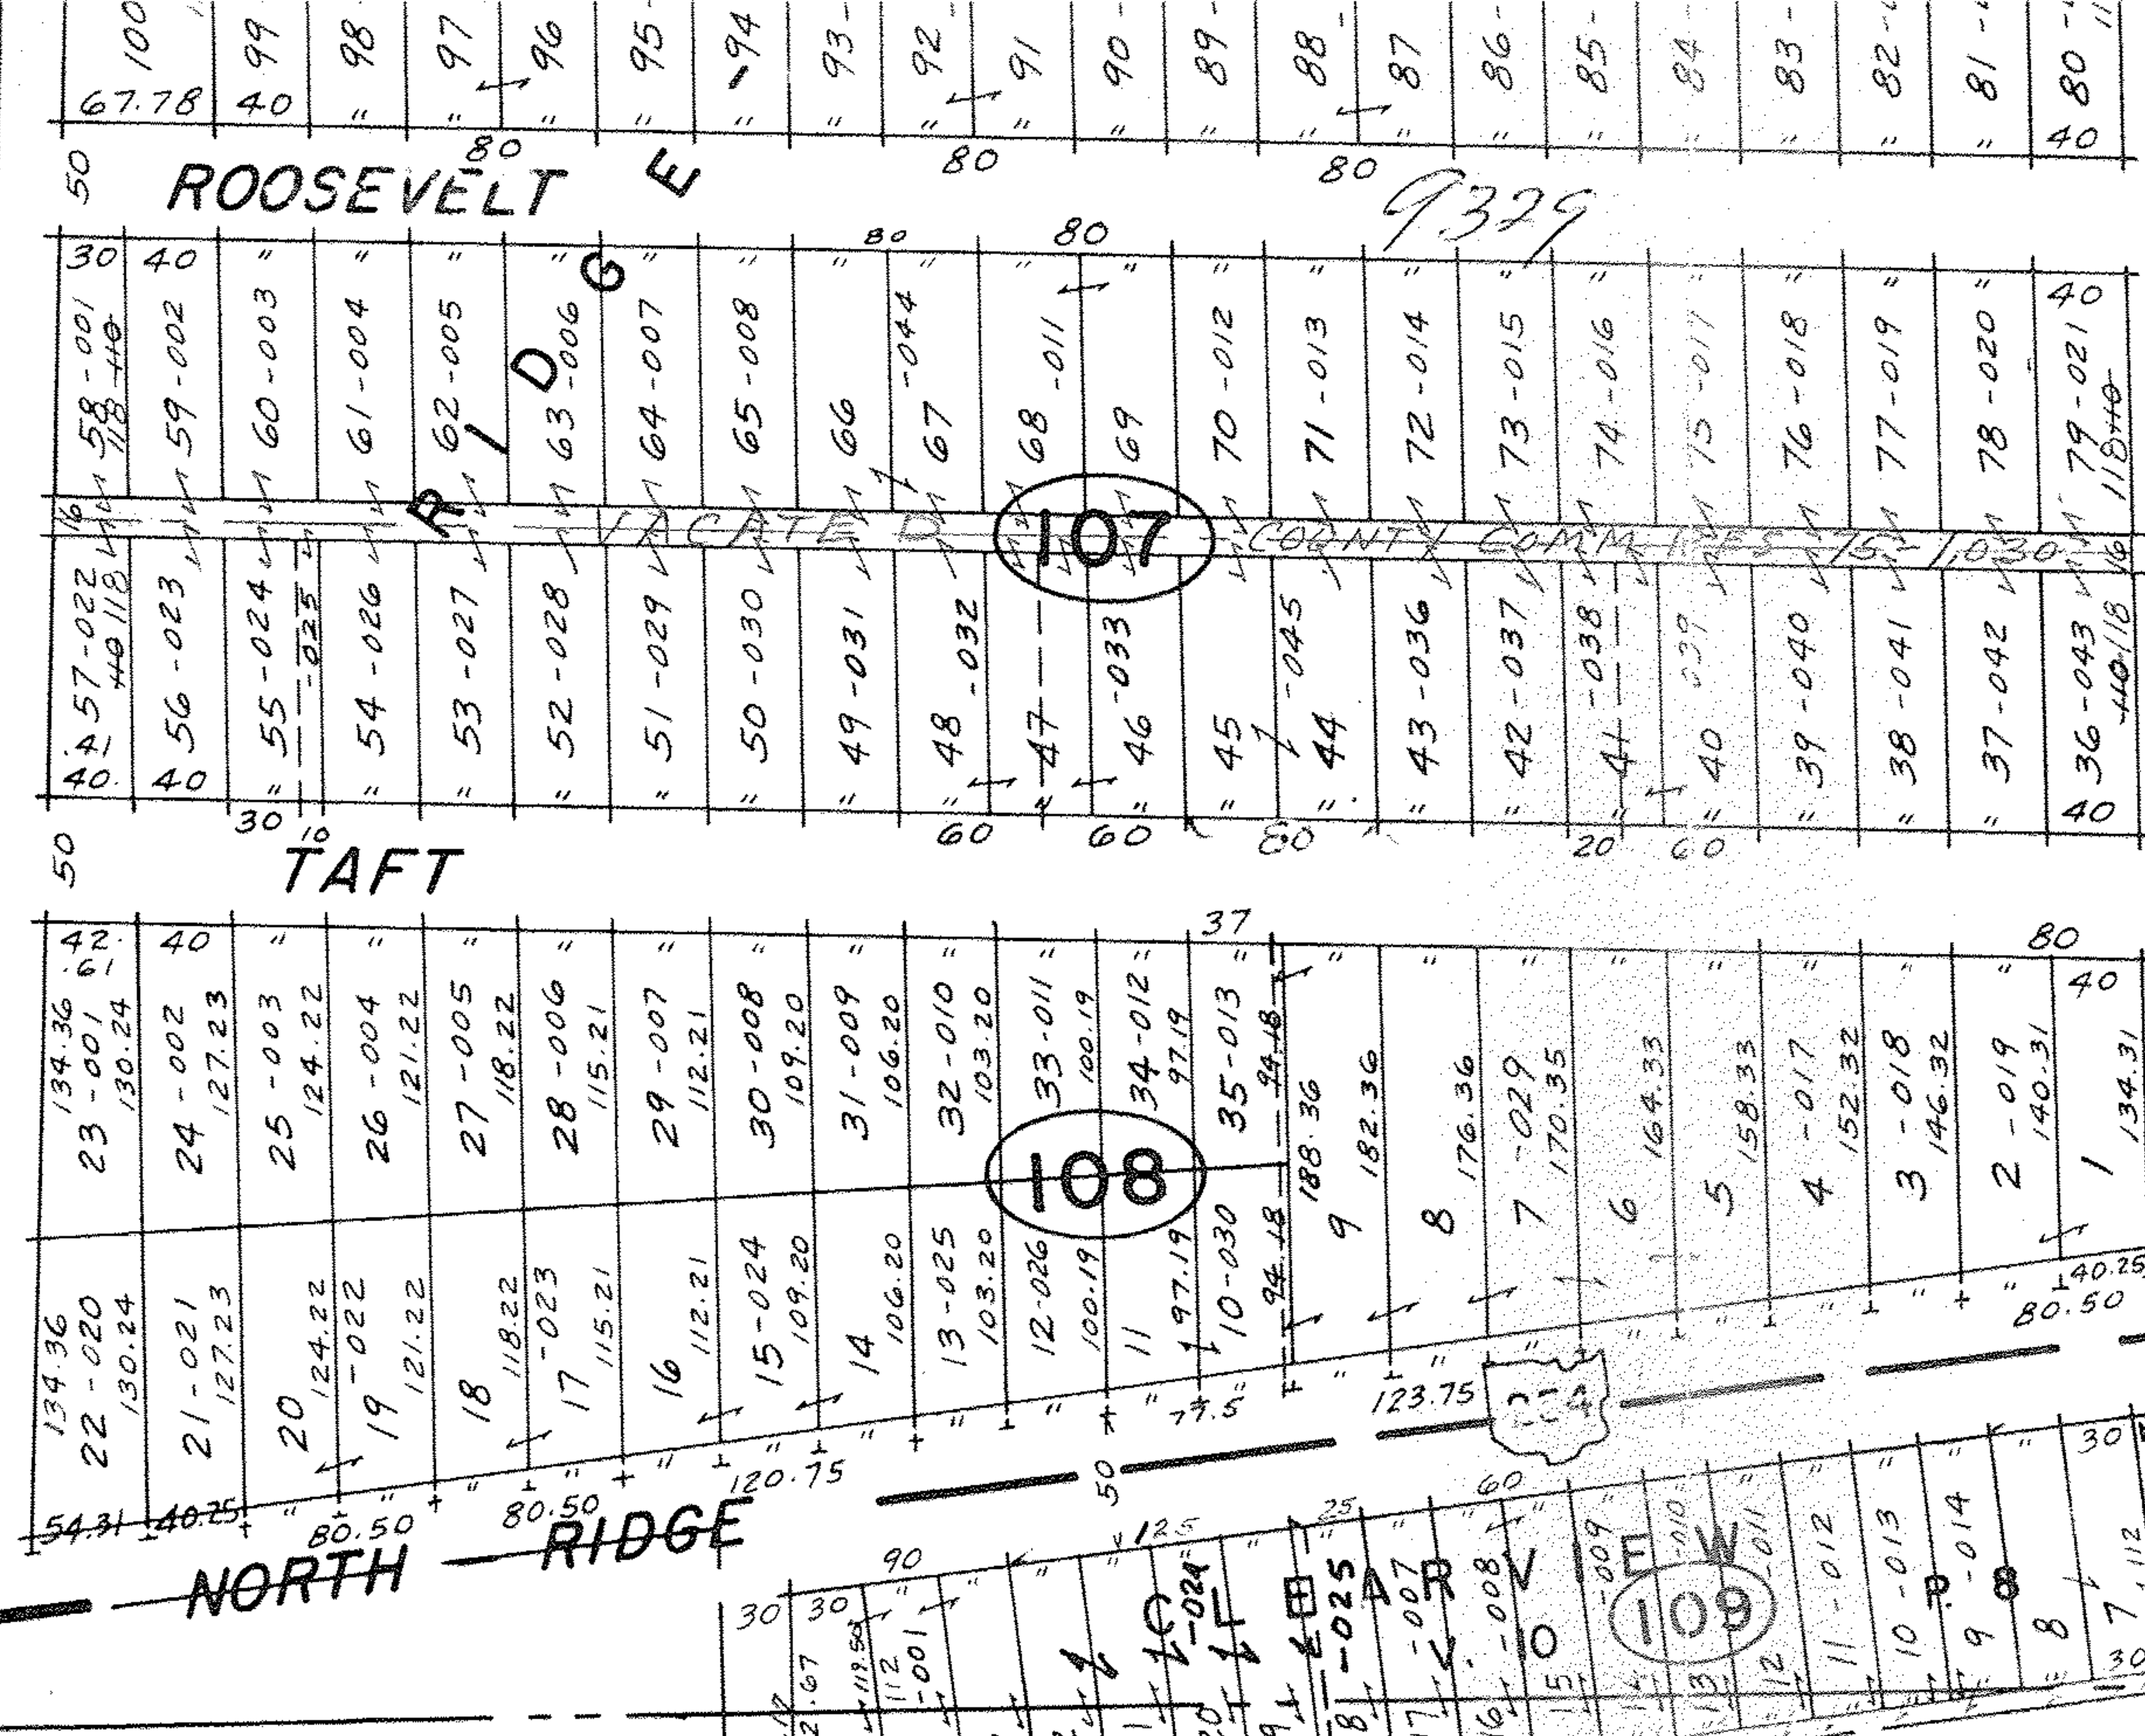

OAKWOOD

AVE.

RD.

Tax Map Copy

JUN 1 1977

SHEFFIELD TWP.

SCALE: 1" = 100'

W. PT. LOT 109

SEE 6-8

9329

Vacated Co. Comm.
Res. 75-1030
Sept 30-75

13.5
+
1.43

28.100
8.00

78.900