


9360

JAN 8 1976

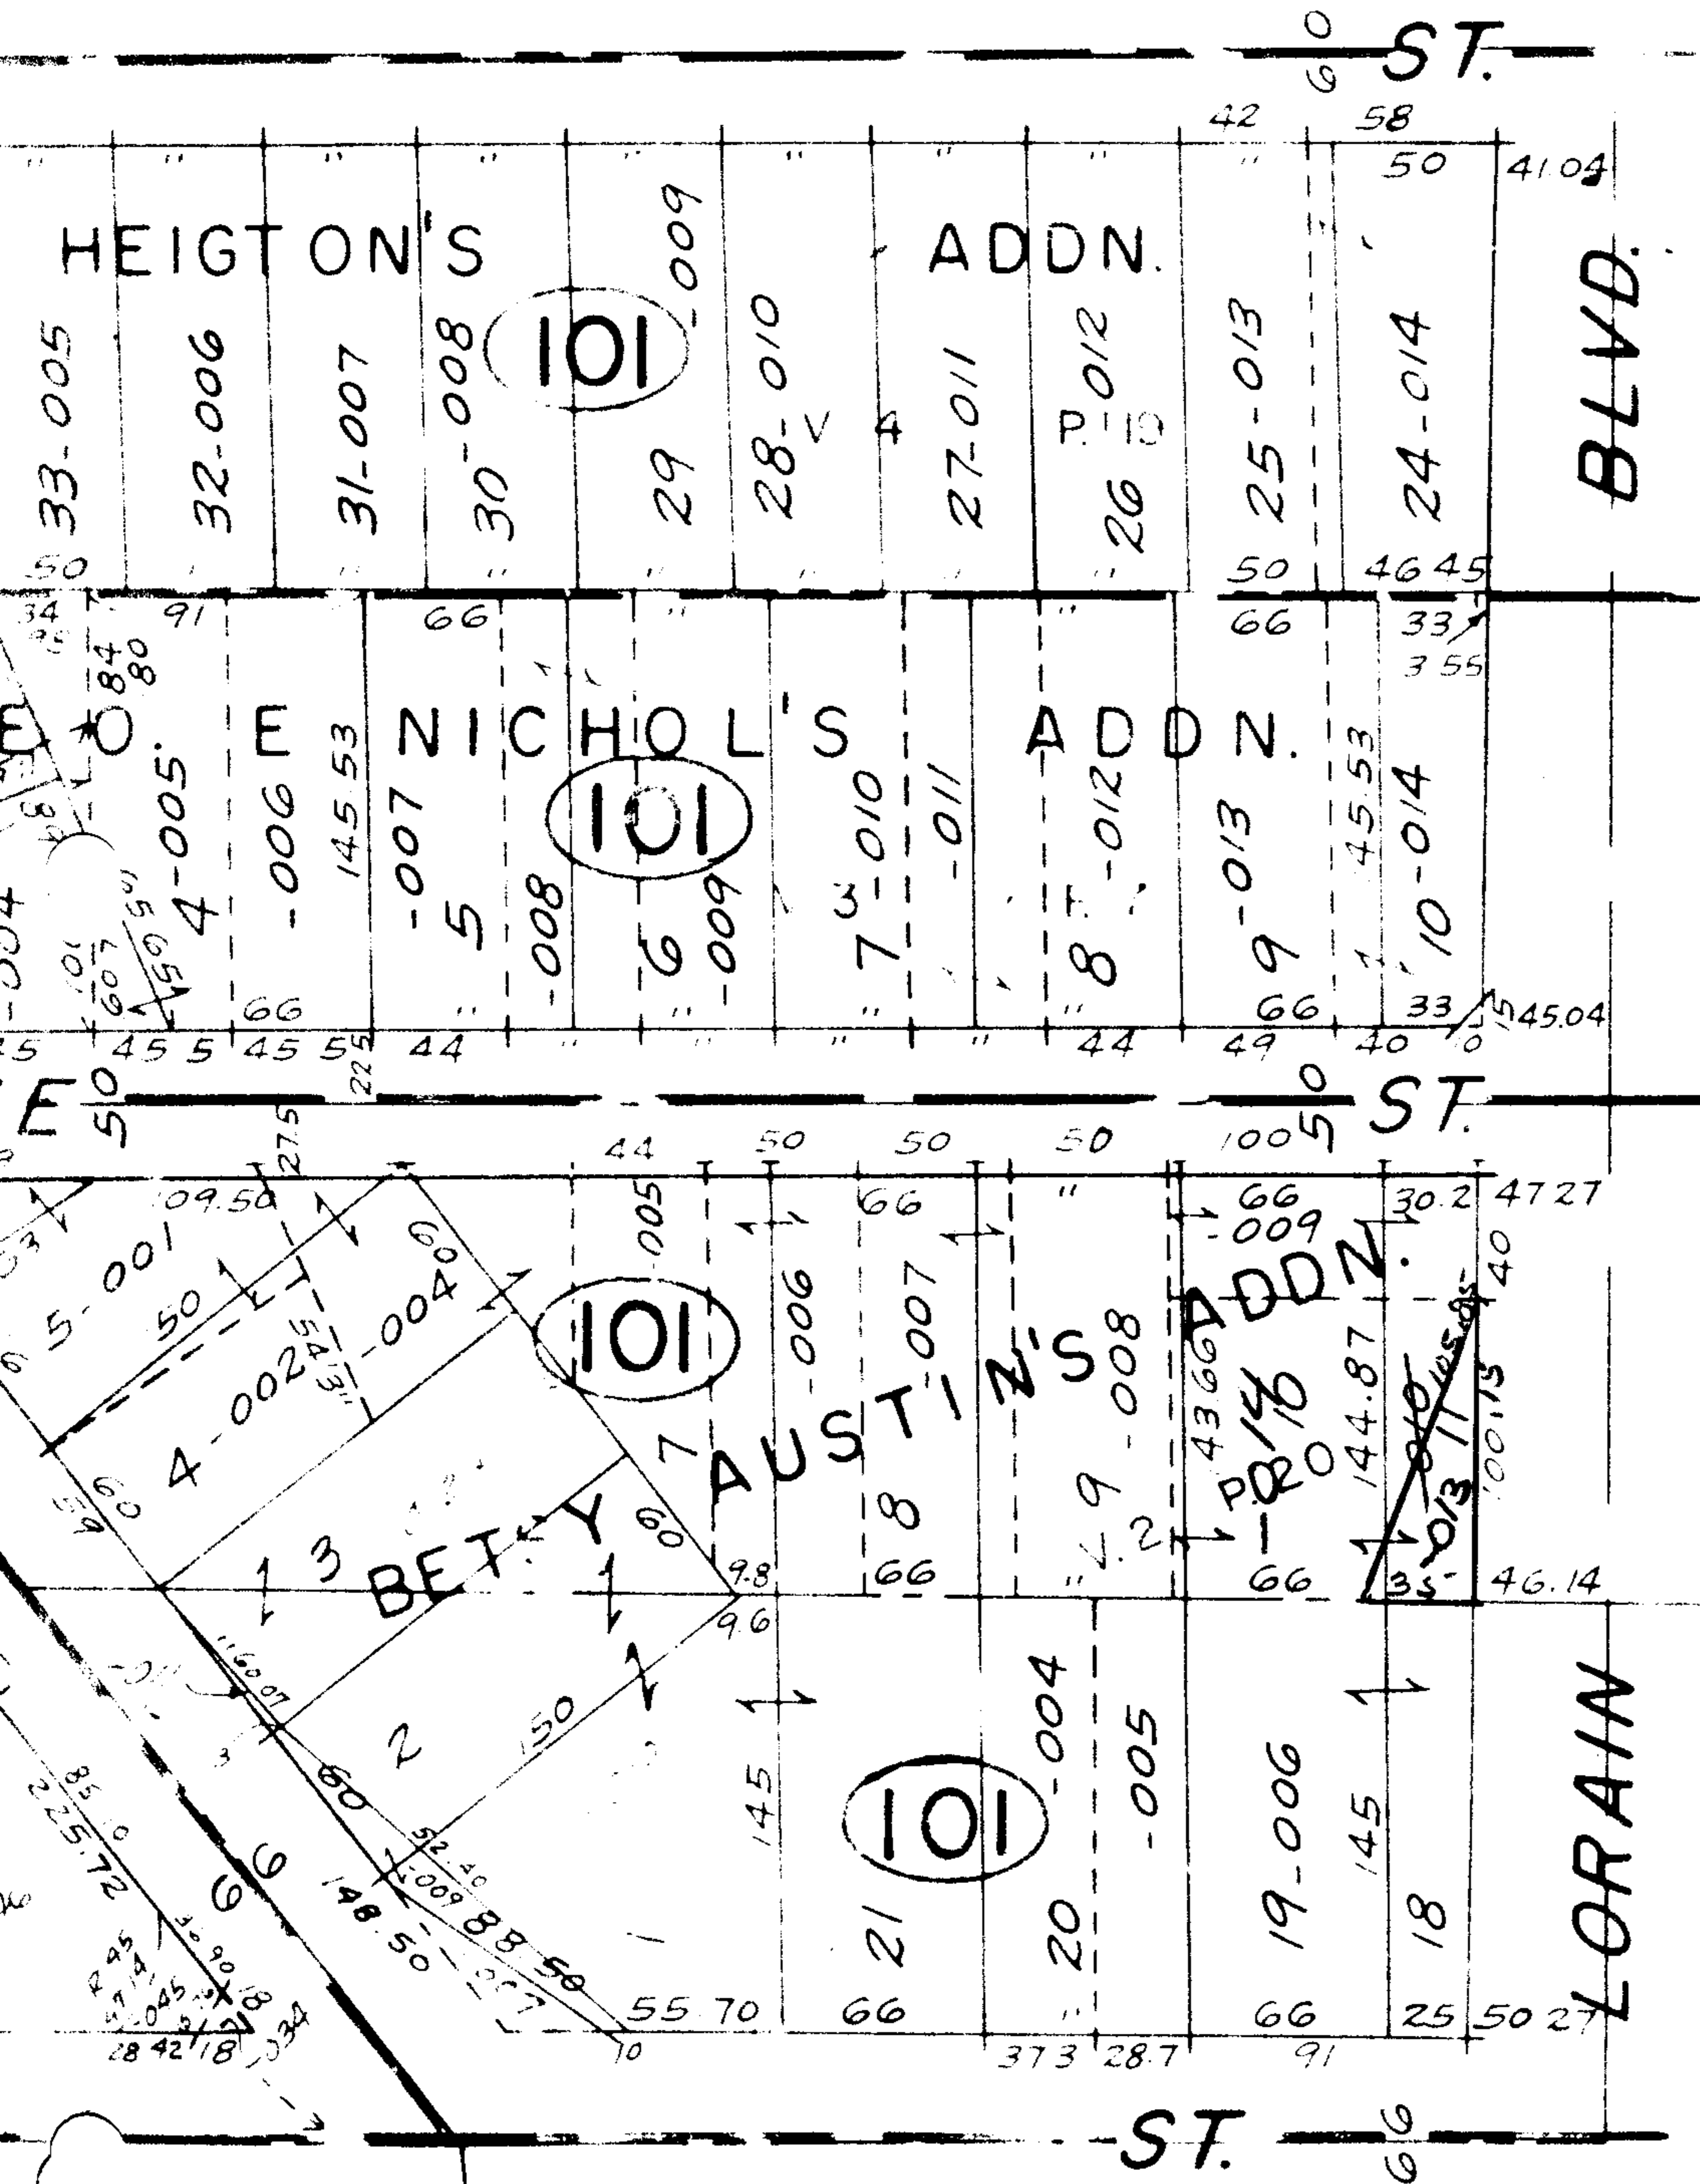

63

62

61

60

H-26-76

9360

APPROVED LORAIN CO. MAP DEPT.	
DATE	1-8-76
PAGE	6-99
BY	LW Hall
VOID AFTER	