

9365

600

9365

APPROVED
LORAIN CO.
MAP DEPT.
DATE 1-30-76
PAGE 9-00-077B
BY L W Hall
VOID AFTER



~~029~~
~~3179A~~

031

35.65 AC

D.B.
~~8-17-86~~

OCT 28 1976

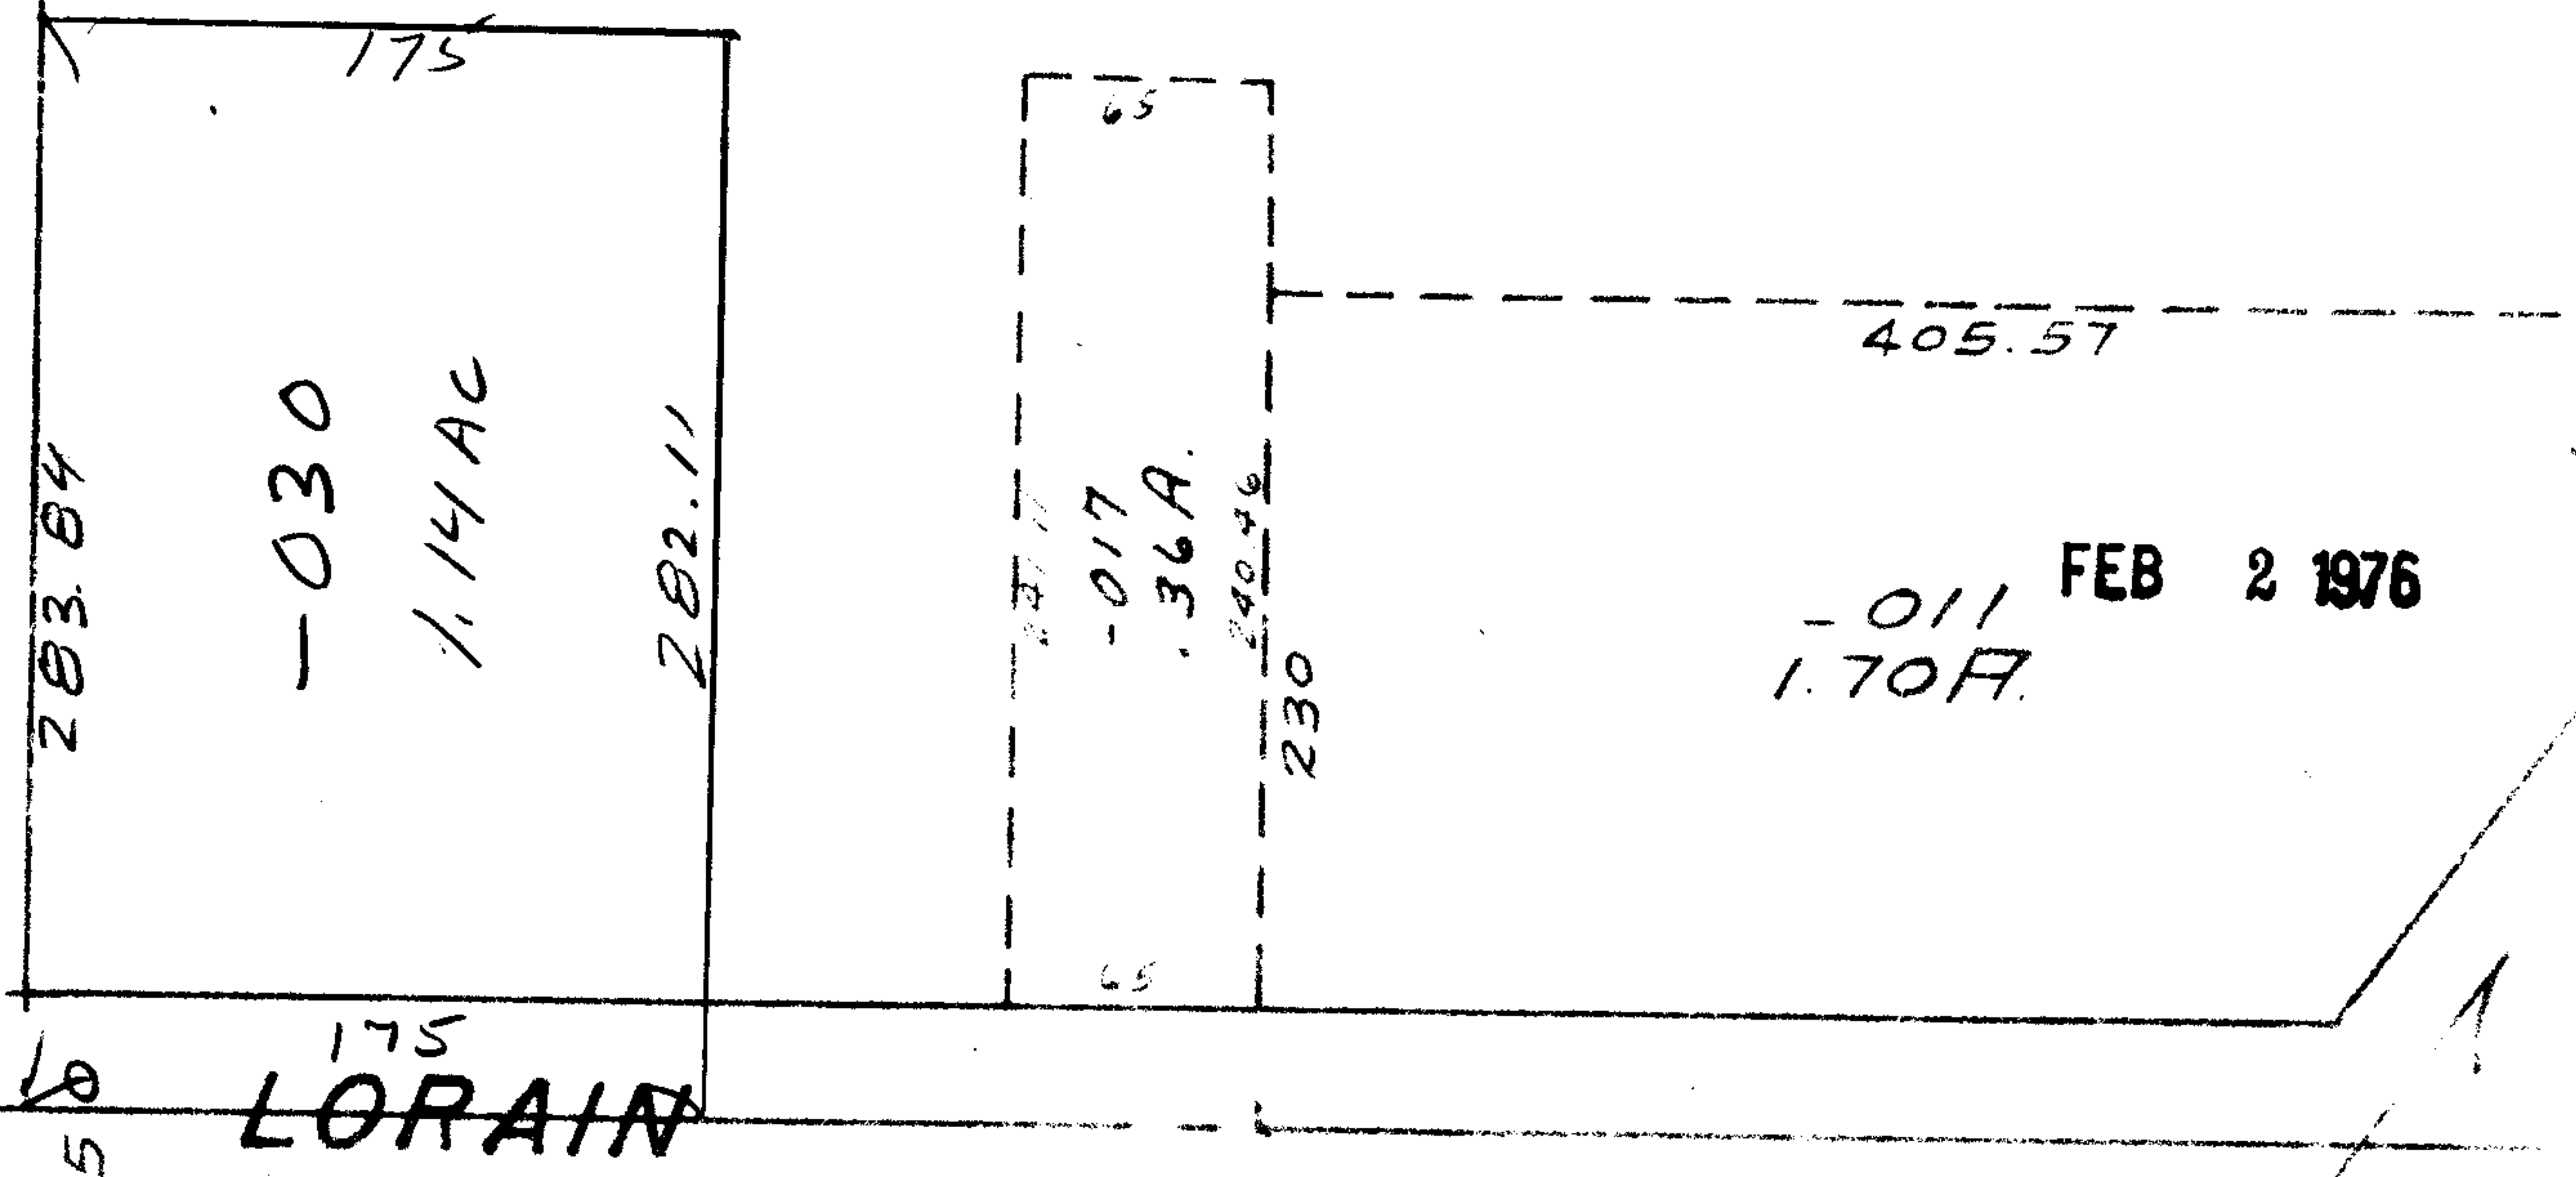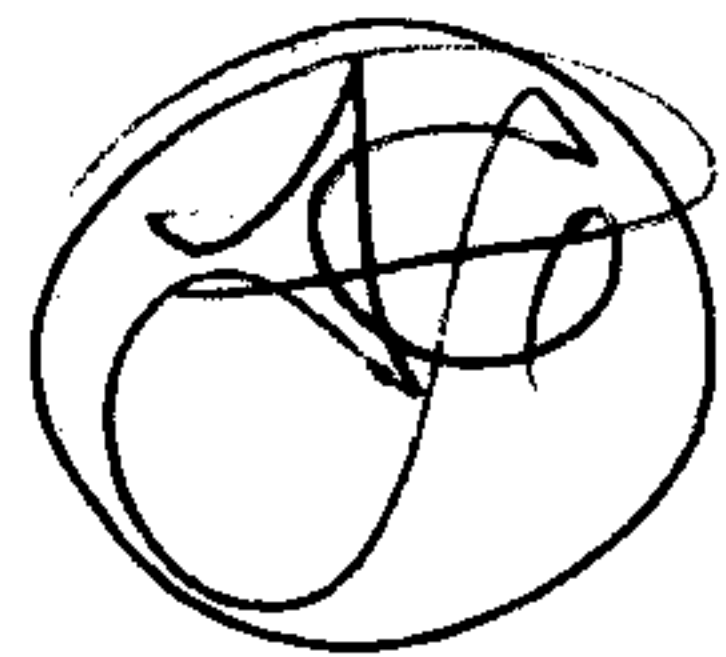

SEE