

-033
.55 R.

-034
.55 R.

-035
.55 R.

240

-036
.55 A.

-037
.55 A.

240


-039
.55 AC

240

9366

APPROVED	
LORAIN CO.	
MAP DEPT.	
DATE	1-13-76
PAGE	15-00-020 B+A
BY	L W Hall
VOID AFTER	

SEP 10 1976

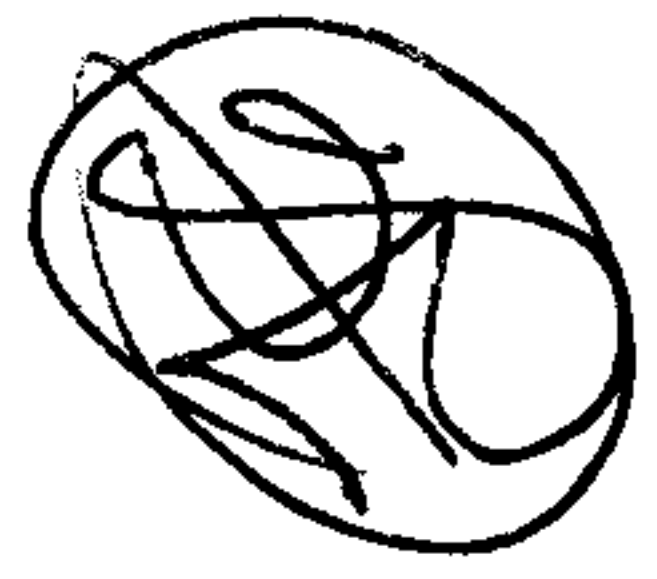

8-5-86 L.L.

040
Pt. ~~038~~
Pt. ~~71.92A~~
71.37AC

JAN 16 1976

SEE 15-00-020-B

9366