


9372

9372

APPROVED	
LORAIN CO.	
MAP DEPT.	
DATE	1-20-76
PAGE	11-00-079A
BY	LW Hall
VOID AFTER	

8-2-76  
 8-7-76  
 15 1976

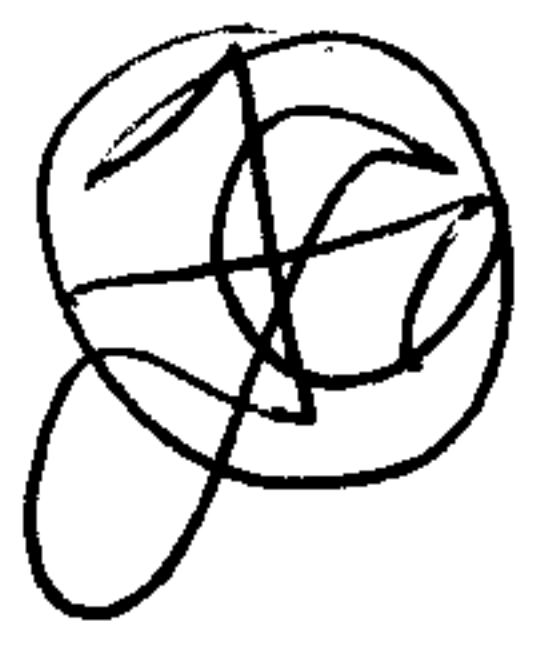

JAN 22 1976

349.97

349.97

-030 .80Ac

349.97

055-

~~053~~  
 5.25 AC  
 4.45 AC

-052

2.08 AC

349.97

-028 .80Ac

349.97

-024 .80Ac

349.97

-054  
 .80Ac

349.97

217.79

-026 .53Ac

229.36

~~PT 053~~  
~~PT 5.25 AC~~  
 PT 4.45 AC

RD

100

100

100

100

200  
 Gallagher  
 -018  
 .46 A.

370  
 Gallagher Eli J + Joan  
 -022  
 .84 A.