


9374

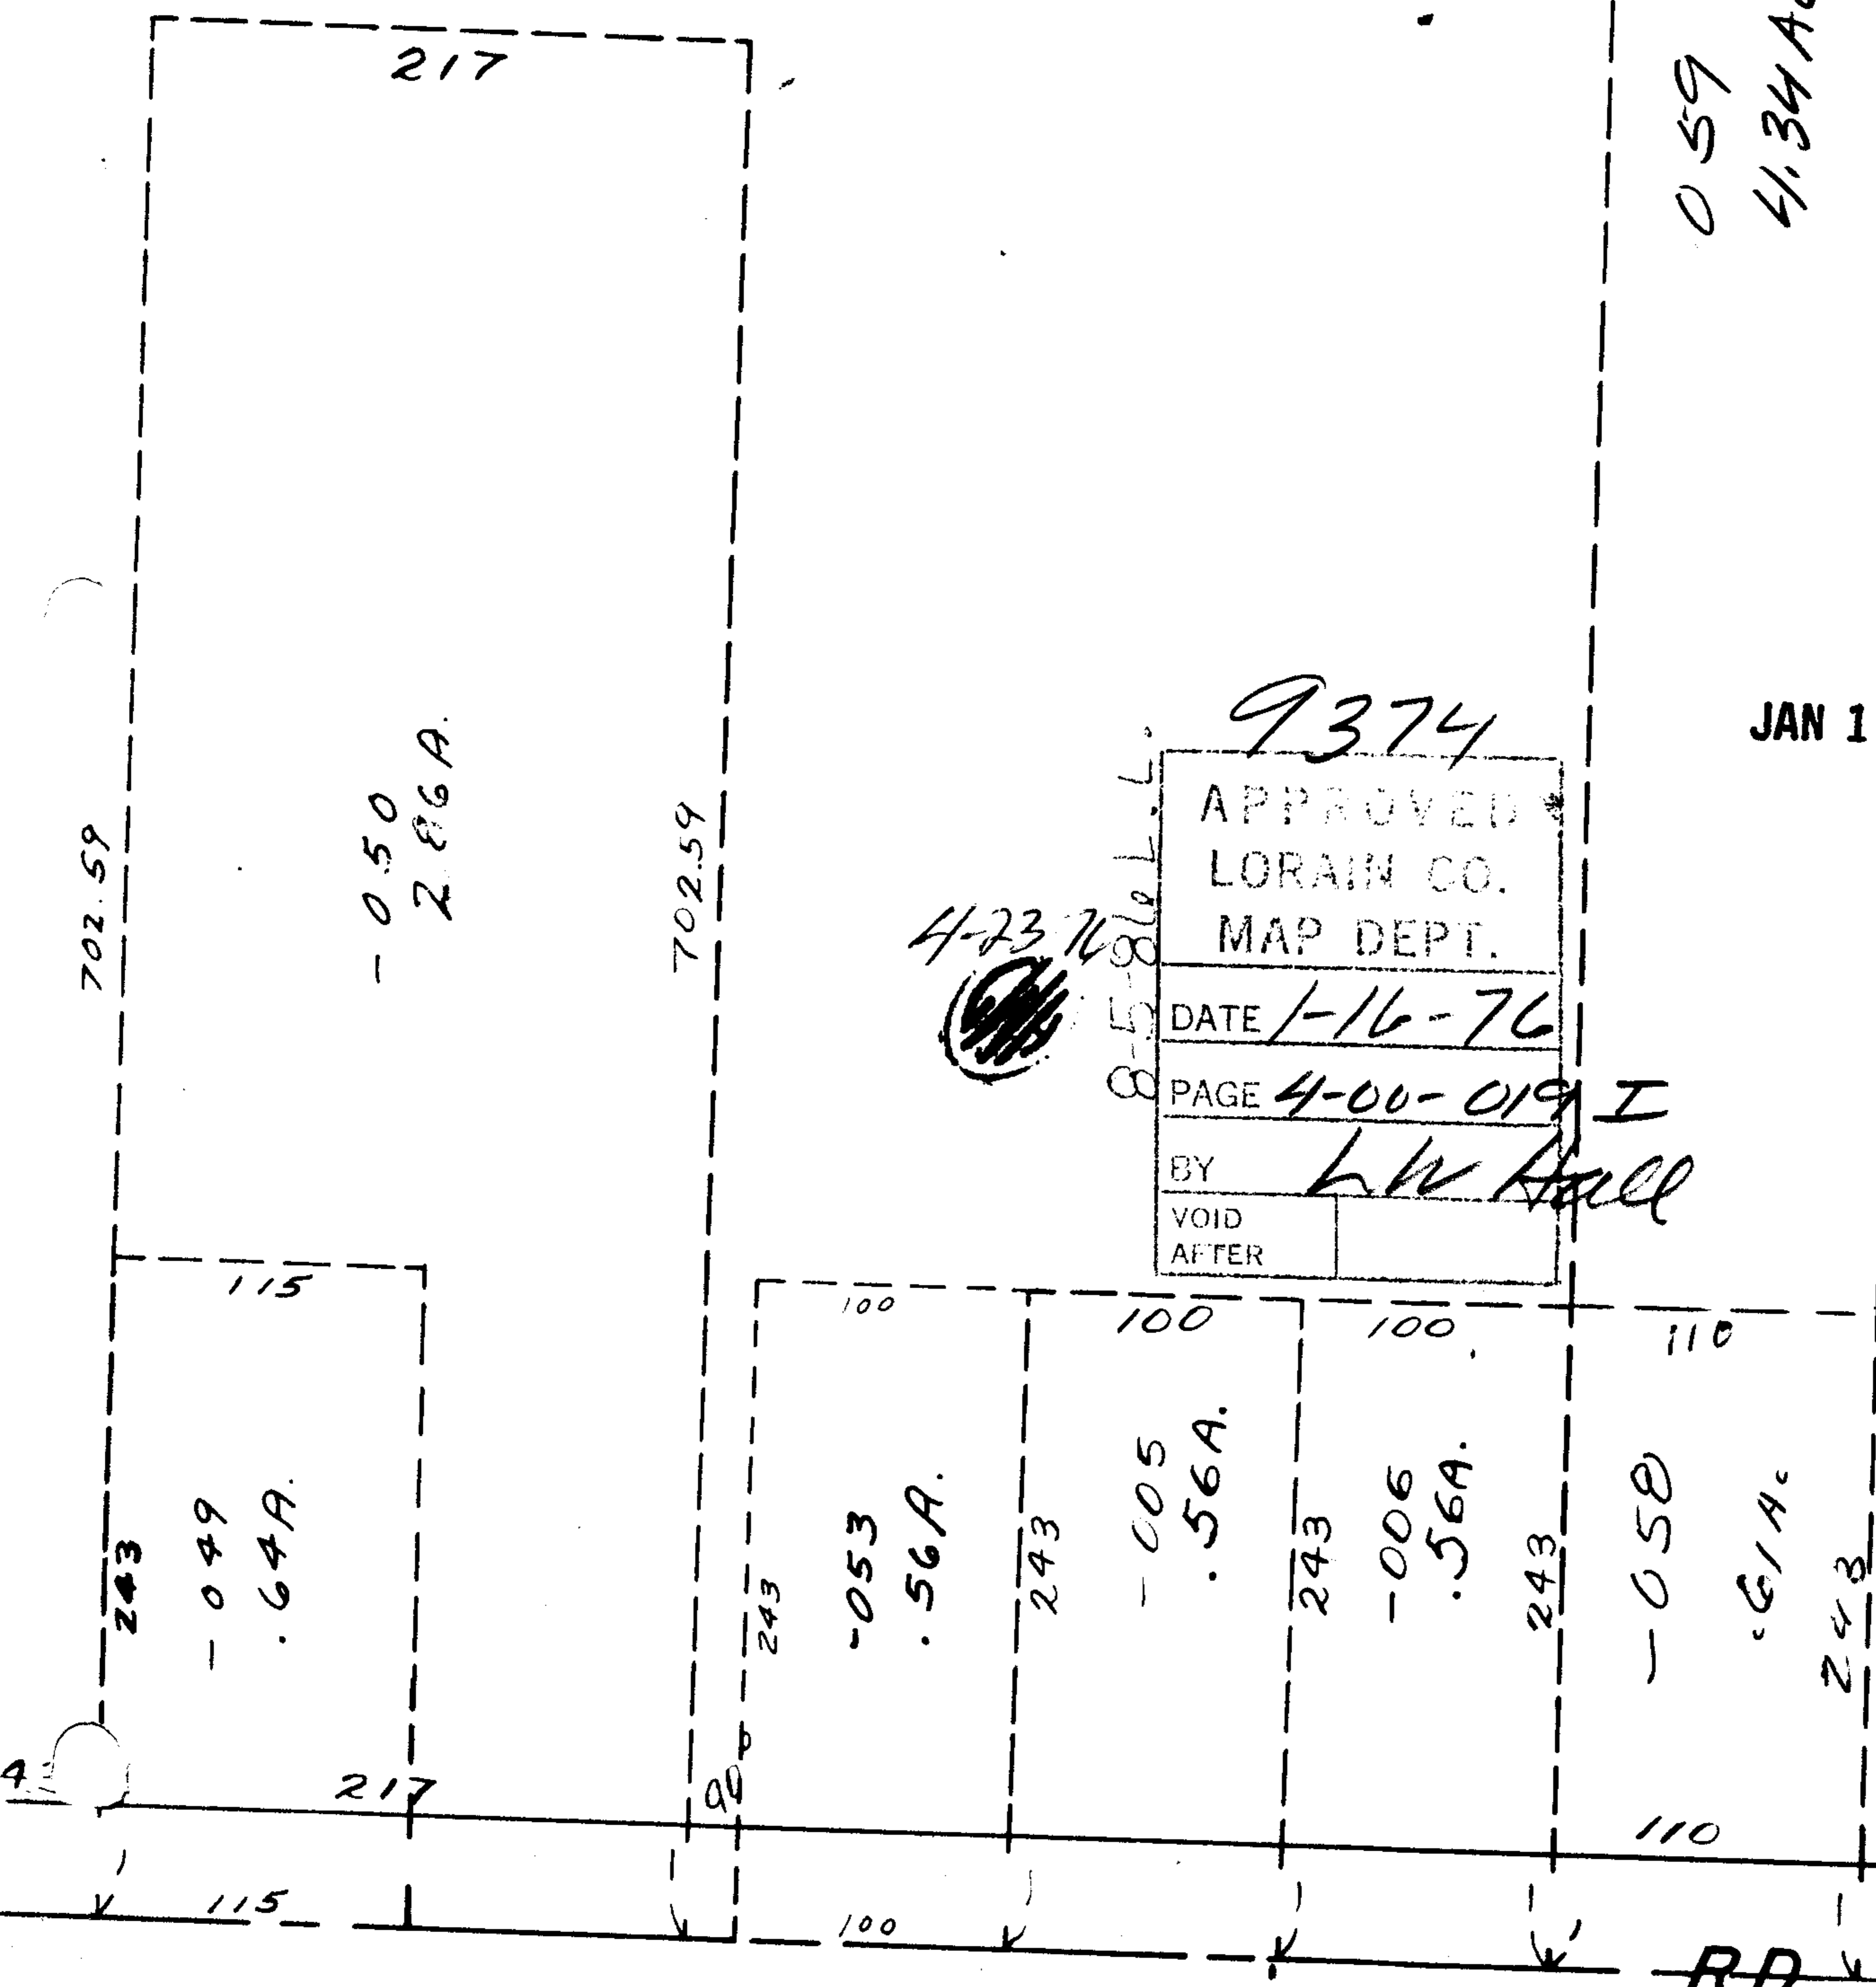

059
4.34 AC
~~007~~
5.00 AC

JAN 16 1976

9374

4-23-76

APPROVED
LORAIN CO.
MAP DEPT.
DATE 1-16-76
PAGE 4-00-019 I
BY L.W. Hall
VOID AFTER

SEE 4-C

RD.