

9375

Copyright 1963

Revised 6-10-69


5-C-030-A

JAN 21 1976

9375

APPROVED LORAIN CO. MAP DEPT.	
DATE	1-16-75
PAGE	5-00-011 B 5-00-030 A
BY	L W HEDY A
VOID AFTER	

8-16-77

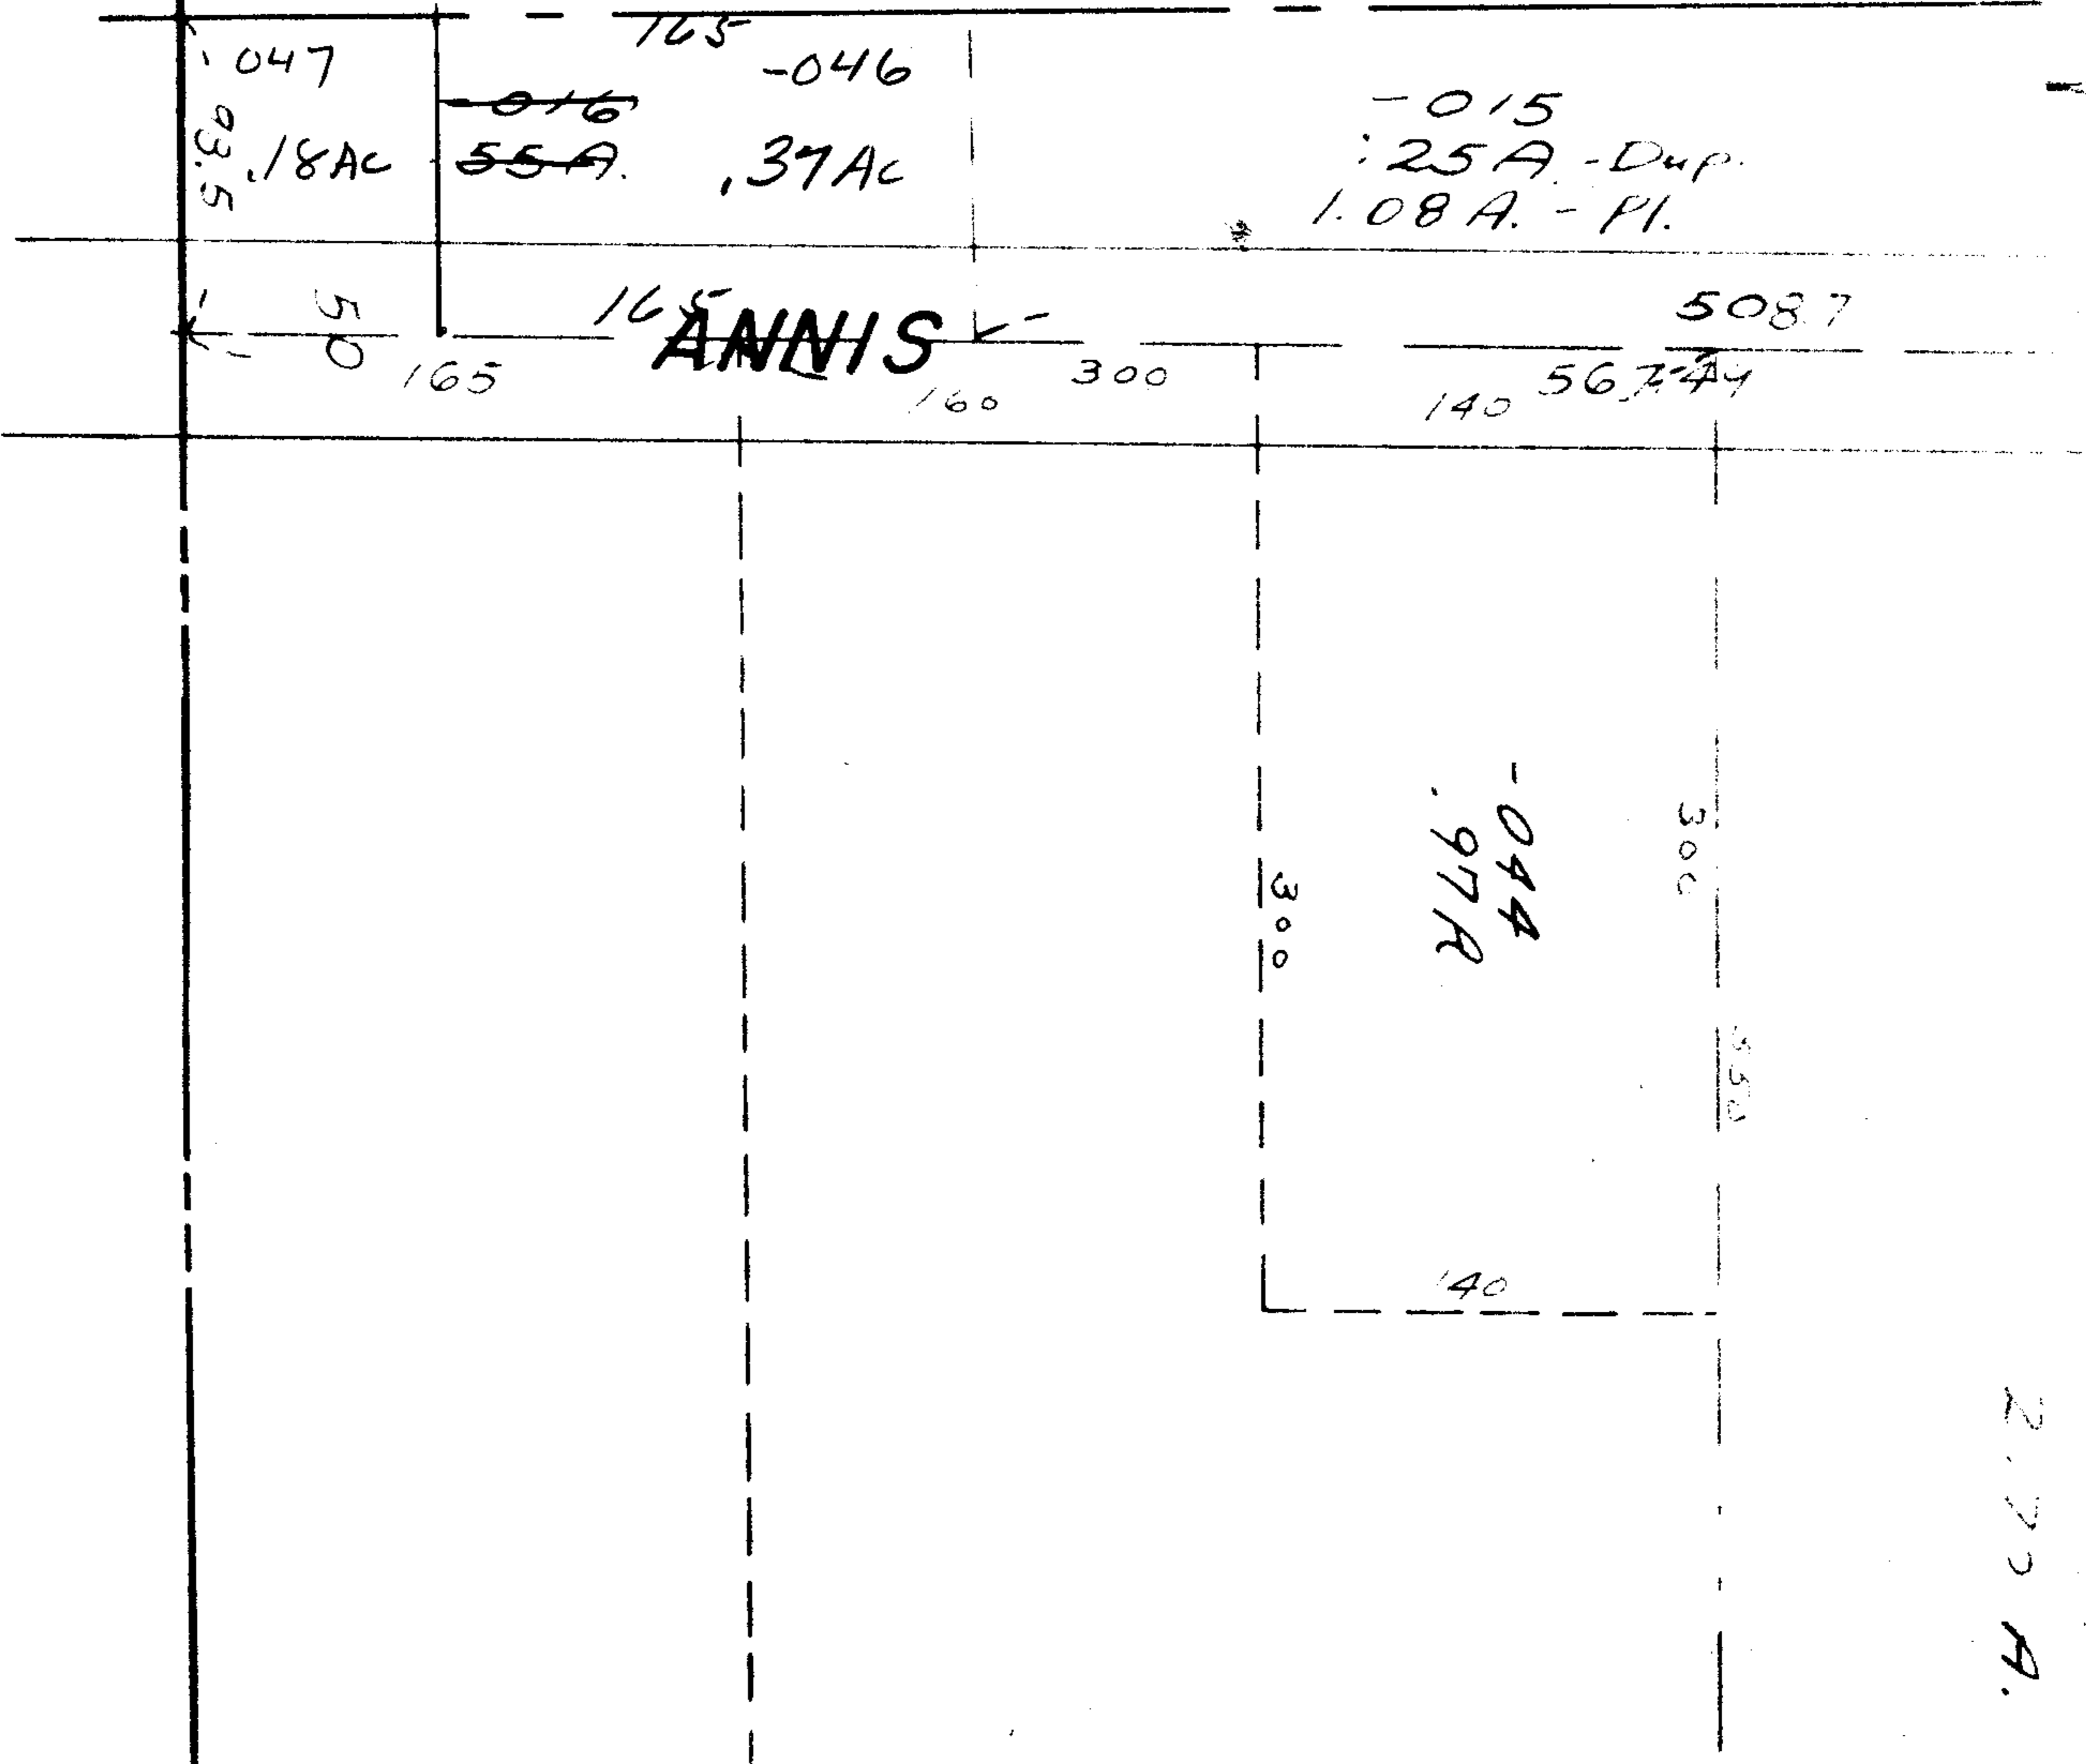

AMHERST TWP.
SCALE: 1" = 100'

2.775 A.