


110.10  
198.16

93.76

SEE 4-00-022-G

500/1  
9/11/76

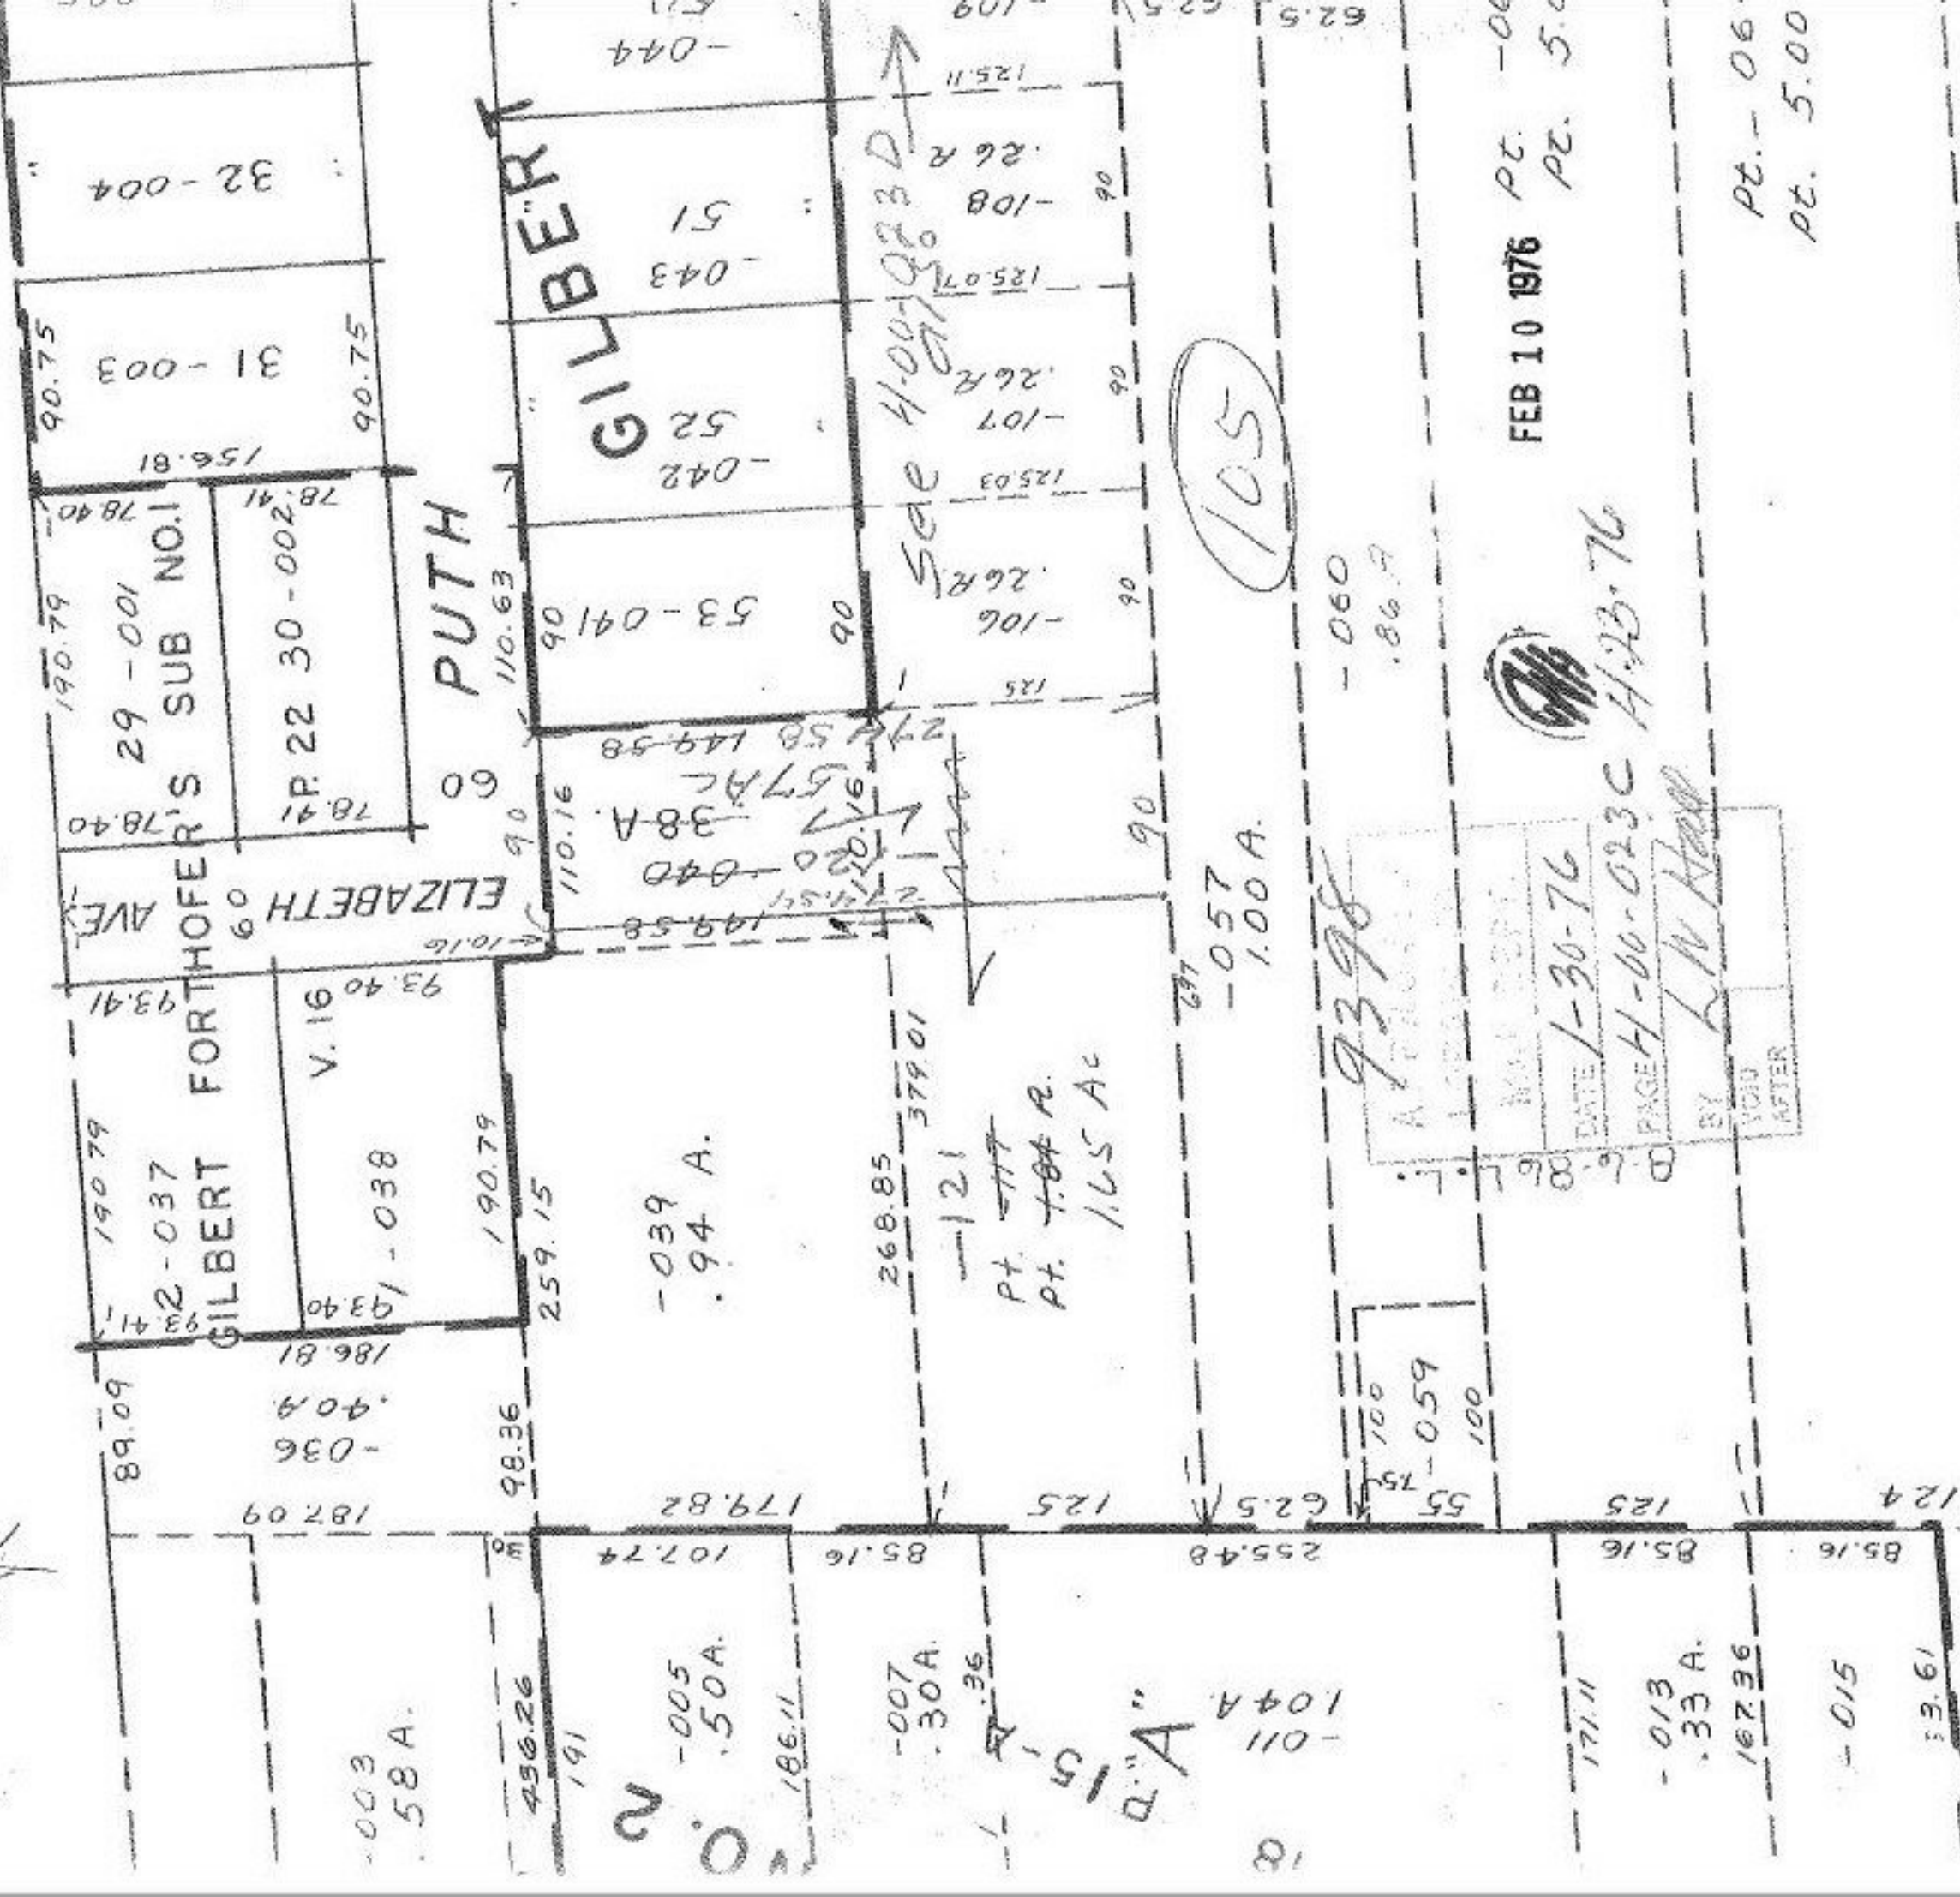

DATE 1-30-76  
 PAGE 4-00-023C H.23.76  
 BY L.W. HARR

FEB 10 1976

Pt. - 06  
Pt. 5.00

Pt. - 06  
Pt. 5.00

Pt. - 06  
Pt. 5