

-004
2999 A.

9399

-007
30.02 A.

-016
4.96 A.

-007
33.23 A.

-015
67.83 A.

9399

APPROVED
LORAIN CO.
MAP DEPT.

DATE 7-30-76

PAGE 9D

BY L.W. HALL

100.3

50.00 A.

30

98-8
8.8


Account
Connection
By Bureau
J. Pozysnik

FEB 10 1976

OCT 28 1976

-004
23.00 A.

RD.
(60)

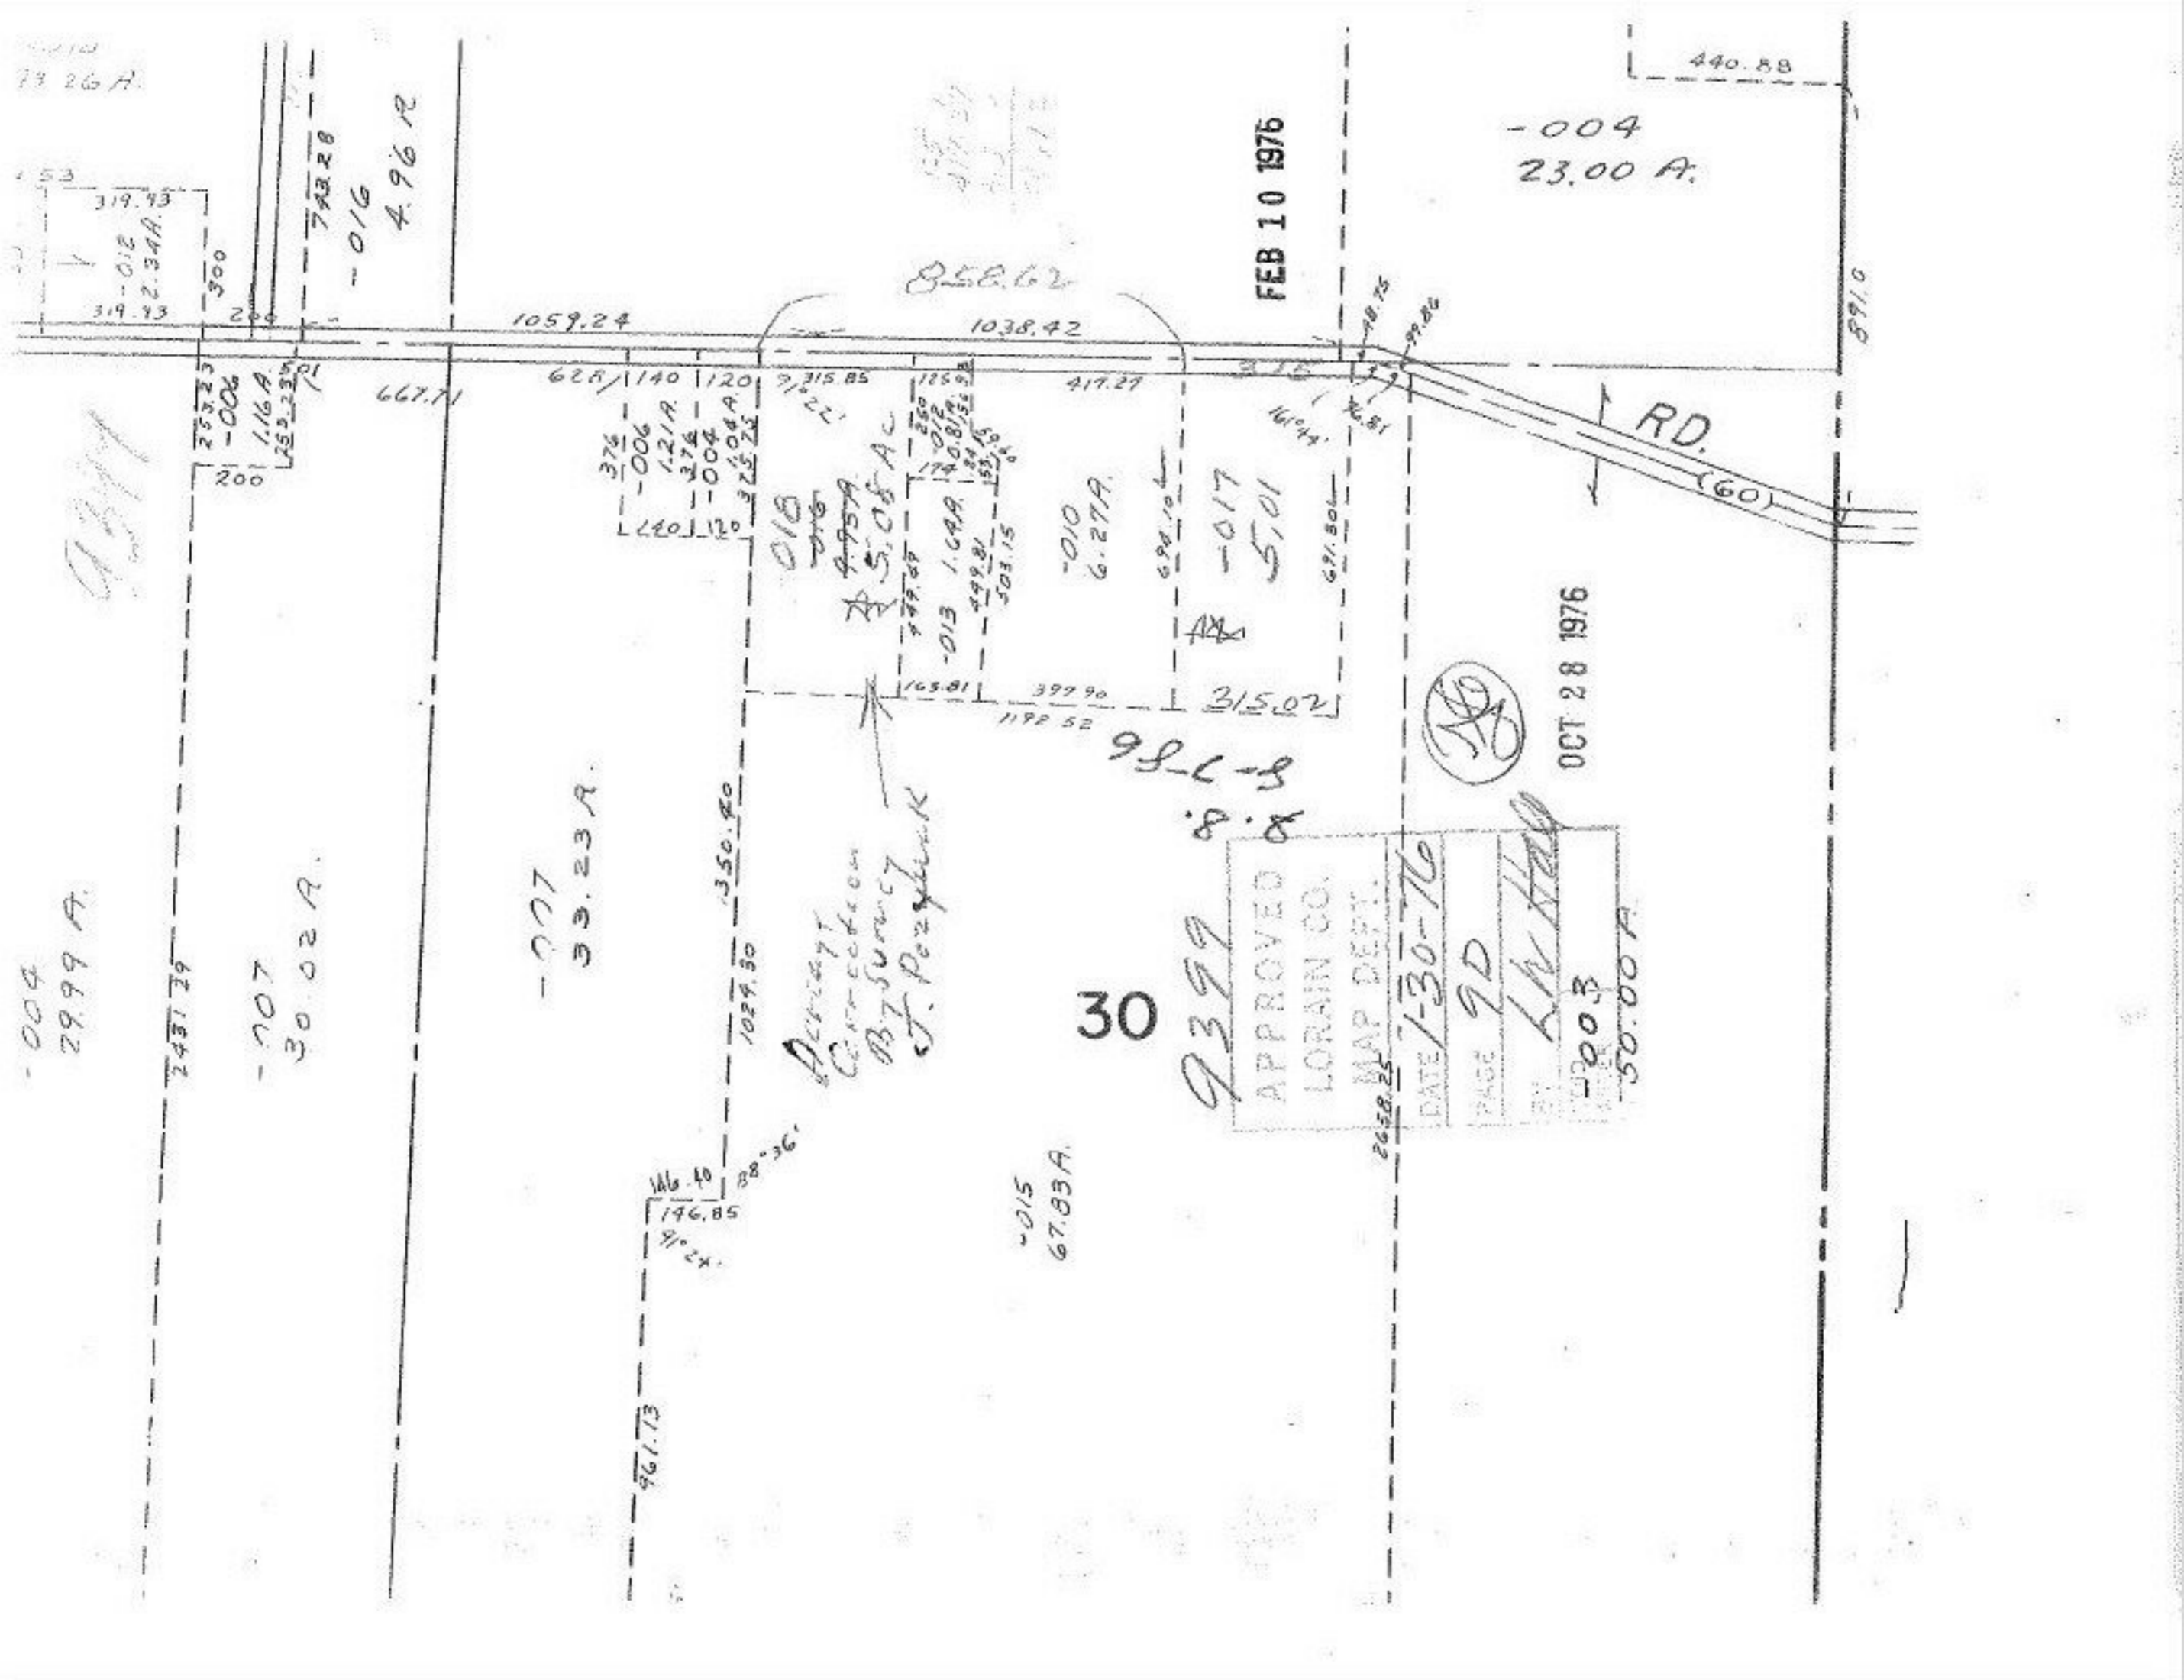

23 26 A.

440.88

891.0

1059.24

1038.42

667.71

628.140 120

9.315.85

417.27

253.25
-006
1.16 A.
253.23501

376
-006
1.21 A.
374
-004
1.04 A.
325.25

018
018
4.95 A.
5.08 A.C.

125
012
1.08 A.
1.52 A.
1.24
1.53
503.15

-010
6.27 A.

-017
5.01

691.80 A.

105.81 399.90
1192.52

315.02

2437.39

1029.90 1350.40

166.40
196.85
32° 36'

961.73

2658.25

78.75
99.86

558.62
155
414.57
413
417.12