

SEE 4-0

1921

9401


9401

APPROVED
LORAIN CO.
MAP DEPT.
DATE 1-30-76
PAGE 4-00-015
BY L. A. Hall
VOID AFTER

4-23-76

FEB 2 1976

-061
31.48 AC

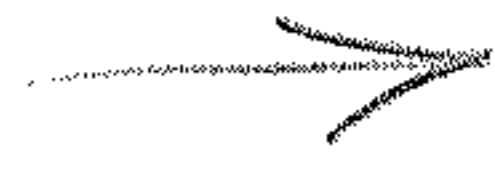


061
~~032~~
31.94 A.
31.48 AC

185740

100
746.44

LAKE 72856

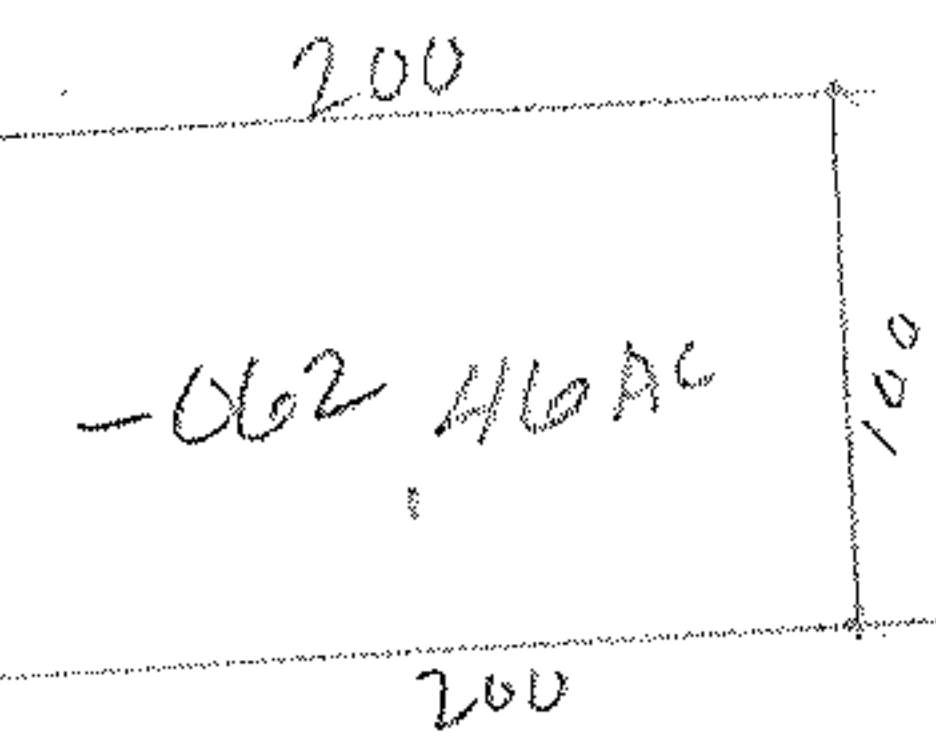

167475

SEE 4-0