


946th ST. 110

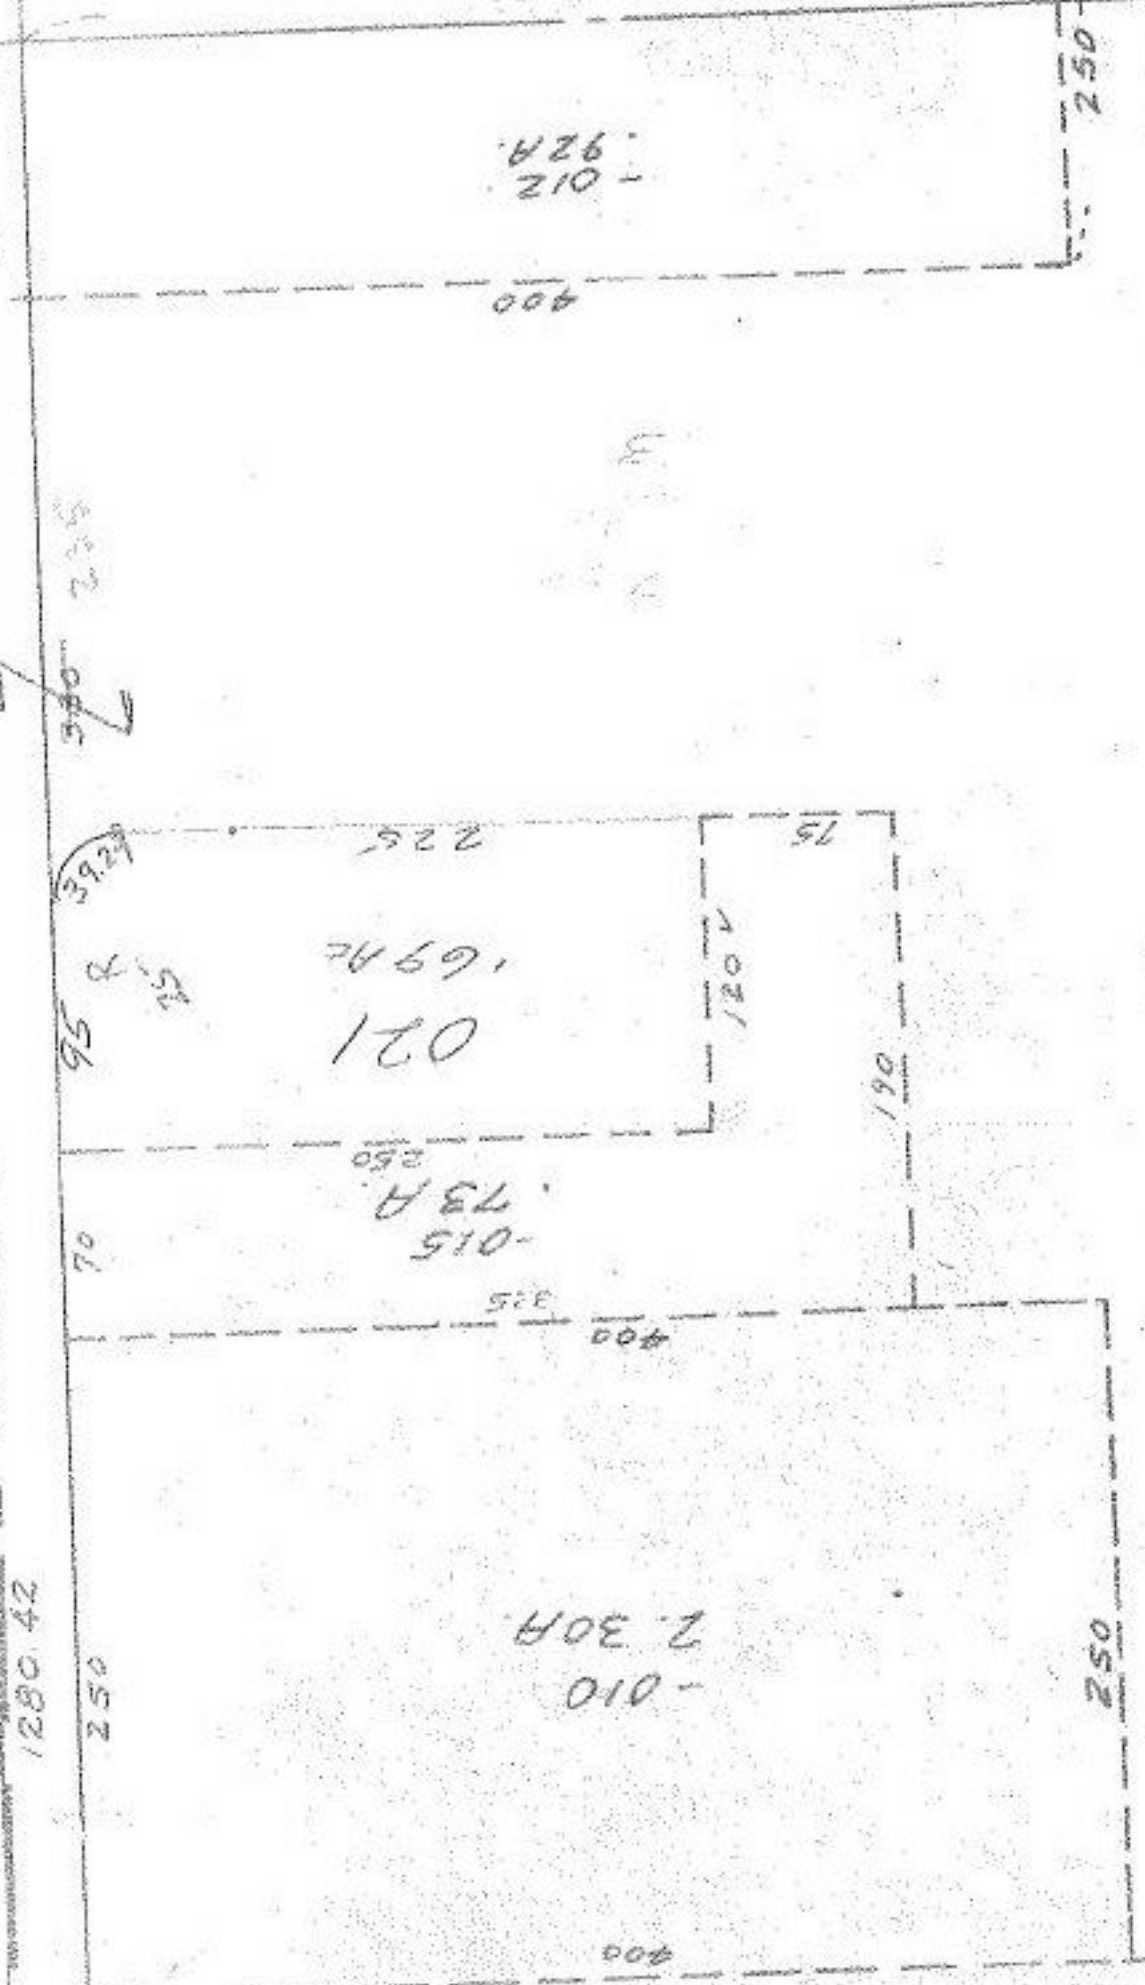

MAR 2 1976

022  
12.08 AC  
~~016~~  
~~12.77A.~~

MAY 20 1977

*[Signature]*

9402

APPROVED
LOGRAIN CO.
MAP DEPT.
DATE 1-30-76
PAGE 3-00-053 A
BY L.W. HALL
VOID AFTER

3.1.86  
P. 8

108