

94/43

FEB 20 1976


[Signature]
MAY 6 1971

SEE 2-F

332.67
21.86
354.53

338.69 Yorktown Rd

Oak Point Rd

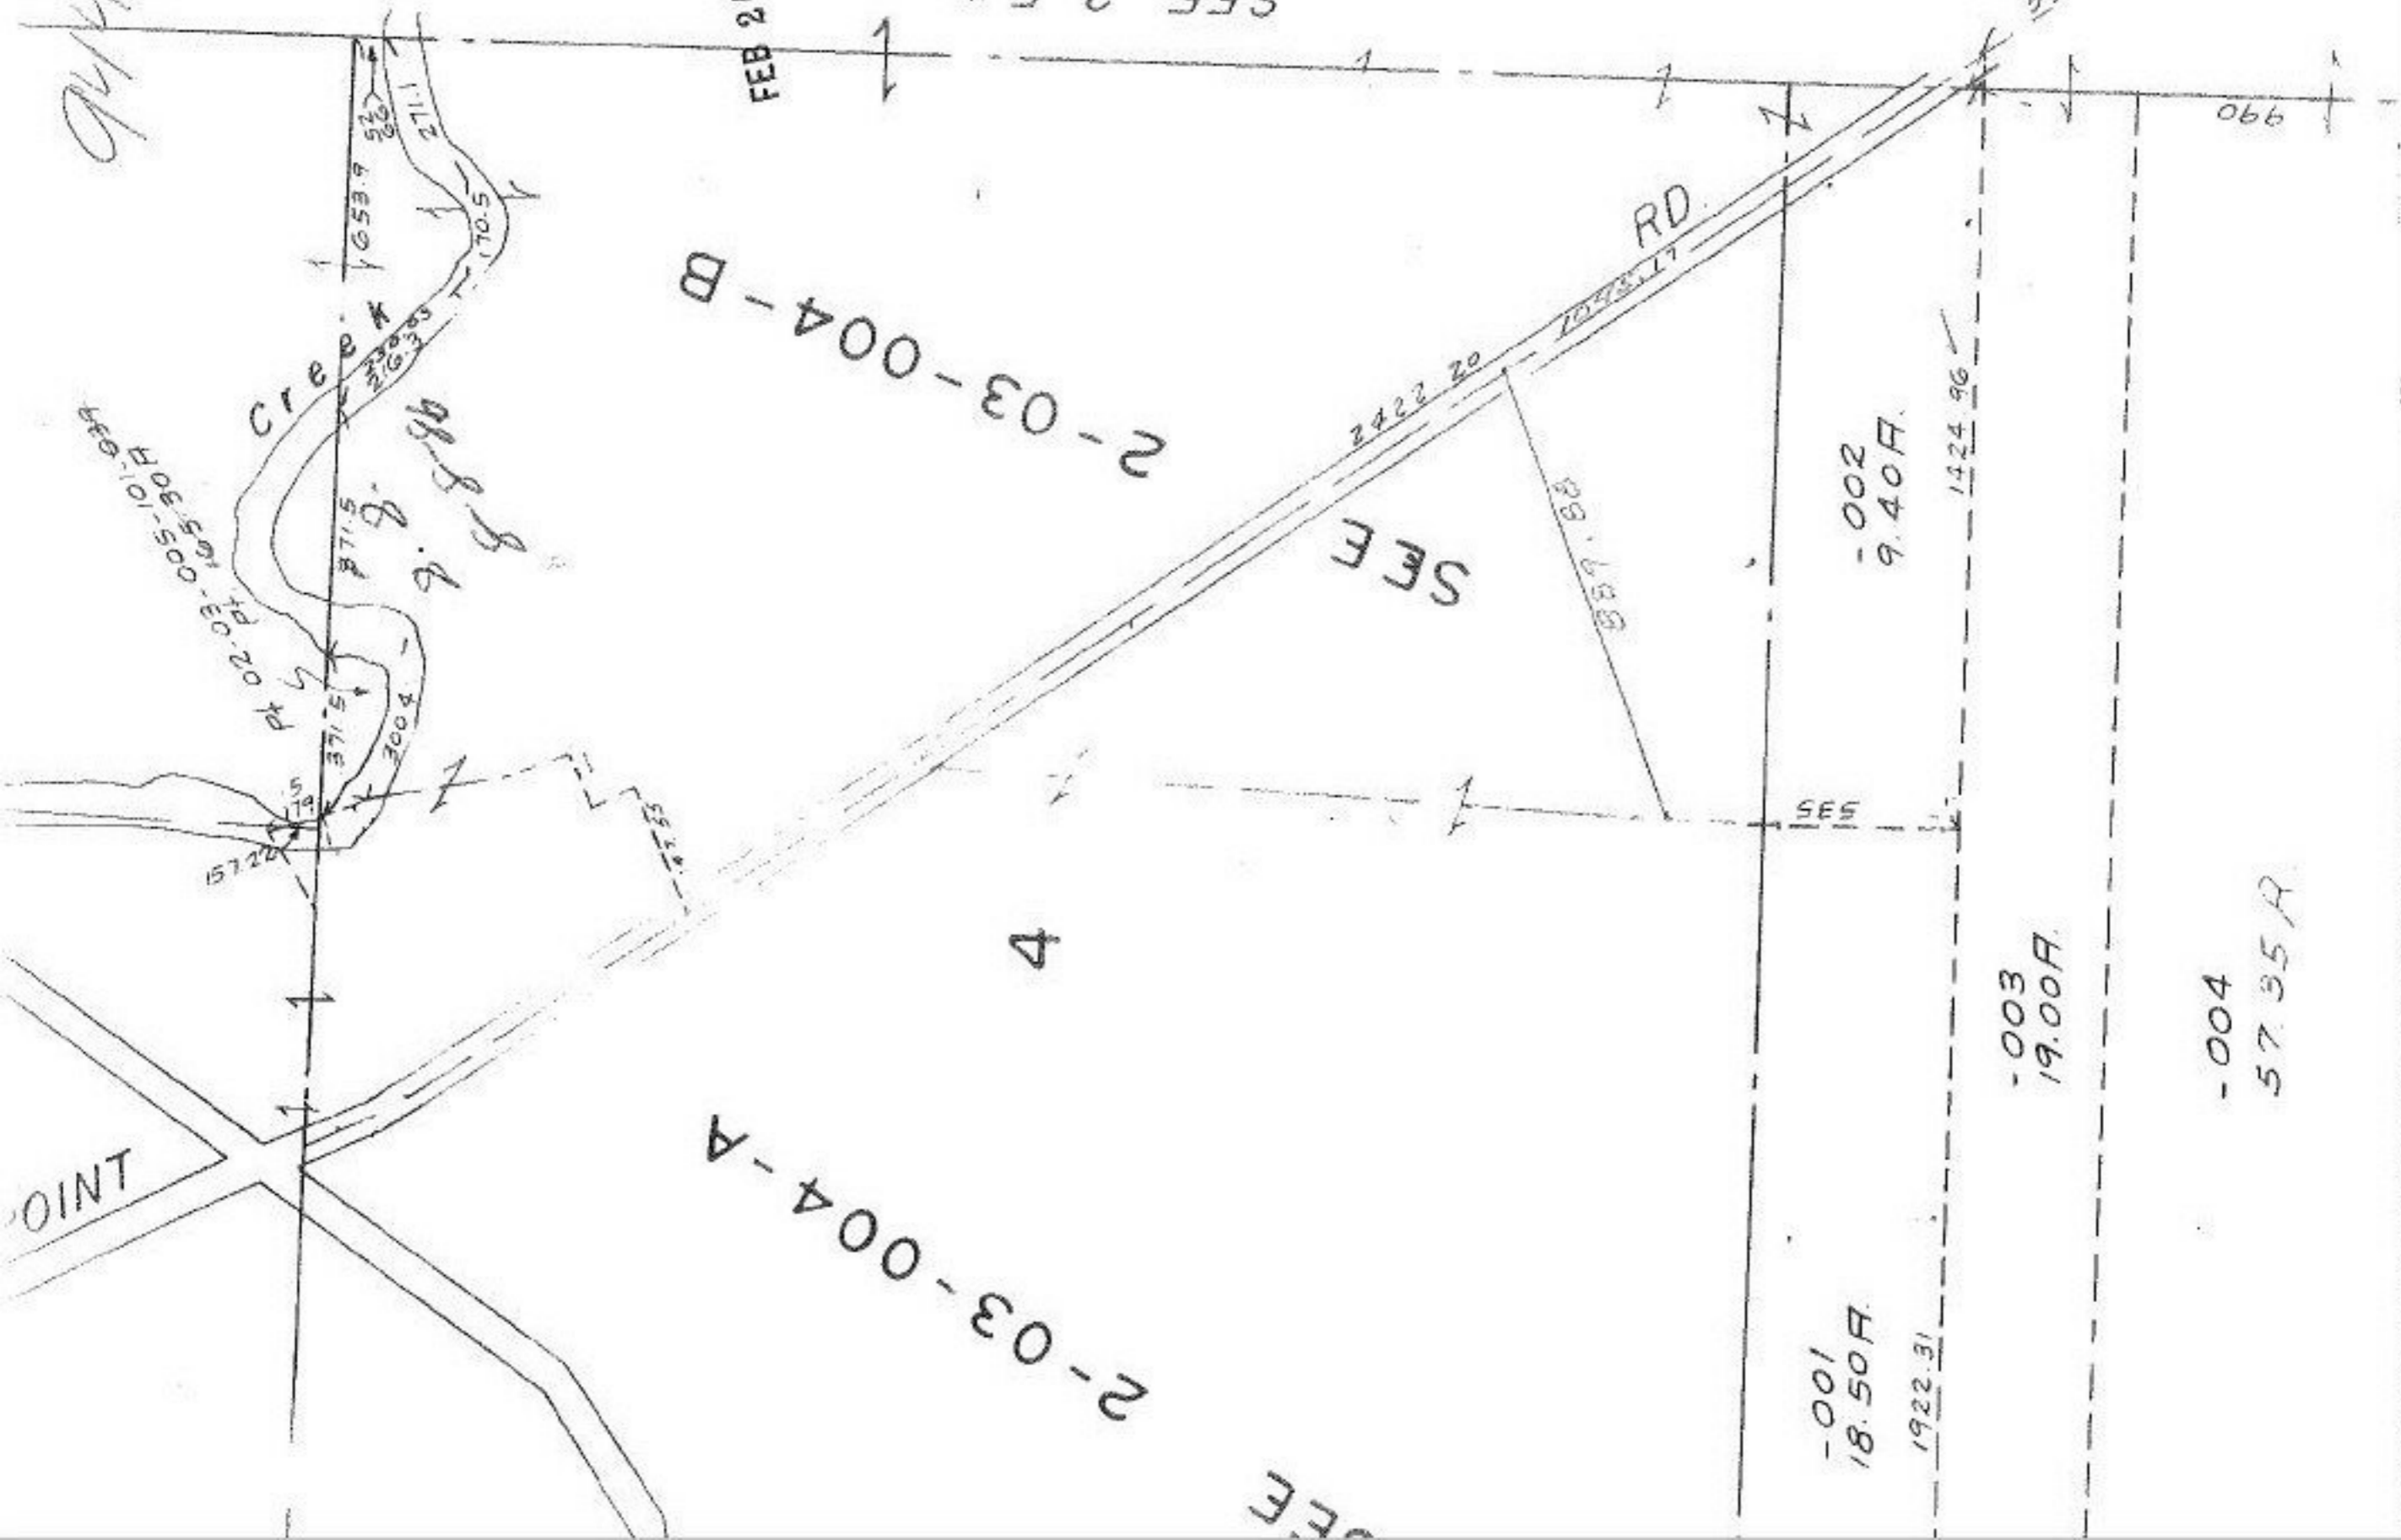

2-03-004-B

SEE

2-03-004-A

-001
18.50 A.

1922.31

-002
9.40 A.

1424.96

-003
19.00 A.

-004
57.35 A.

990

POINT

4

SEE