


9473

SEP 10 1976



9473

APPROVED
LORAIN CO.
MAP DEPT.
DATE 3-10-76
PAGE 16C
BY L. W. HARRIS
VOID AFTER

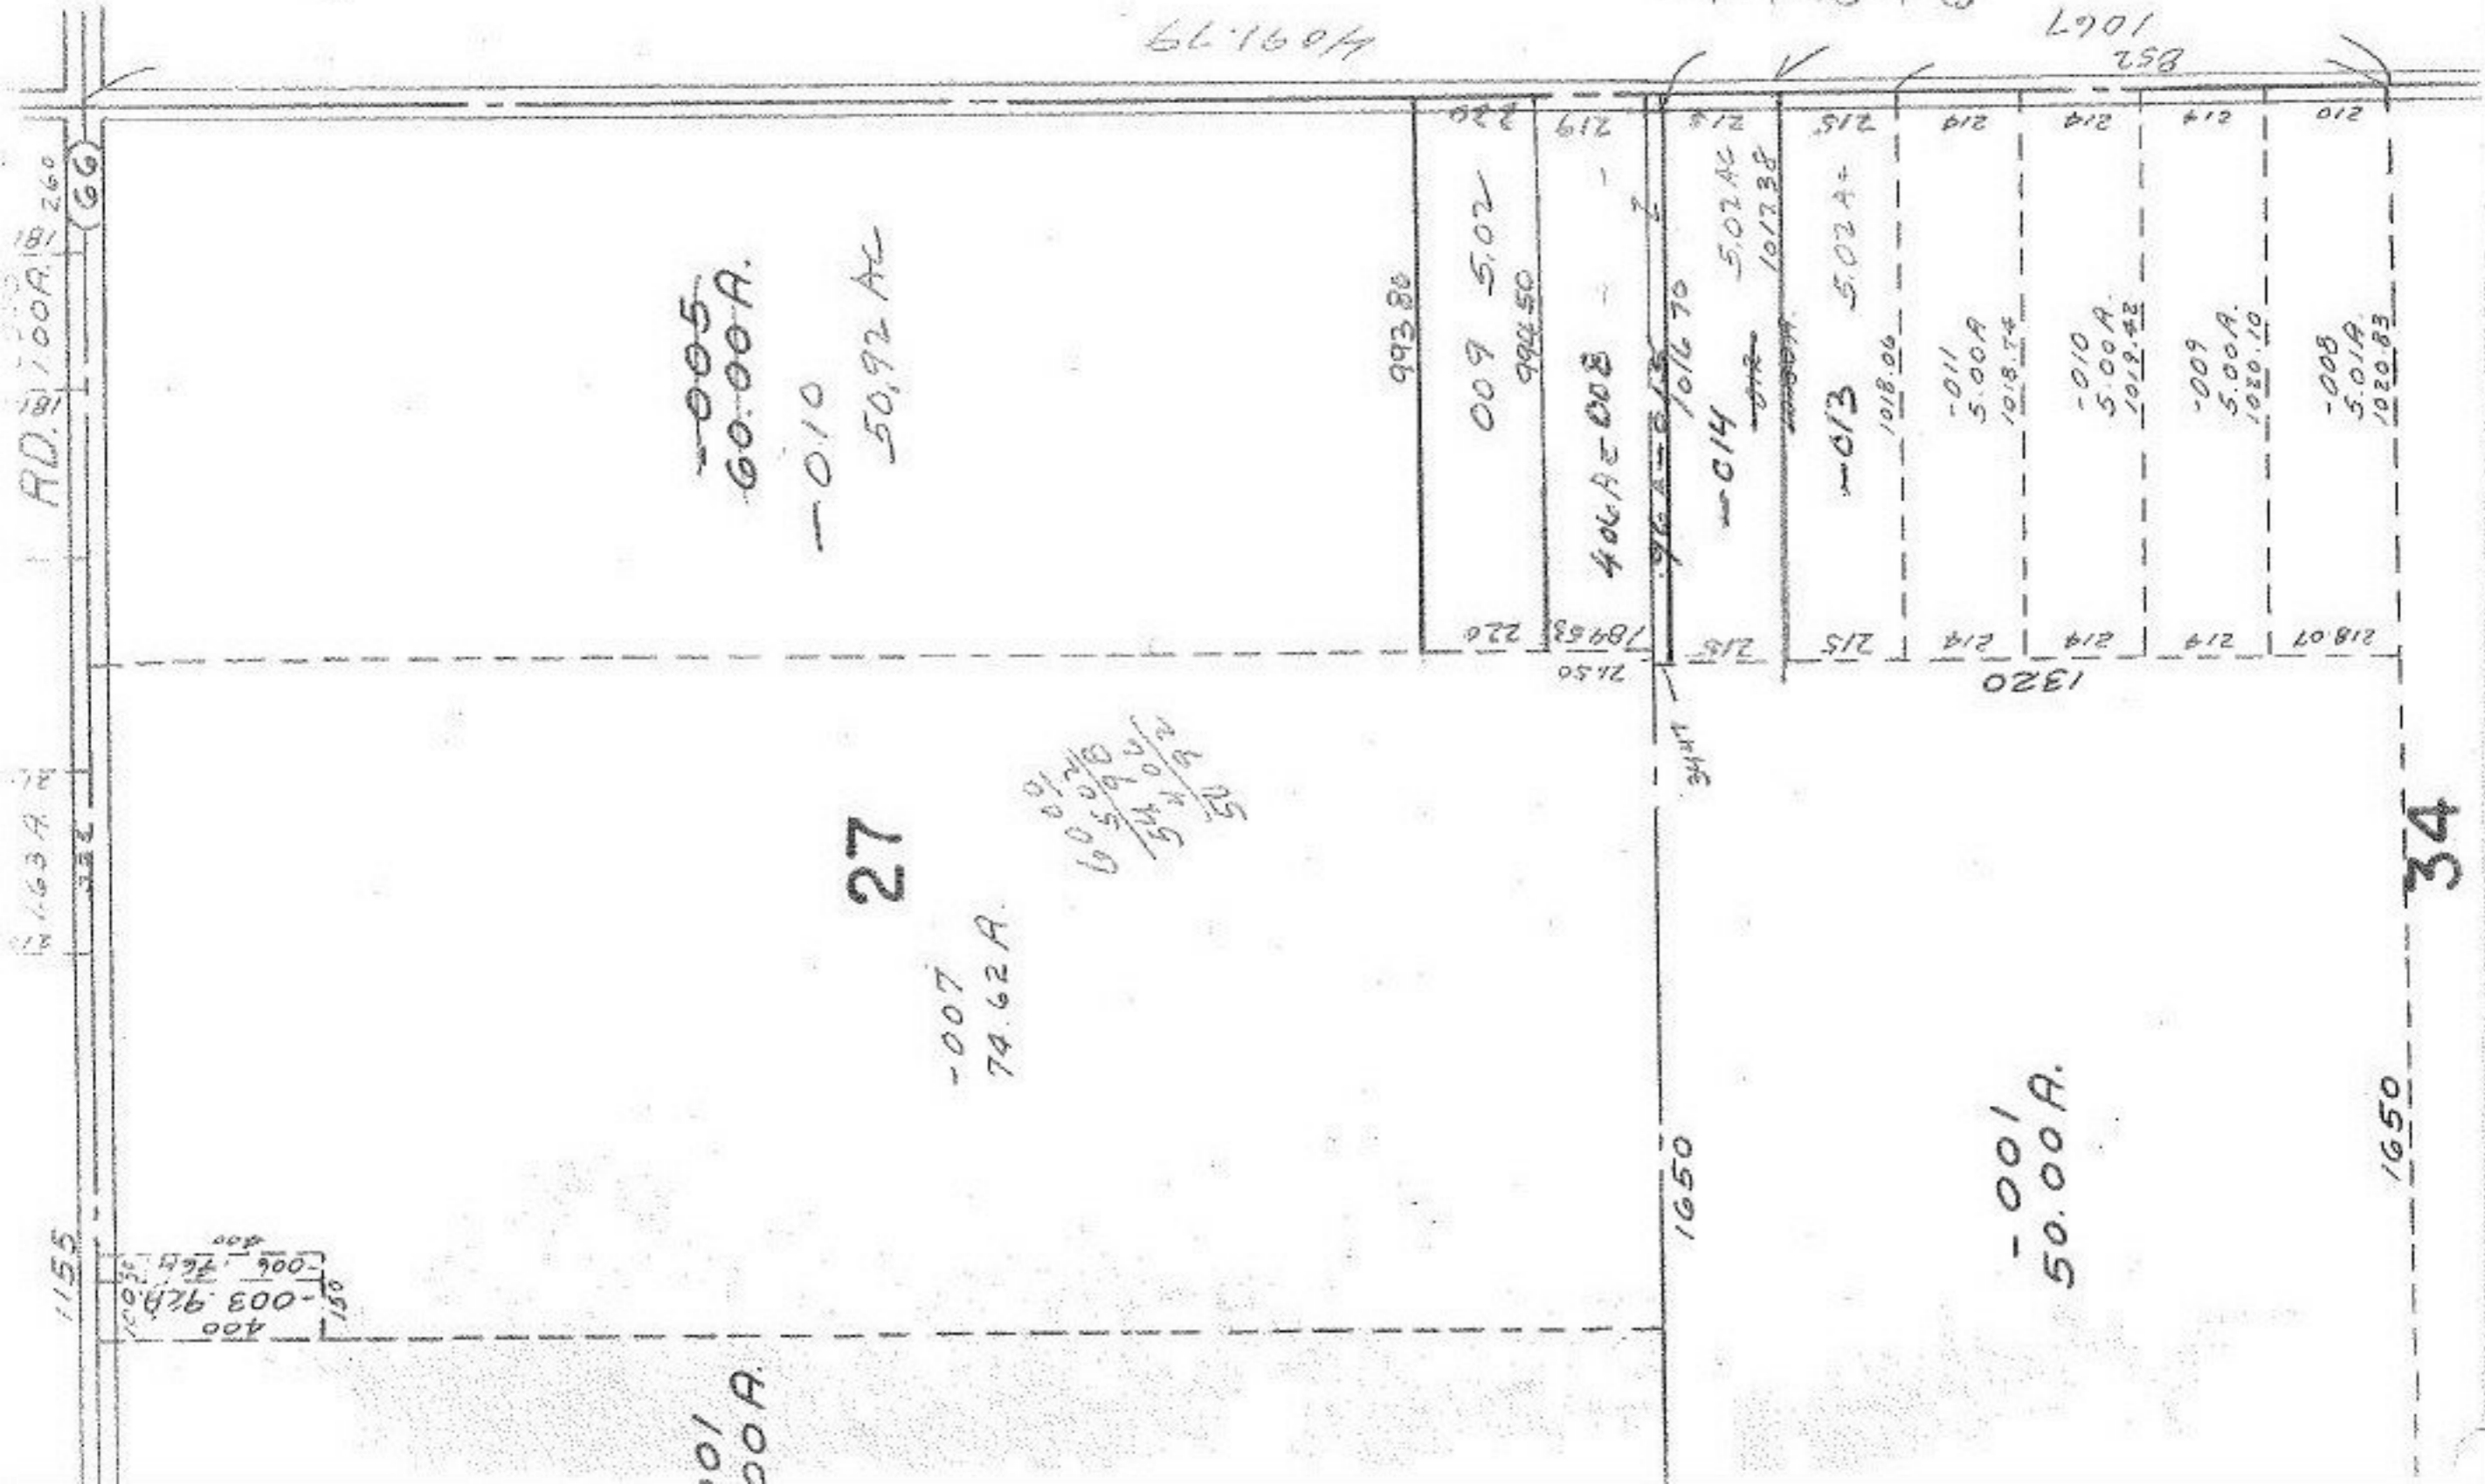

34

1650