

9481

1621.30

0L11

0L4

MAR 24 1976



OCT 28 1976

-027

11.09 A.

147.93
12.25
135.68

50

RD.

1620.63

~~033~~ 038
14.23 A. 13.28 Ac

372.93
- 240.92
132.01

9481

APPROVED
LORAIN CO.
MAP DEPT.


DATE 3-15-76

PAGE 9-00-004 A

BY LTV Hall

VOID
AFTER

8-4-80
8-4-80

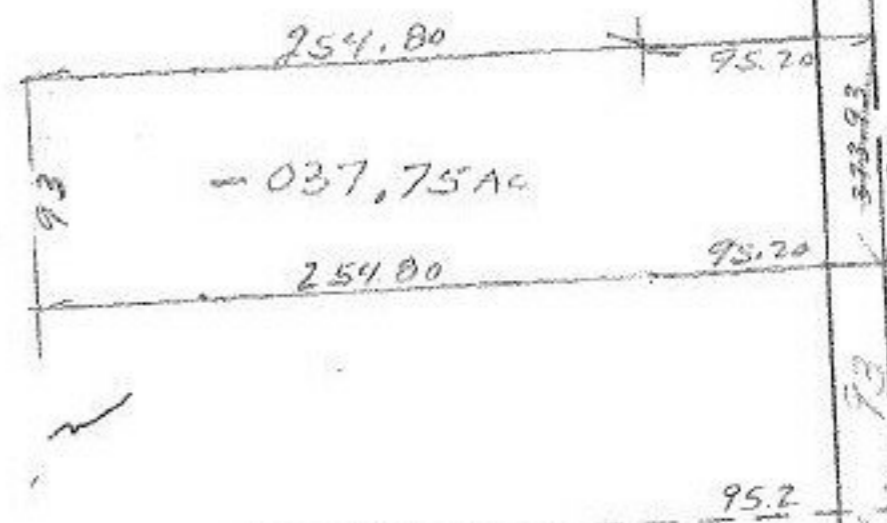

1488.6

93
35
1465
279
3256

254.8
95.2
350.0

156

226
35 A

93
93
93