

-012
7.20 A.

522.08

219.15
216.45
-009
.65 A.
88°18'30"
130.75

9496

91°25'

462.12
357.75

Cemetery

-010
3.8 A. Pl.

679.20

216.45
216.80

1360.50

~~Pl. 011~~
~~DT. 011~~
~~120.60 A~~


022
14.20 AC

023
106.40 AC

9496

APPROVED LORAIN CO. MAP DEPT.	
DATE	3-23-76
PAGE	21-06-000A
BY	LW Hall
VOID AFTER	

AUG 27 1976

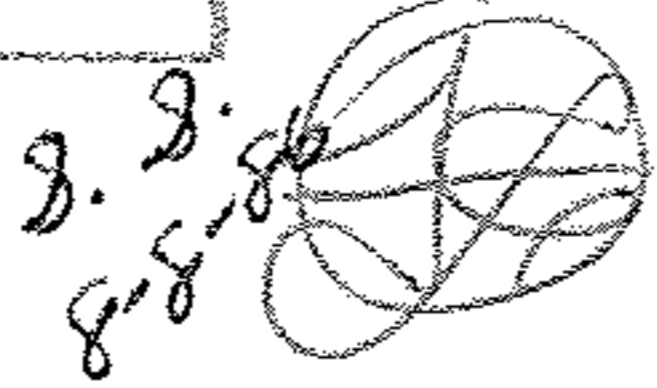

MAR 31

ASHLAND BERLIN

231V
-013
90 A.

261
-01
.42 A.

161
-01
.55 A.

-016
.44 A.

-017
1.04 A.

-018
1.65 A.

162

NEW LONDON LAFAYETTE

HUNTINGTON TWP.

SCALE: 1" = 100'

-A