

SOUTHEAST

9572

197+03.50  
801  
108

037  
~~035~~  
17.57 A.  
16.88 AC

PI 7957+25.21  
A 340-35'-45"  
D 1°-30'  
T 1189.56  
L 2306.39  
E 180.94


383  
377.13

1927.54  
1200.96  
110

4-27-76  
GWA

9572

APPROVED	
LORAIN CO.	
MAP DEPT.	
DATE	4-27-76
PAGE	6-143
BY	L. W. Hall
VOID AFTER	

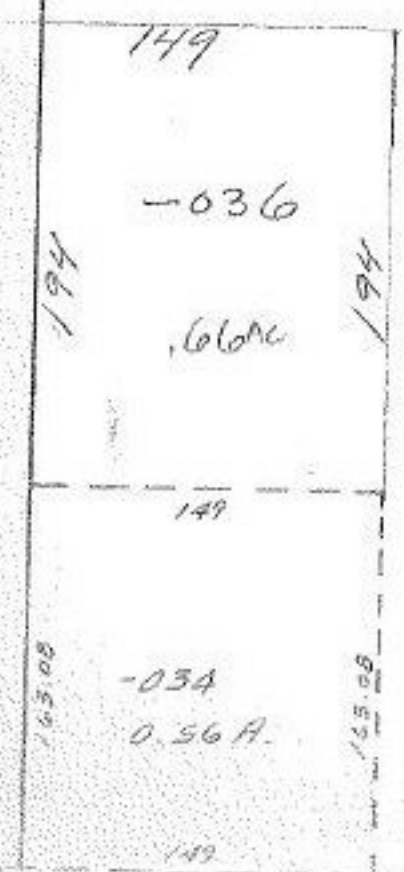

795.72  
-032

SEE 0-17A2