


95-86

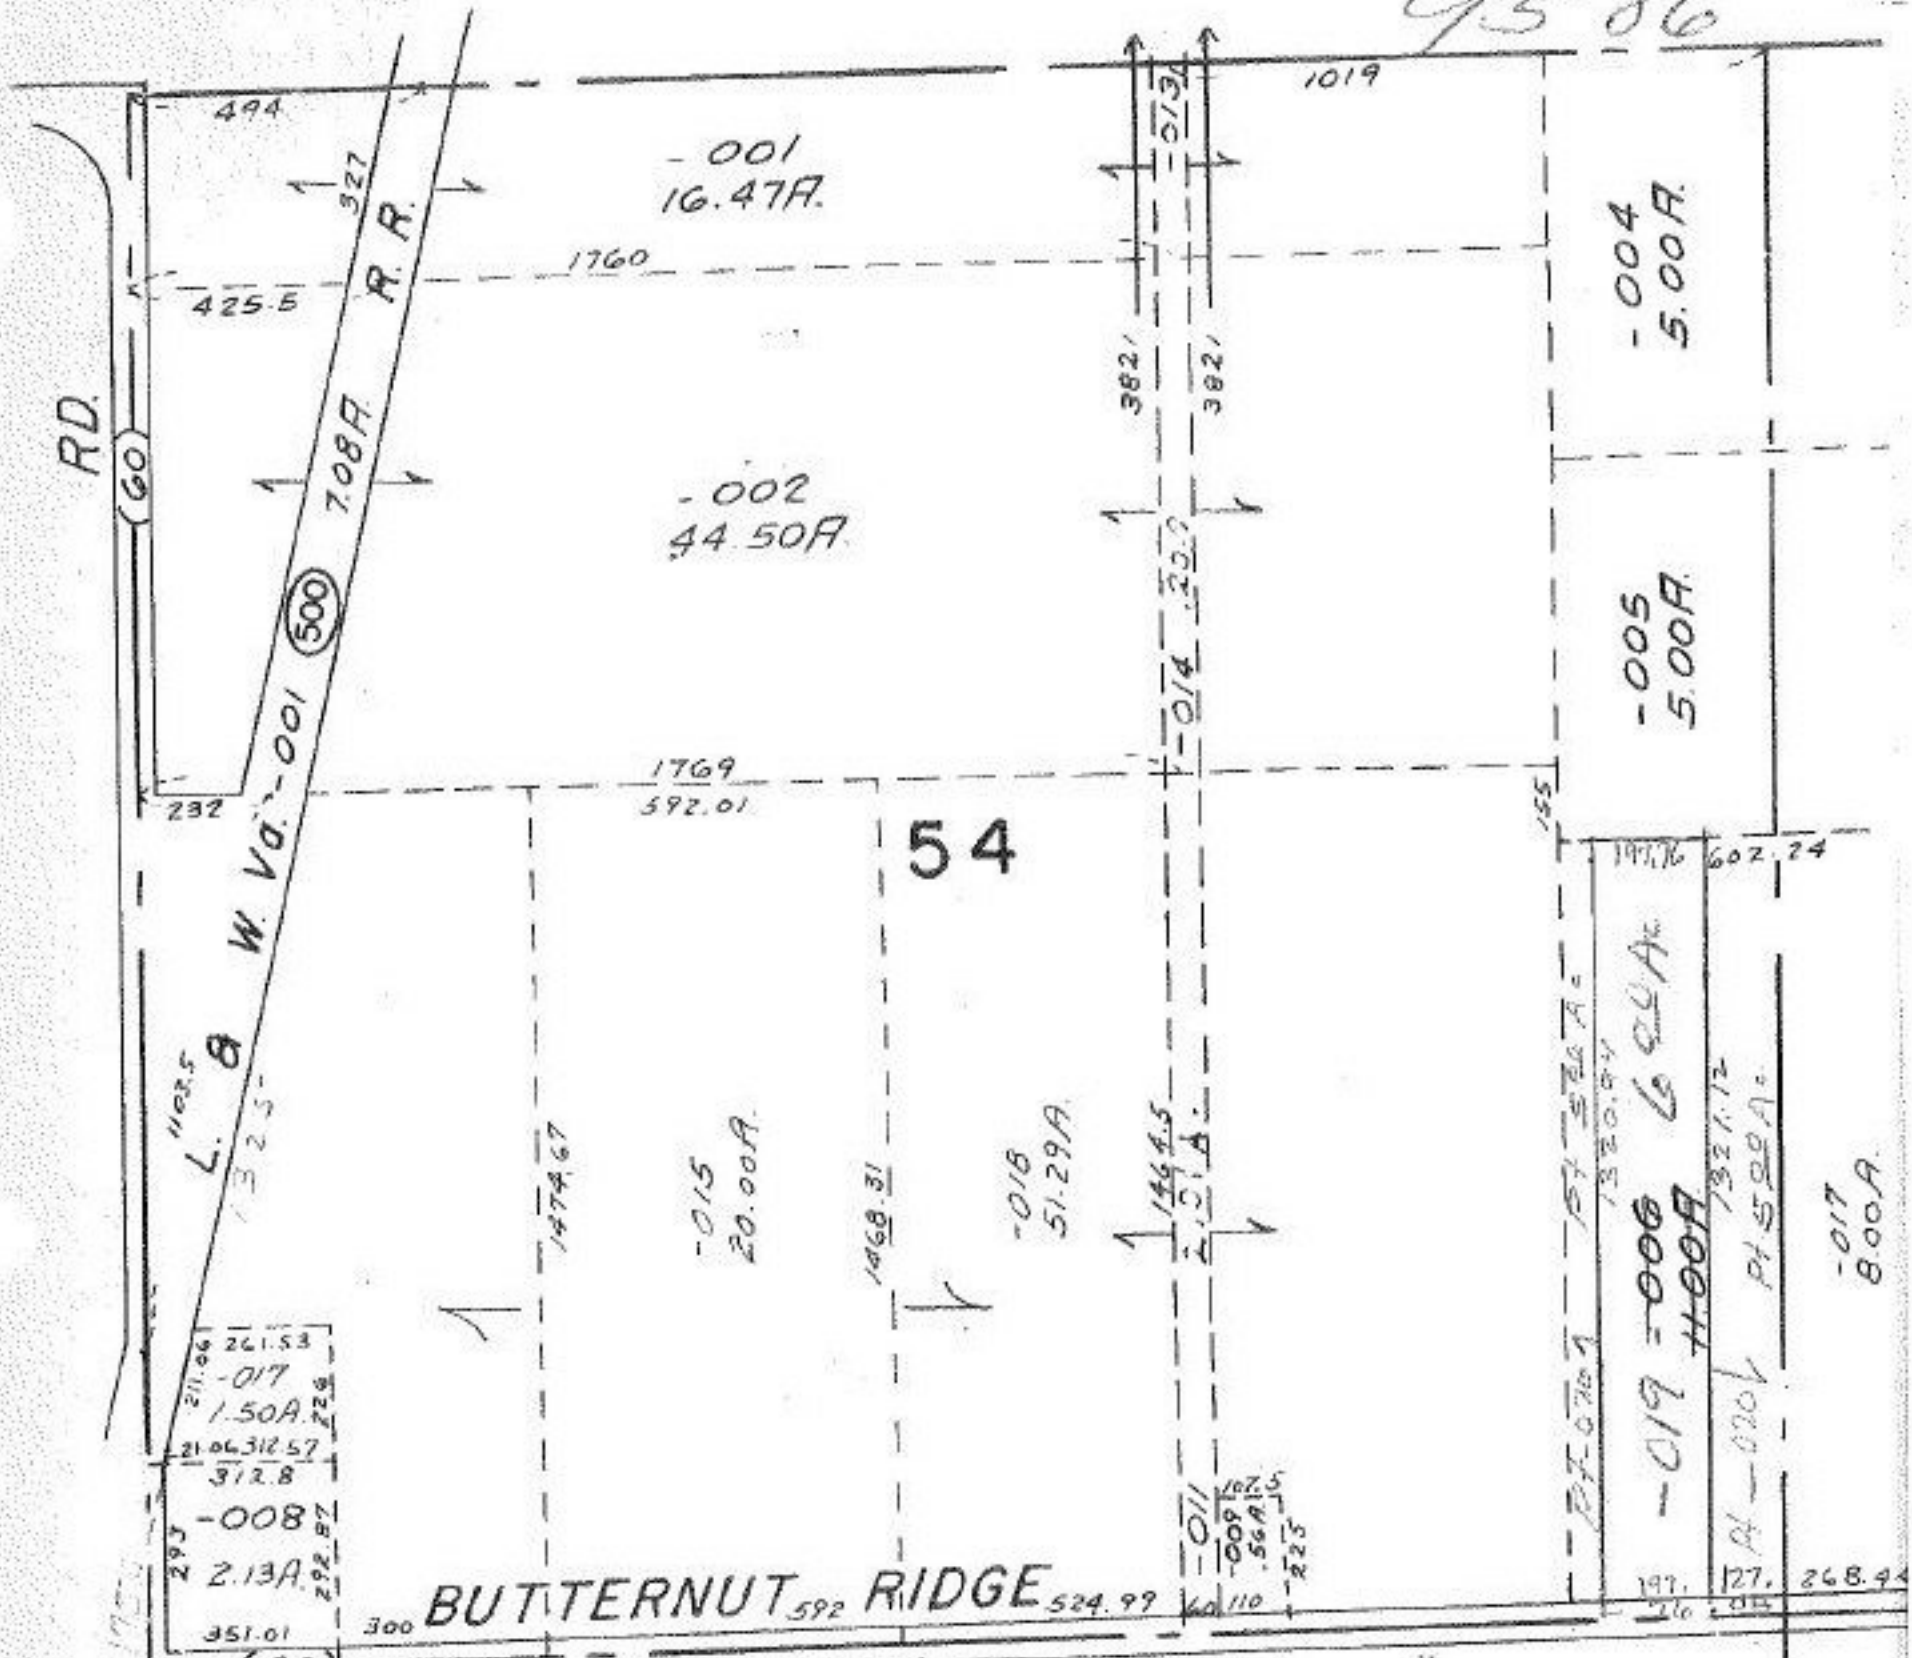

MAY 10 1976

APPROVED	
LORAIN CO.	
MAP DEPT.	
DATE	5-6-76
PAGE	9-F
BY	G W Hall
VOID AFTER	

OCT 28 1976

00-064-A

00-064-B

64