


9593

01-00-073-000-011

3.60 AC


900

547.80

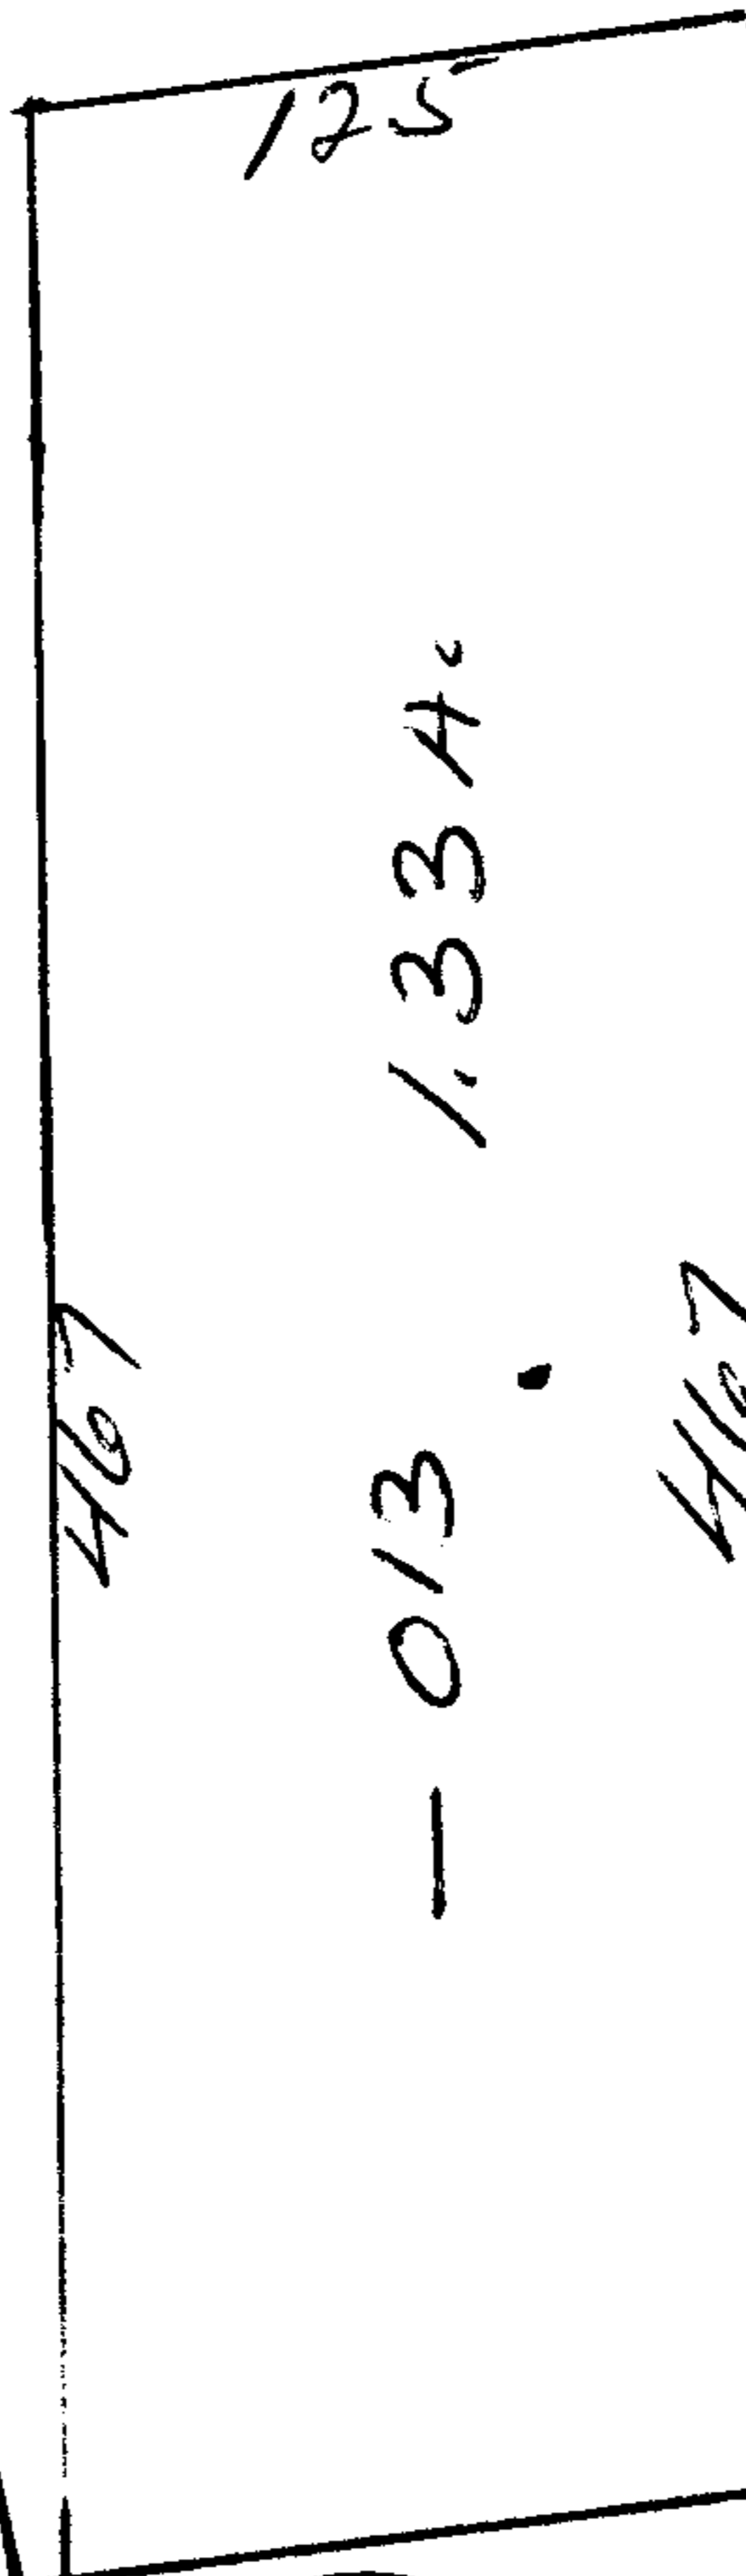

Pt 014
Pt 36.18

MAY 12 1976

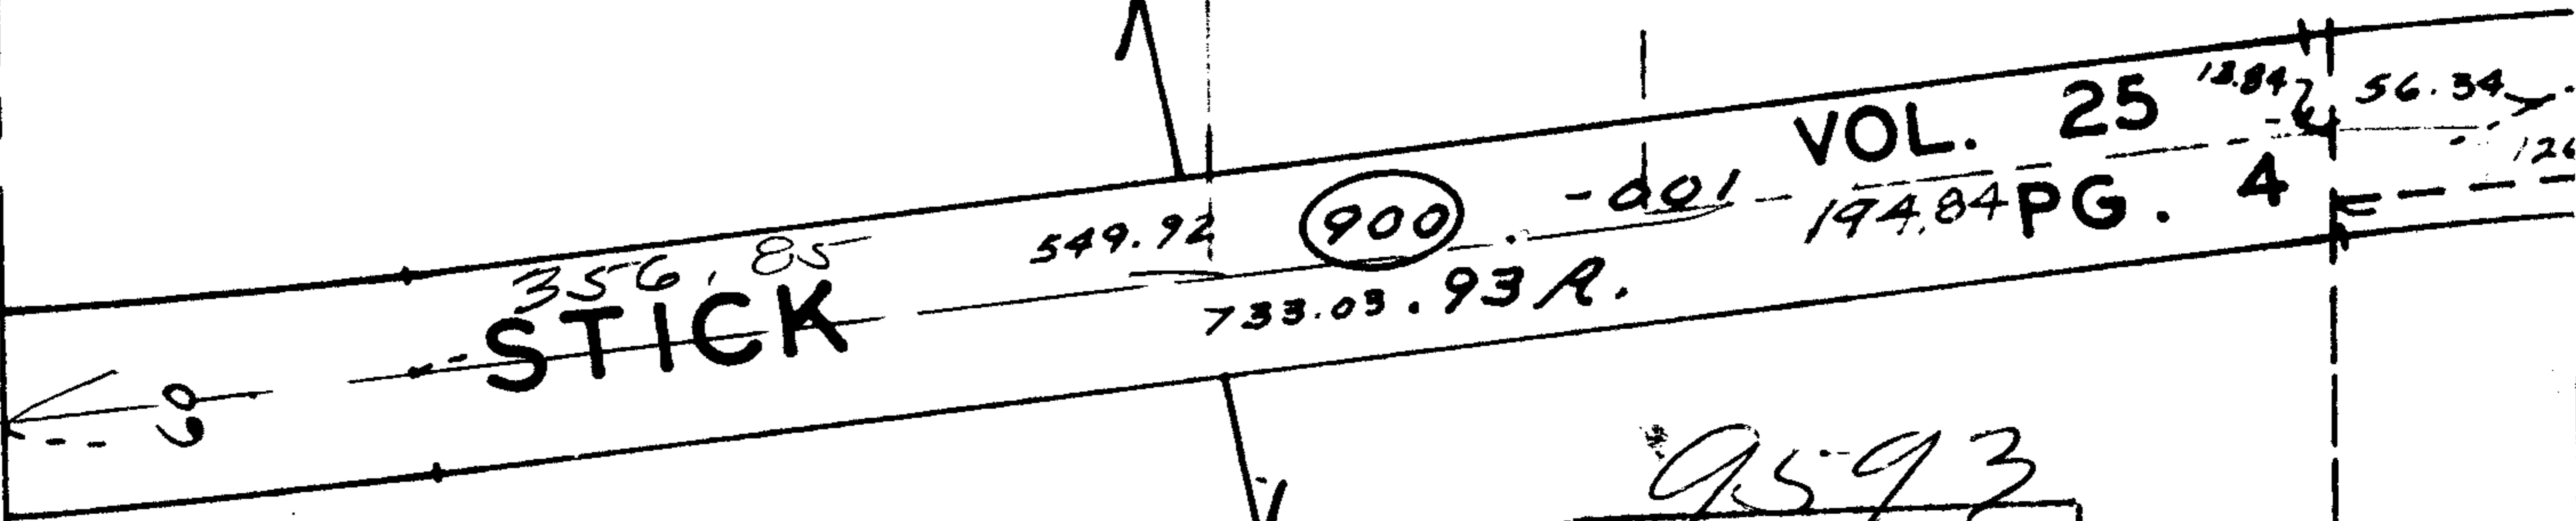

[Signature]

APR 1 1977

APPROVED	
LORAIN CO.	
MAP DEPT.	
DATE	5-7-76
PAGE	1-00-073
BY	LW Hall
VOID AFTER	

[Handwritten initials]

~~012~~ - 014

~~37.51 AC~~ 36.18 AC

-074-B

999.20