

ER 807.28


9612 RD. 560 (X)

25 52  
24 25  
14 23



-016  
77.69 A.

12

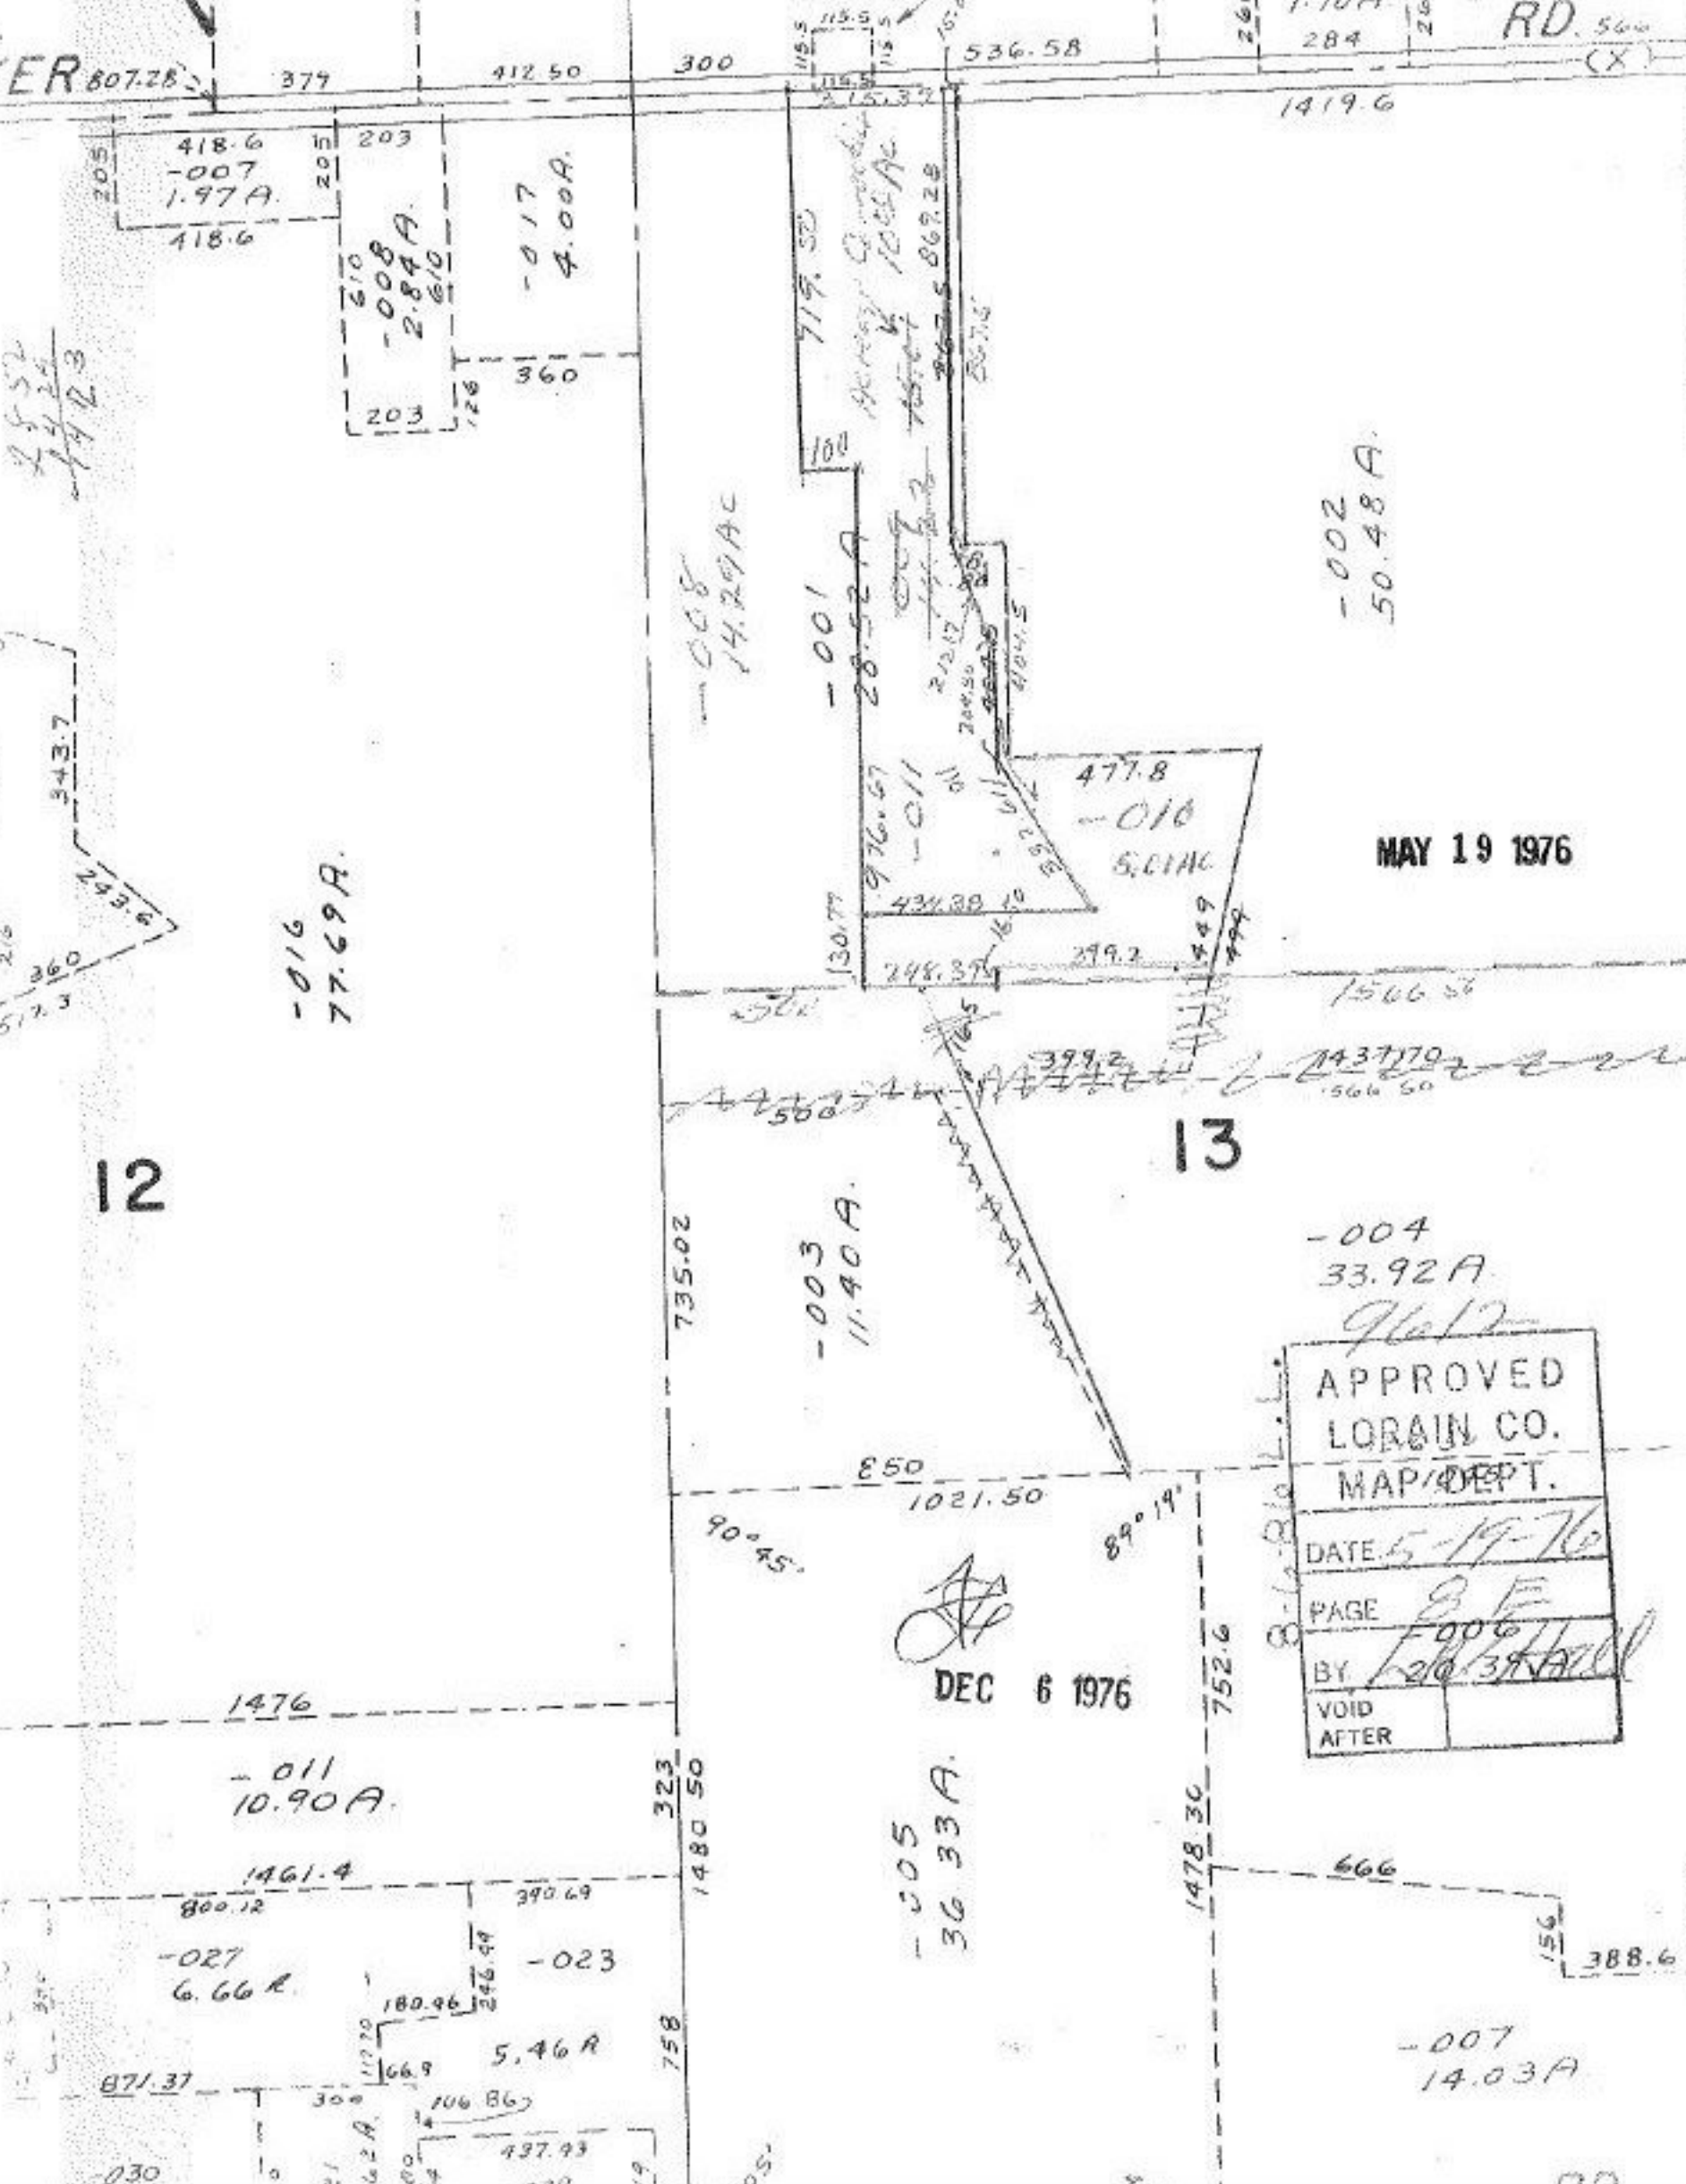

MAY 19 1976

13

APPROVED  
LORAIN CO.  
MAP DEPT.

DATE 5-19-76

PAGE 3 E

BY [Signature]

VOID AFTER

DEC 6 1976

BAIRD

RD