

LATTASBURG - ELYRIA

- 001
50.00 A

SEP 10 1976



9632

APPROVED
LORAIN CO.
MAP DEPT.

DATE 5-25-76

PAGE 15-G

BY *J. Rollert*

VOID
AFTER


*26.41
5.5
21.41*

MAY 25 1976

- 002
50.00 A

95

7 7 98-07-8

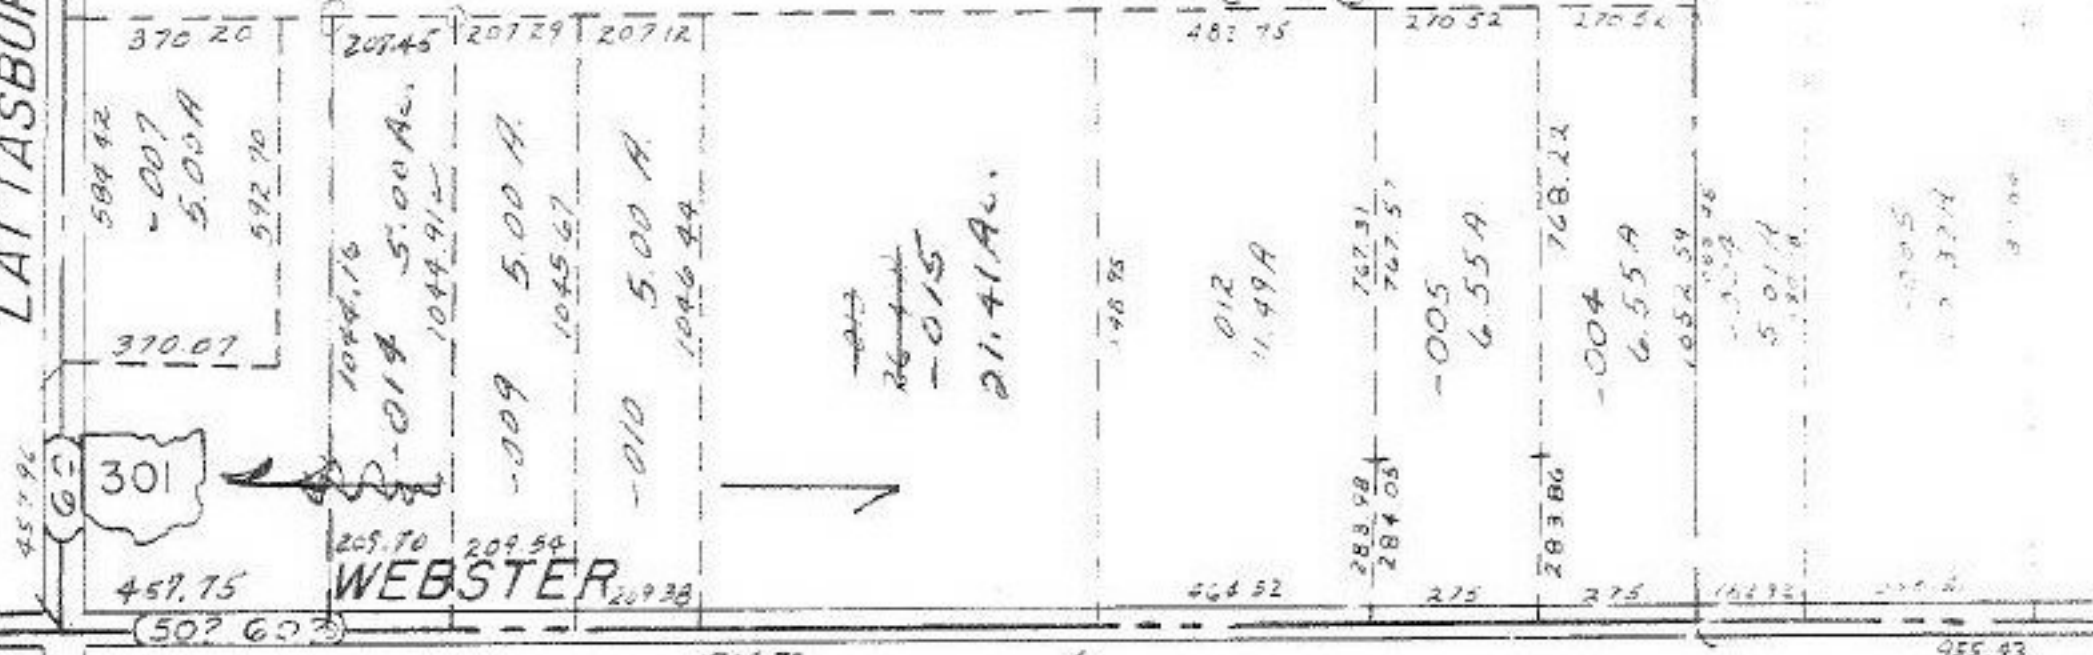

LAGRANGE TWP.

SCALE: 1" = 400'

LOTS