


26

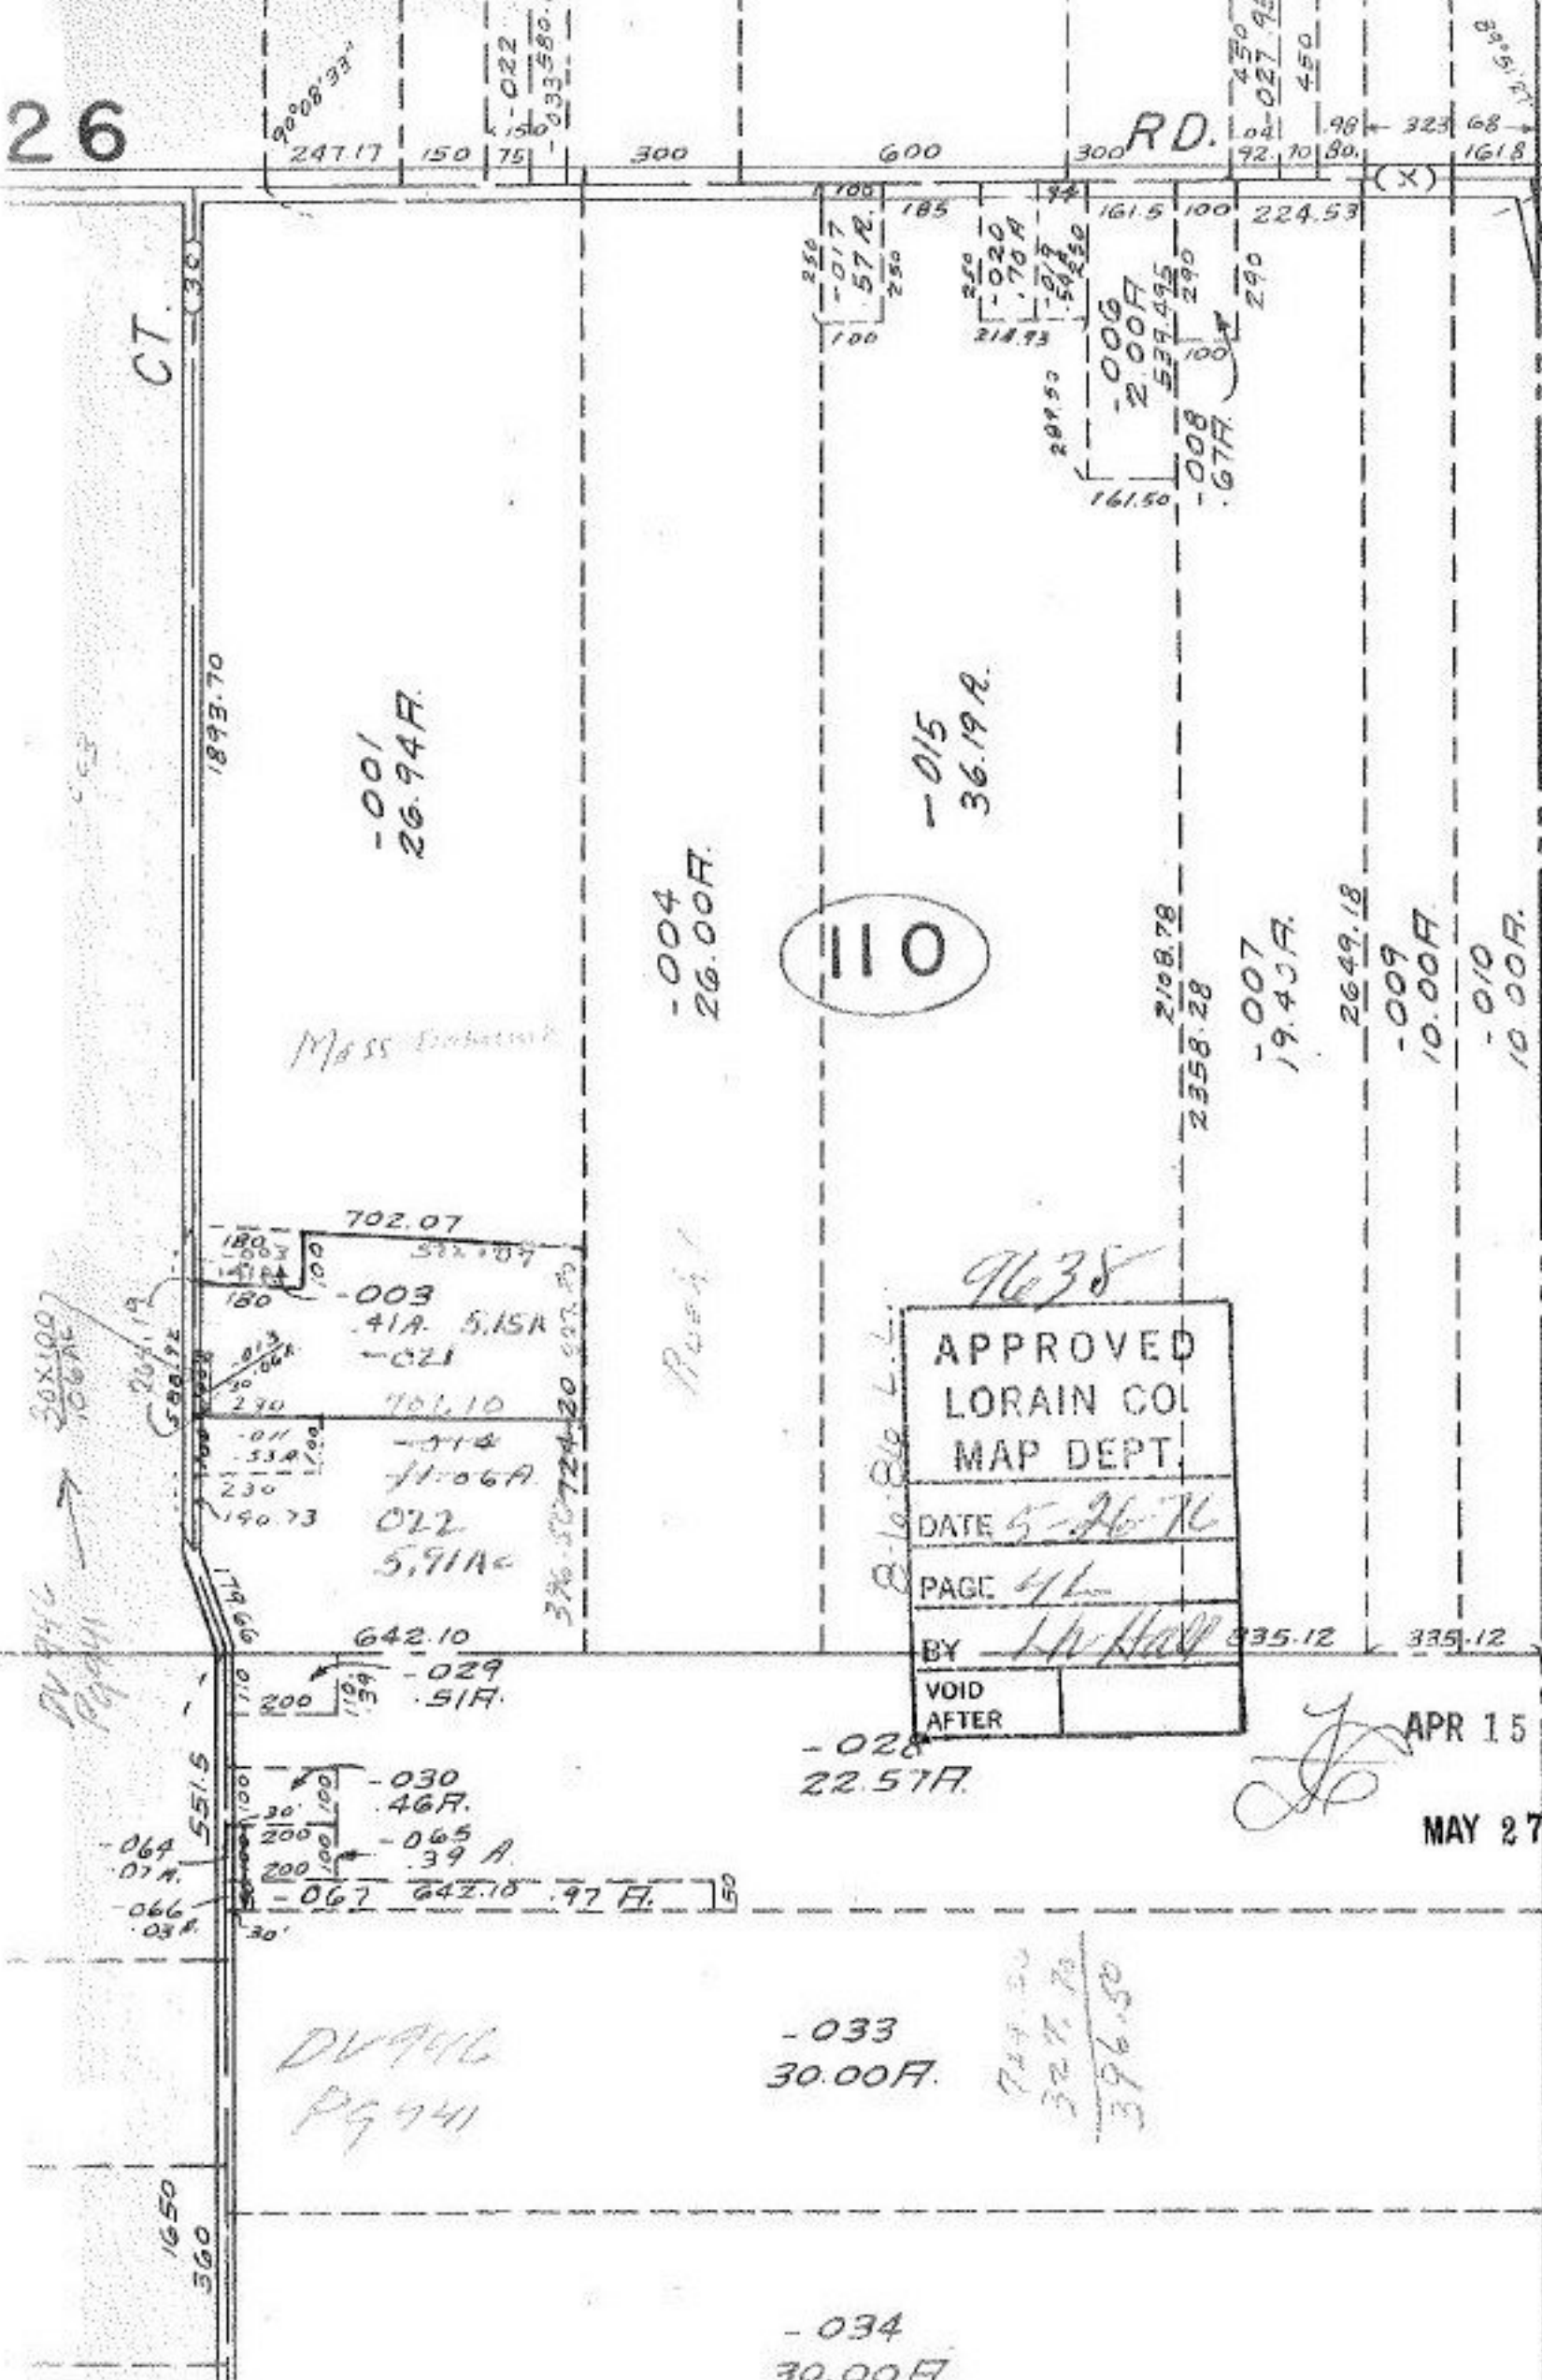

9638

110

APPROVED
 LORAIN CO.
 MAP DEPT.
 DATE 5-26-76
 PAGE 46
 BY L.H. Hall

APR 15 1977
 MAY 27 1976

-033
30.00F.

-034
30.00F.

DV9416
Pg 941

749.50
327.70
396.50

Mass Submittal

Push

DV 9416
Pg 941

30x100
1066A

1650
300

1893.70

CT.

RD.

247.17
150
75
-022
-033580.8

450
92.70
80
450
98
323.68
161.8

702.07
 180.03
 150
 -003
 41A. 5.15A
 -021
 701.10
 -011
 53A
 230
 190.73
 179.66
 642.10
 110
 200
 110.39
 -029
 51A
 -030
 46A
 30
 200
 -065
 39A
 -064
 07A
 200
 -066
 03A
 30
 -067
 642.10
 97A

-004
26.00F.

-015
36.19A.

-007
19.43A.

-009
10.00F.

-010
10.00F.

2108.78
2358.28

2649.18

8-16-86 L.L.

9638