

9658


APPROVED
LORAIN CO.
MAP DEPT.
DATE 6-4-76
PAGE 6-109
BY *Bovert*
VOID
AFTER

8-23-77 98

ANNEXATION DATA
COMM. RES. CITY ORD.
66-804 66-241

SEE 5-H

RD.

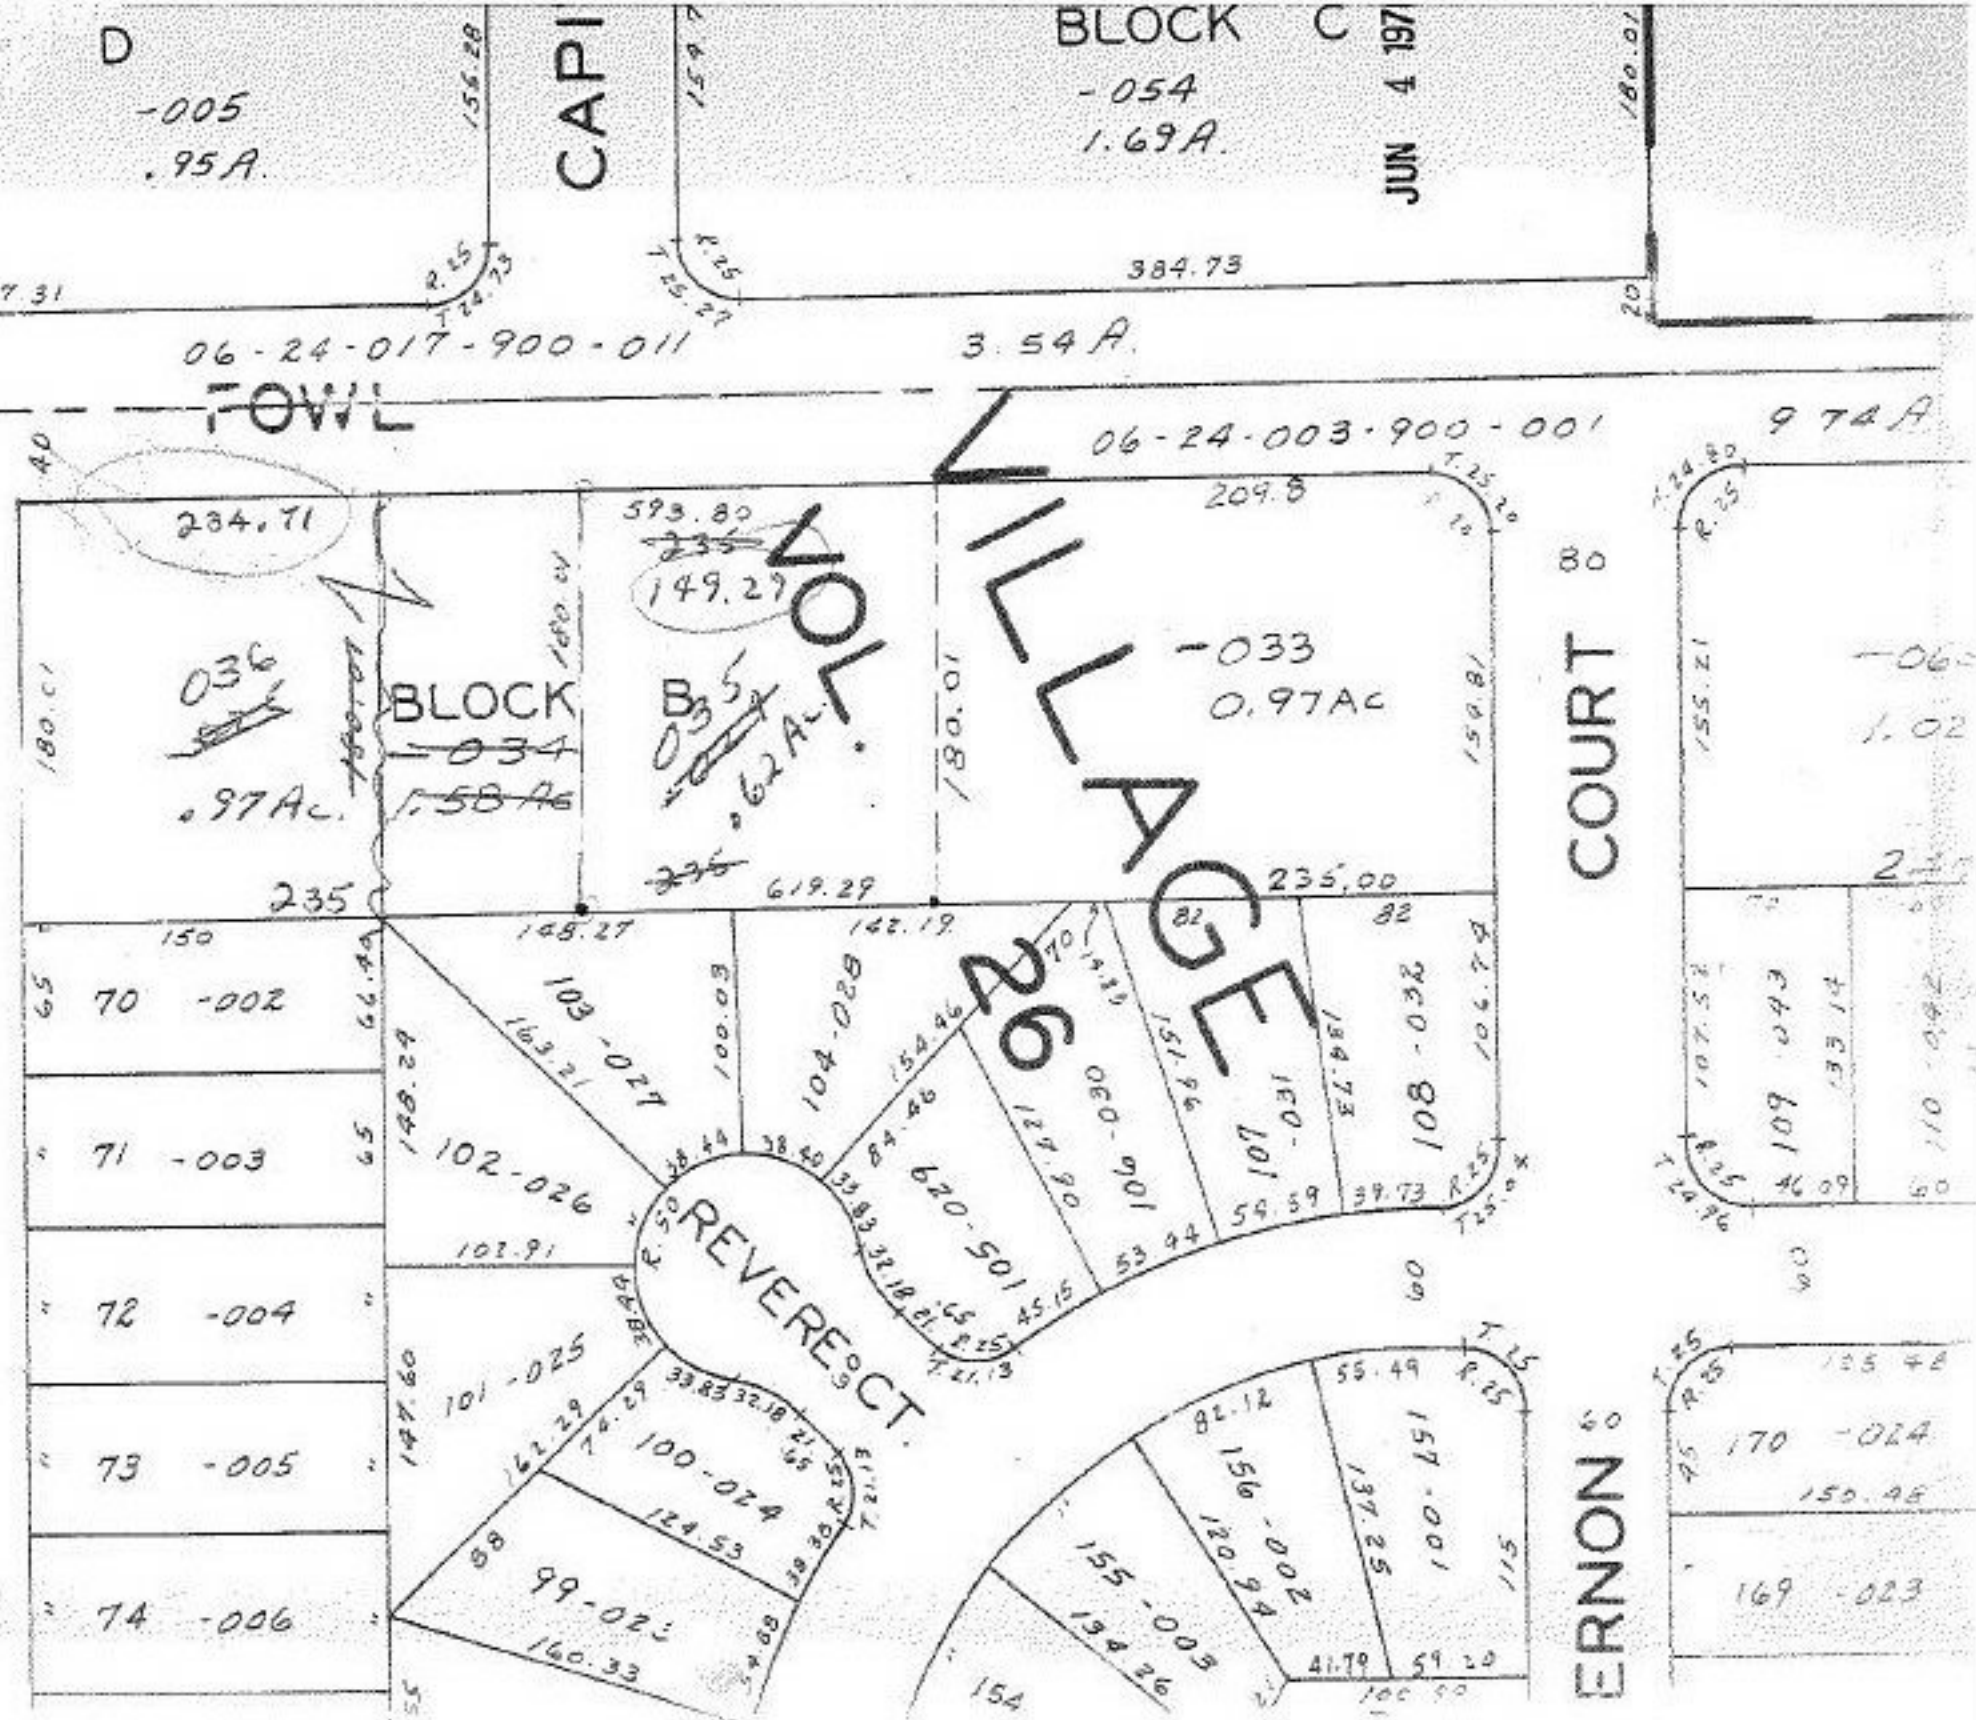

COURT

ERNON

JUN 4 197

CAPI

BLOCK C

D
-005
.95A.

-054
1.69A.

06-24-017-900-011

3.54A.

FOWL

06-24-003-900-001

9.74A

234.71

593.80
235
149.27

209.8

BLOCK
-034
.97Ac. 1.58Ac

B35
-035
1.62Ac.

-033
0.97Ac

235

619.29

235.00

70 -002

71 -003

72 -004

73 -005

74 -006

REVERSECT

VILLAGE

80

60

-06-
1.02

2.40

109 043
133 14

60

170 -024
150.48

169 -023