


9672
9667

APPROVED LORAIN CO. MAP DEPT.	
DATE	6-9-76
PAGE	700-038-B
BY	<i>Probert</i>
VOID AFTER	

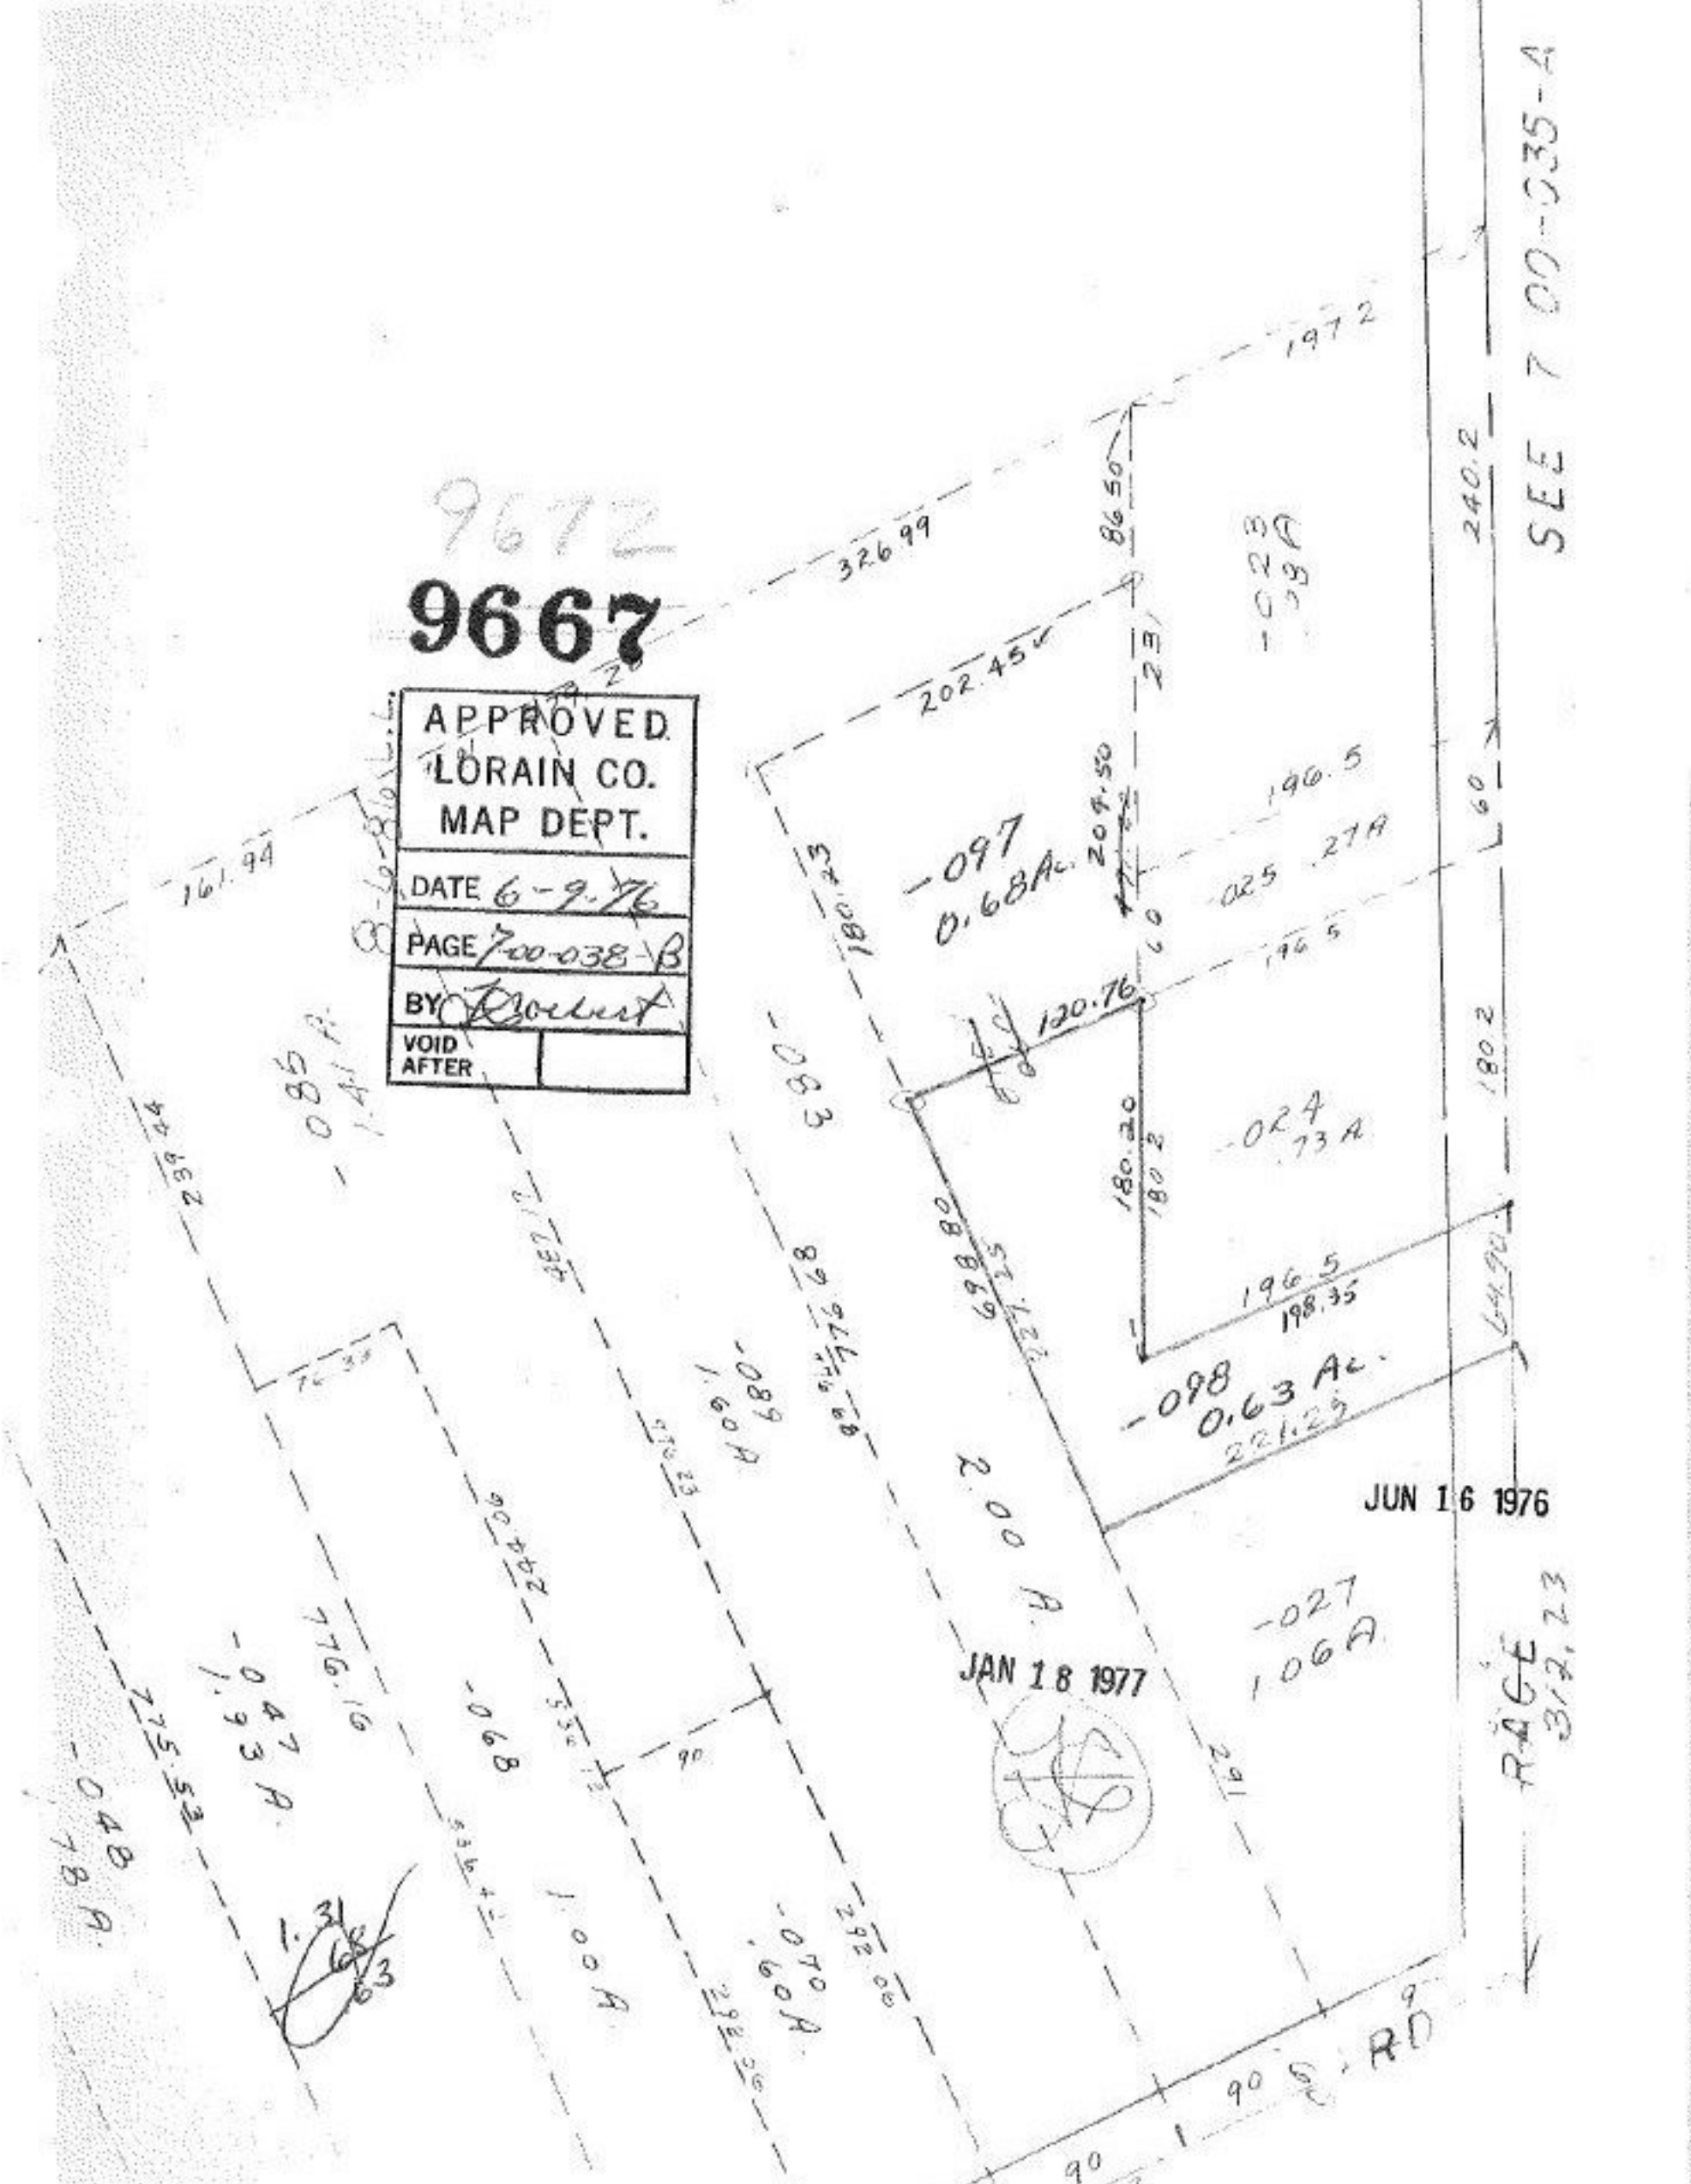

SEE 700-035-A

JUN 16 1976

JAN 18 1977

PAGE
312, 23

90' RD