


9699

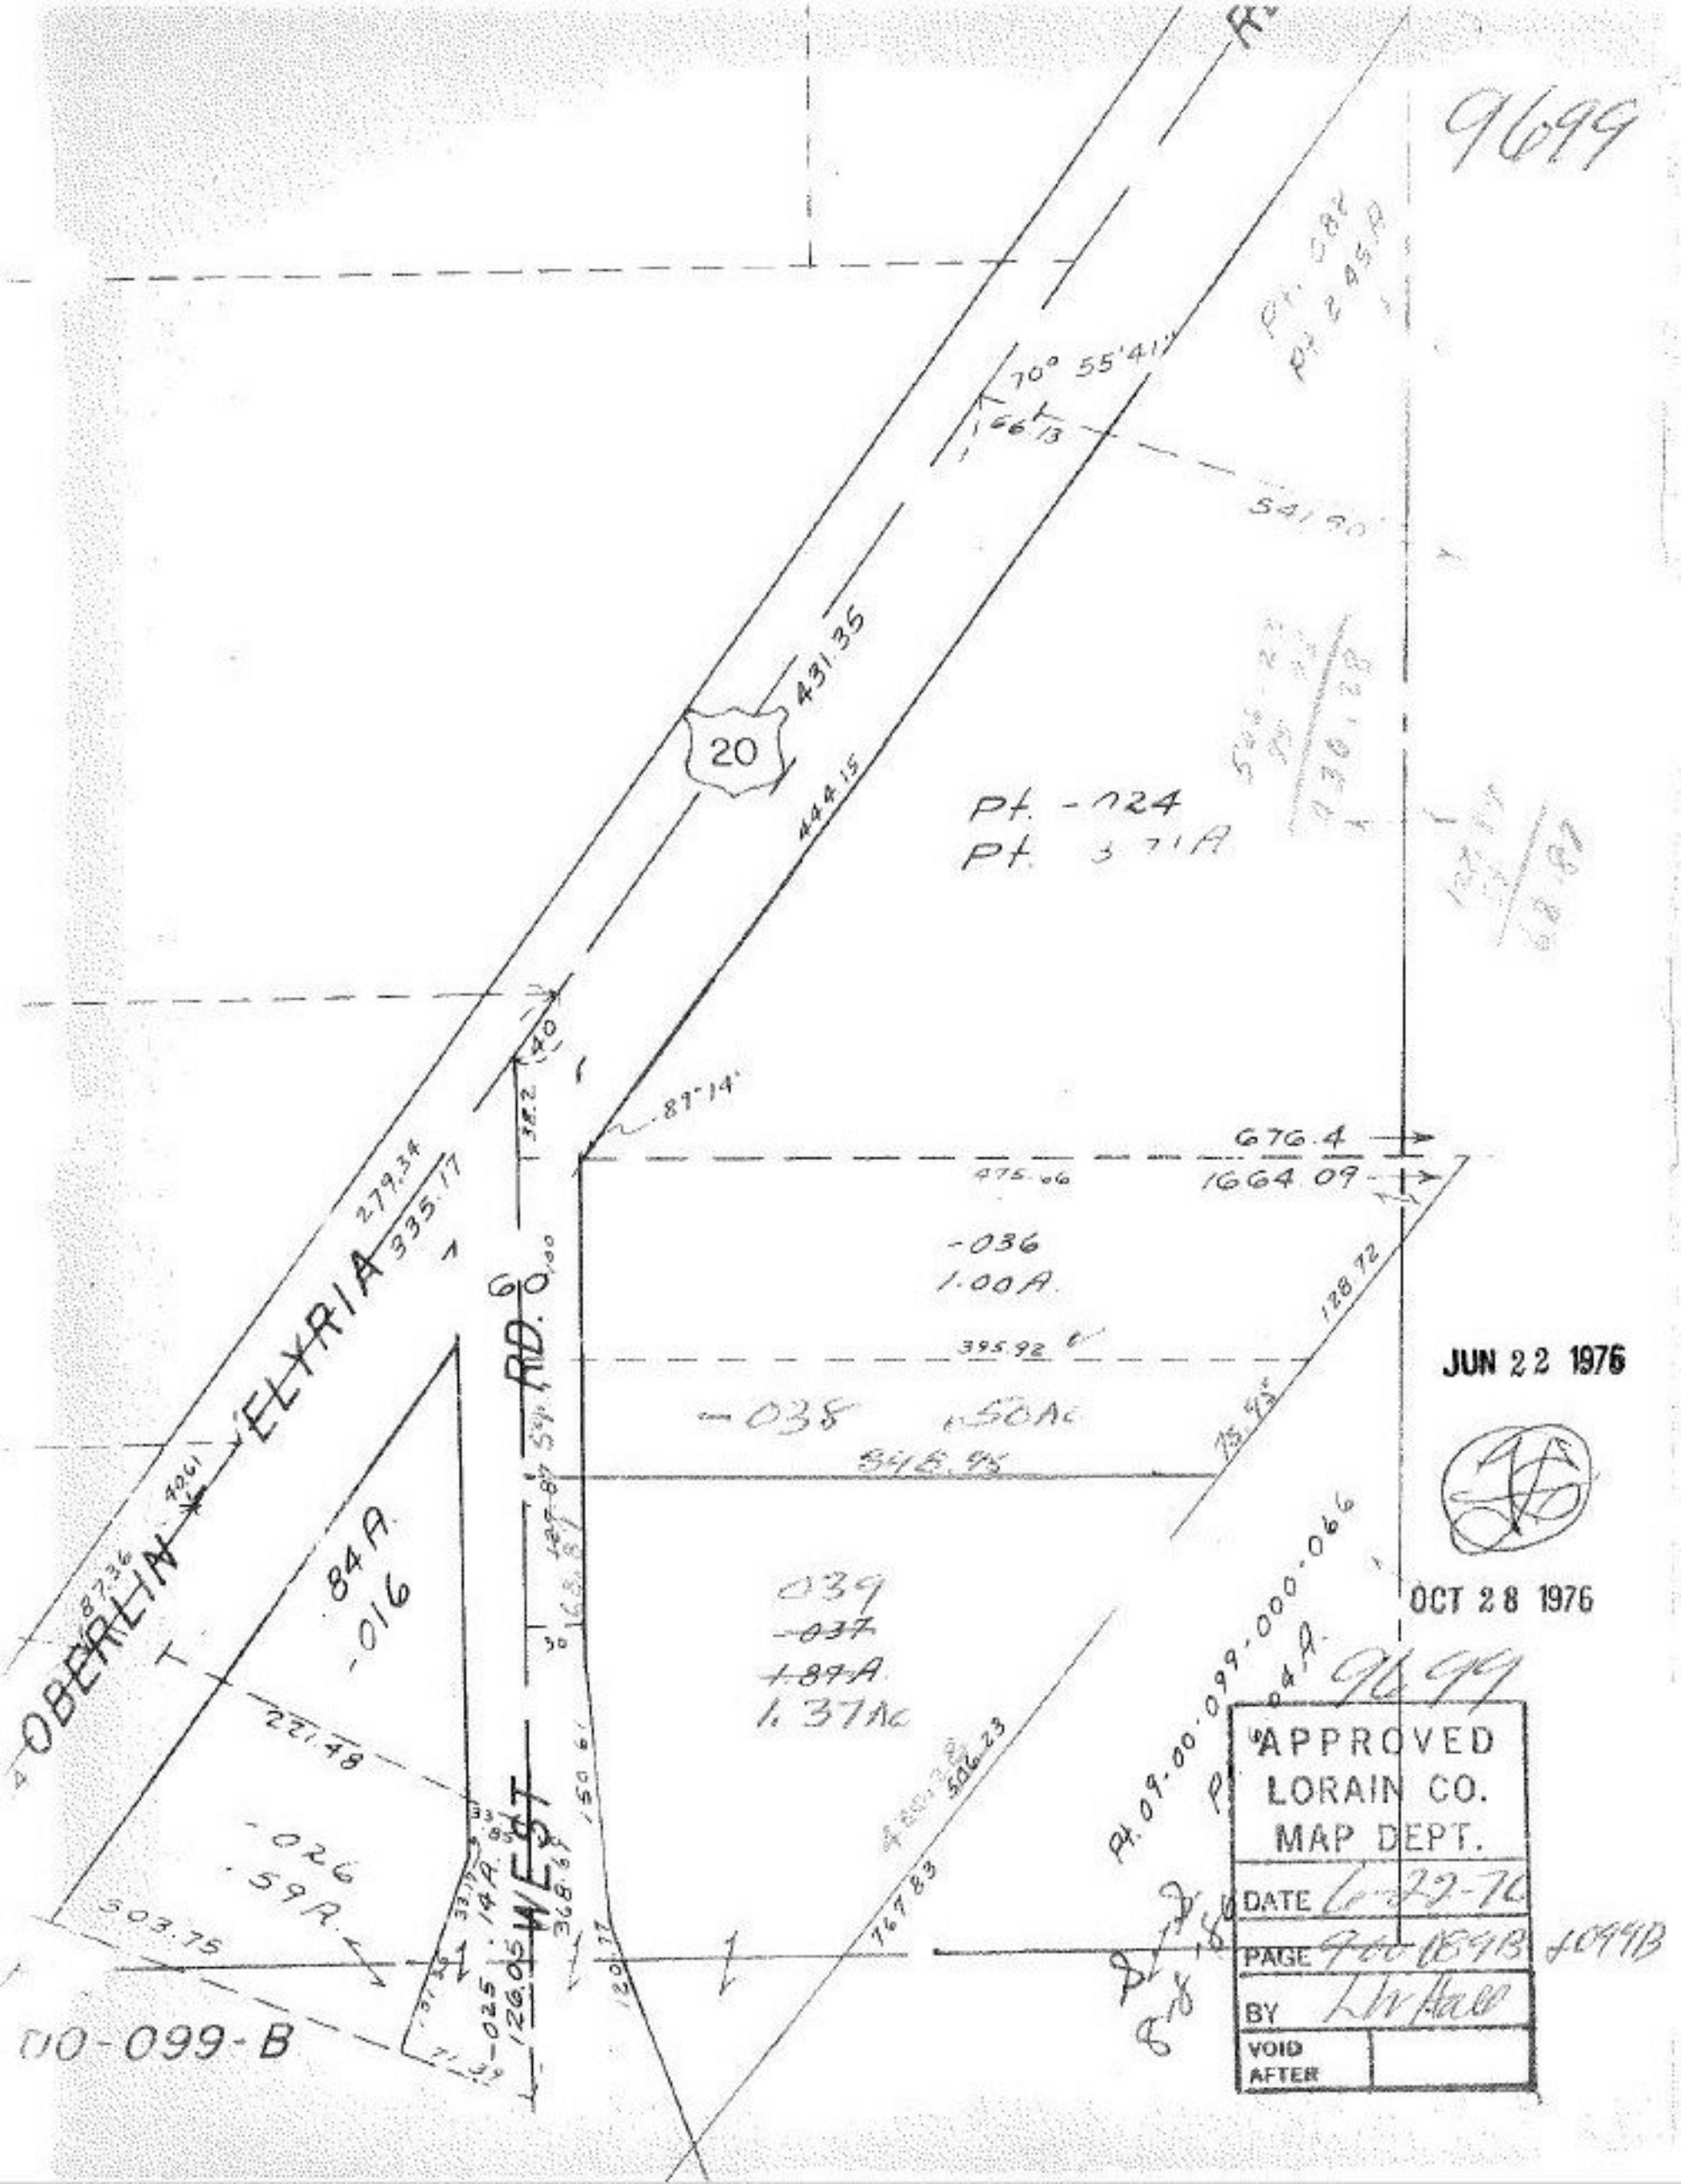

PT. 082
02 2 05 10

PT. - 024
PT. 371A

~~107 117
107 117
68 87~~

JUN 22 1976



OCT 28 1976

APPROVED	
LORAIN CO.	
MAP DEPT.	
DATE	6-22-76
PAGE	700-1891B 10991B
BY	LW Hall
VOID	
AFTER	

4.09.00.099.000.066
P.A.A.

00-099-B