


9727

SEE 6-125

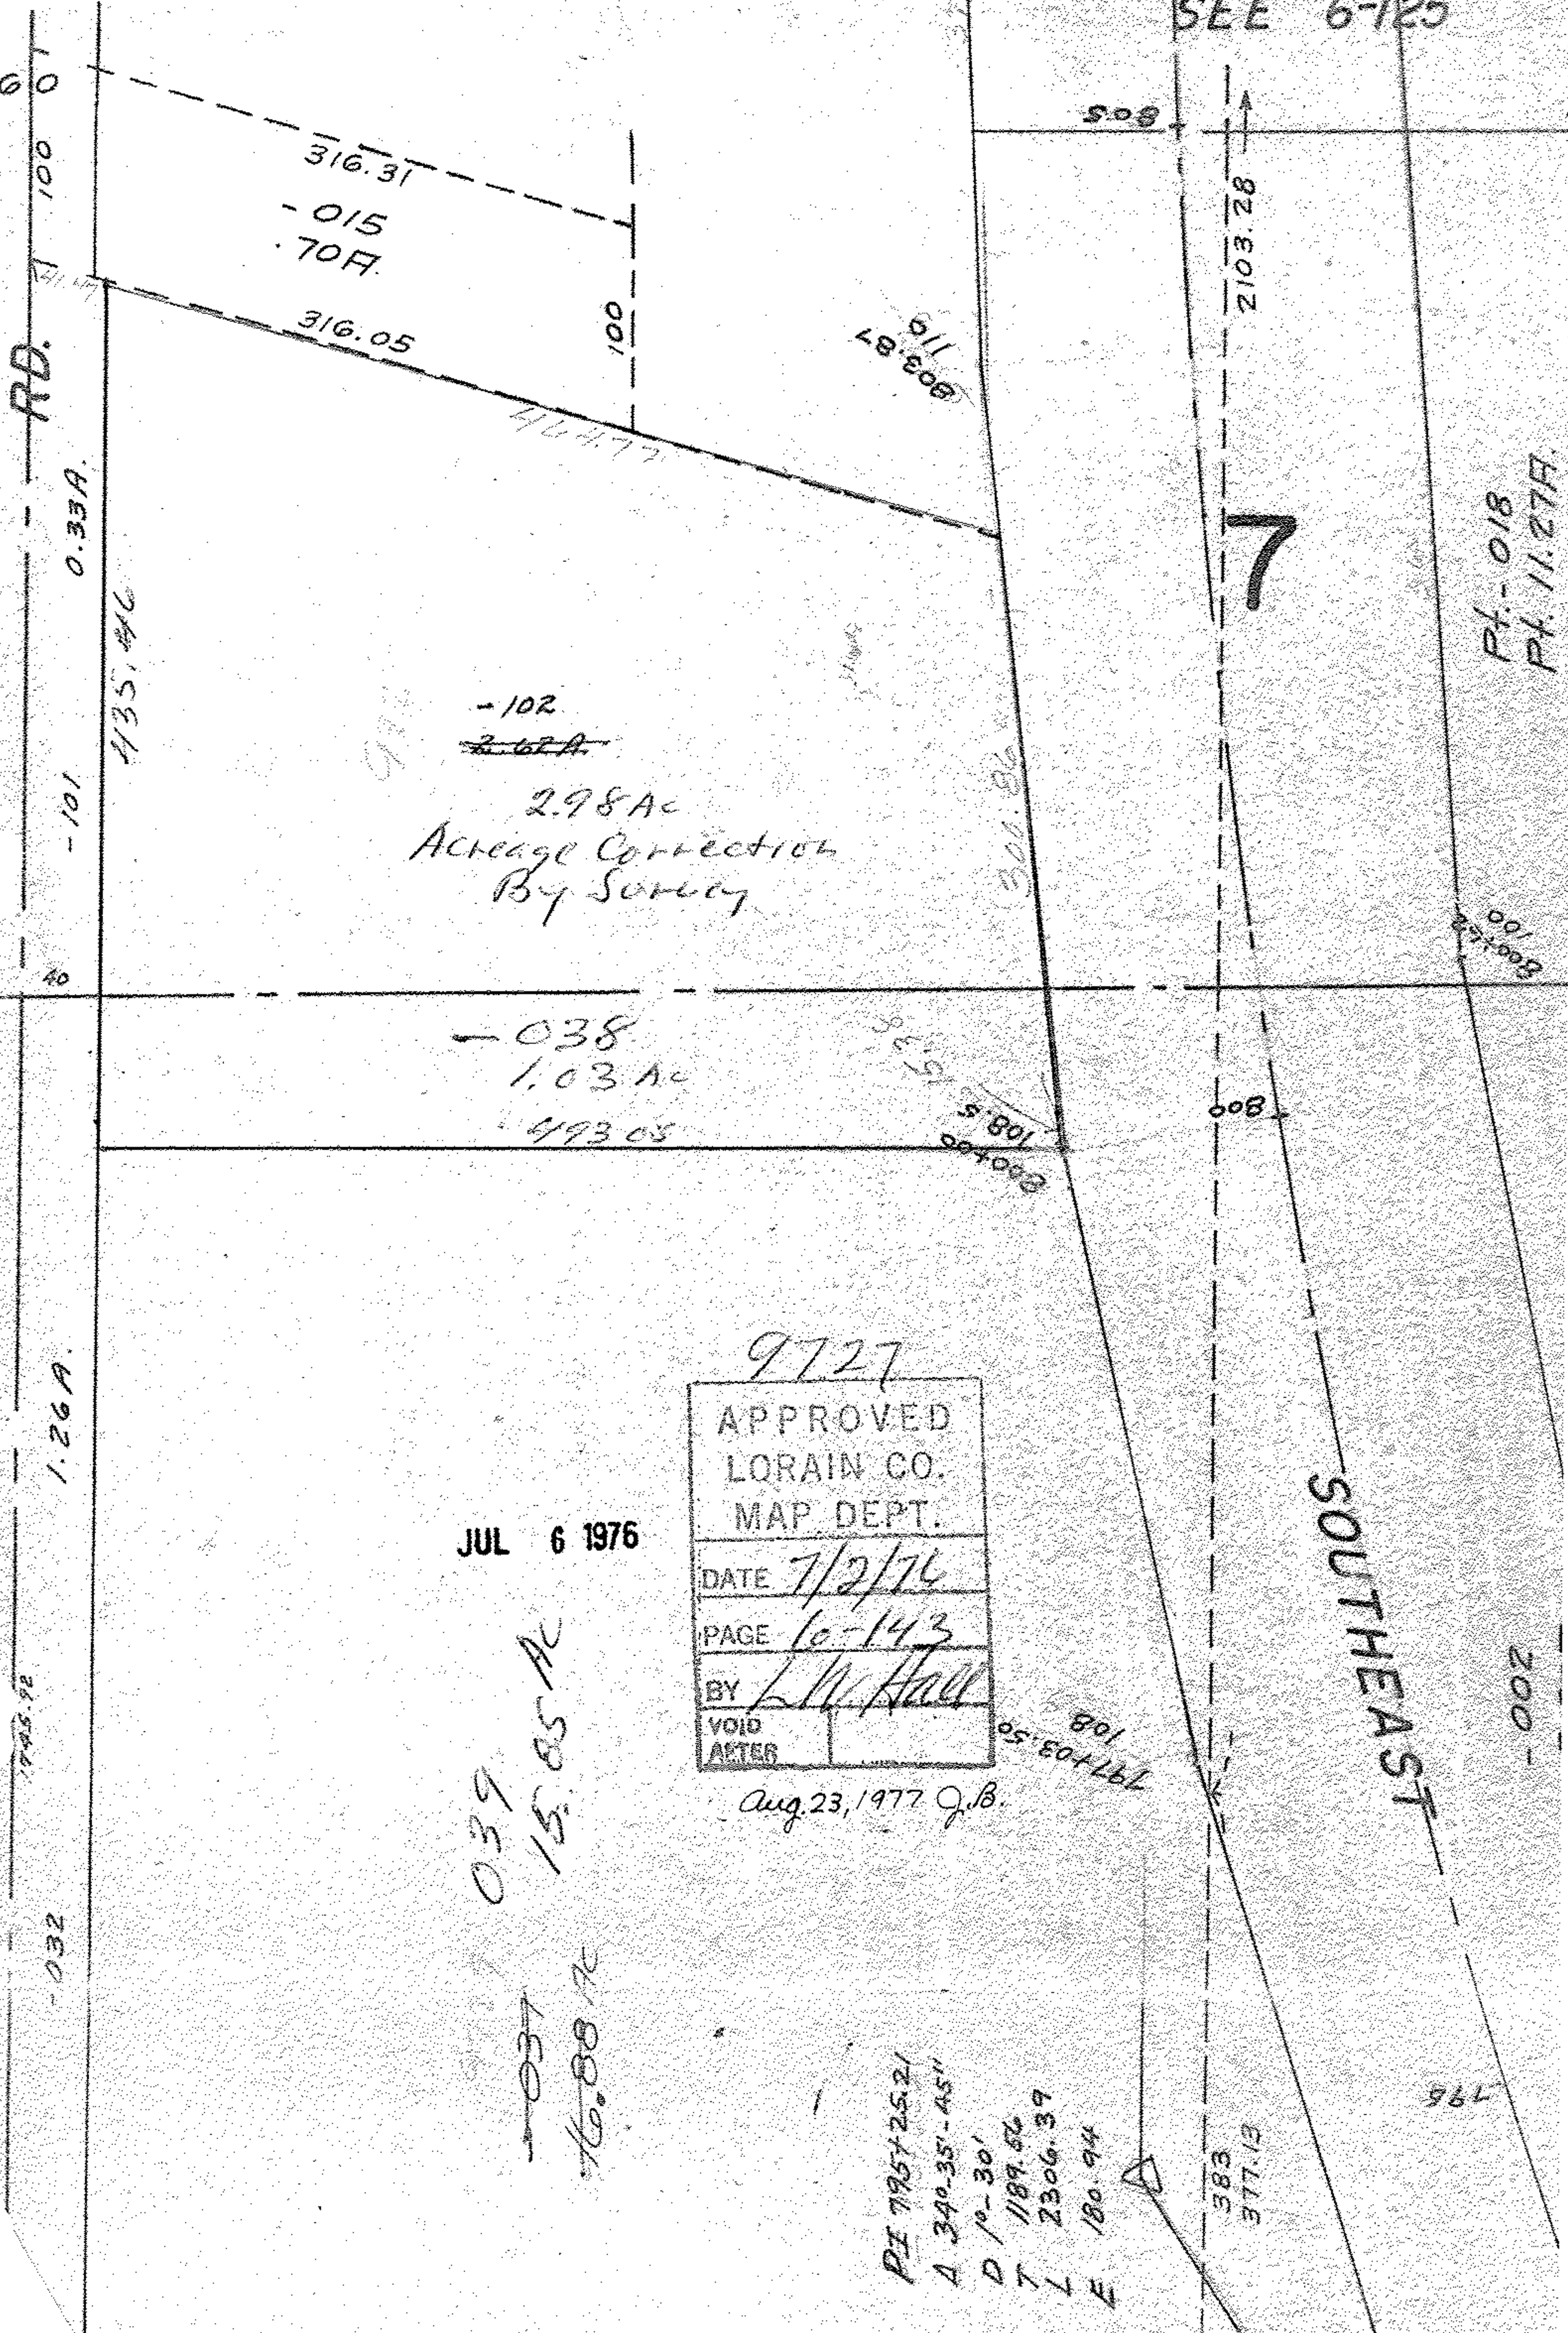

-102
~~2.67 Ac~~
2.98 Ac
Acreage Correction
By Survey

-038
1.03 Ac
493.05

039
15.85 Ac

037
16.88 Ac

9727

APPROVED
LORAIN CO.
MAP DEPT.
DATE 7/2/76
PAGE 10-143
BY L. W. Hall
VOID AFTER

JUL 6 1976

Aug. 23, 1977 J.B.

PI 795725.21
 A 34°-35'-45"
 D 1°-30'
 T 1189.56
 L 2306.37
 E 180.74

SOUTHEAST

200-

PI. 018
PI. 11.27A

383
388
311E

795

800

2103.28

500

803.87
116

301.86

108.5
804.00

197+03.58
108

RD. 100 01

0.33A

1.26A

032

SEE 6-125