

57

137  
5.30A.

# 9736  
7-1-76

11-00-099-B  
LW Haul

8-4-86

HYANIS

400

OCT 15 1976

215  
213  
Pt. 211 43.89  
Pt. 45-03A 43.75



212  
1.14 Ac

330.21  
329.90

-030  
1.48 A.

JUL 6 1976

-015  
71A

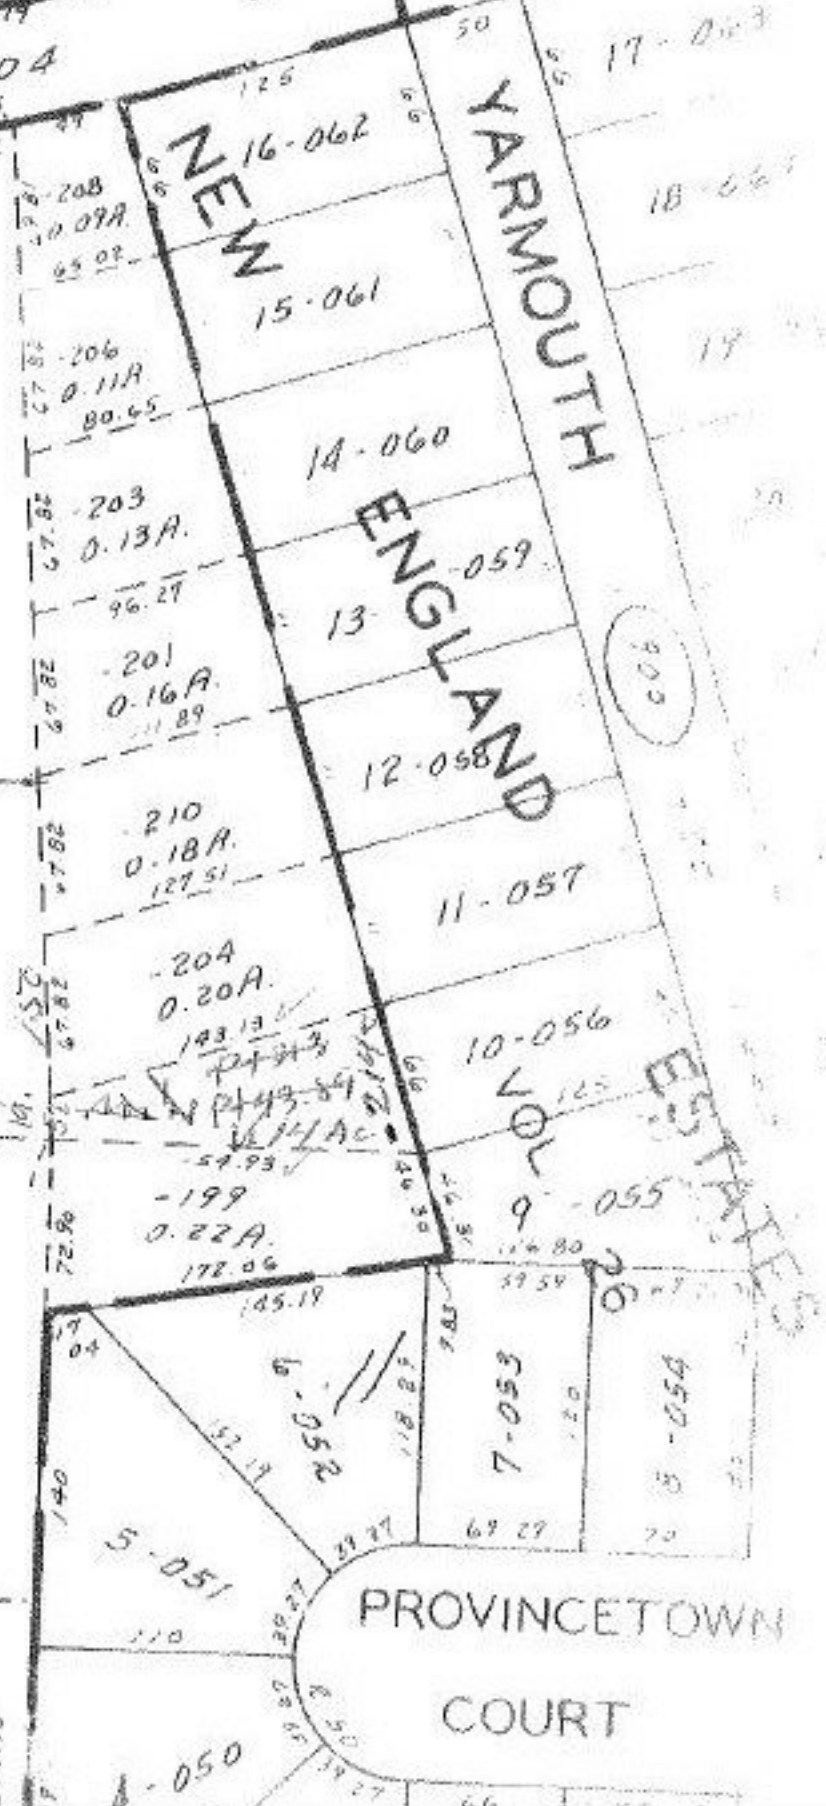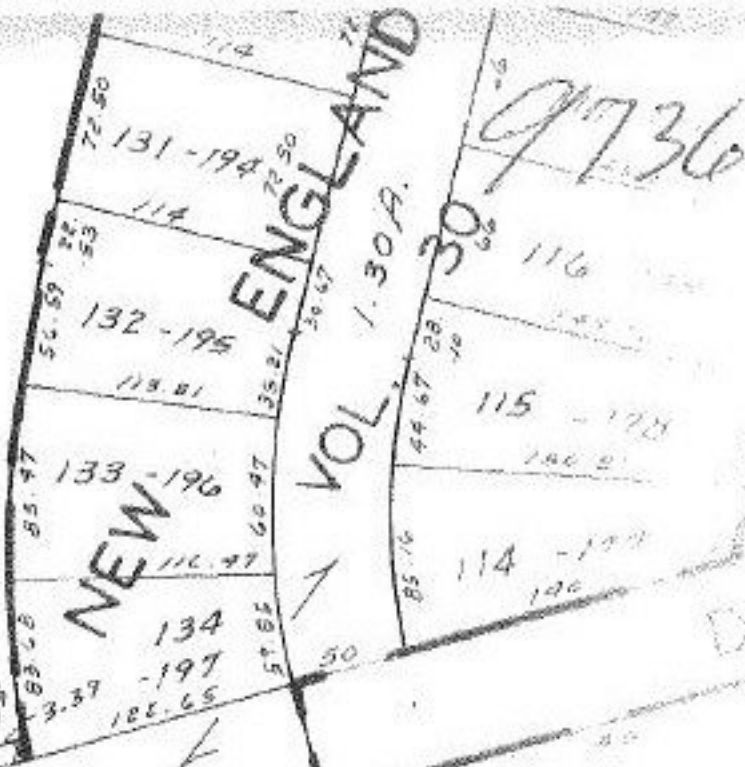

PROVINCETOWN  
COURT

-006  
1.33A

42.38

