


9777

SEE 20-C

JUL 16 1976

9777

APPROVED	DATE 7/14/76
LORAIN CO.	PAGE 20-C 20-05 0936
MAP DEPT.	BY <i>[Signature]</i>
VOID AFTER	

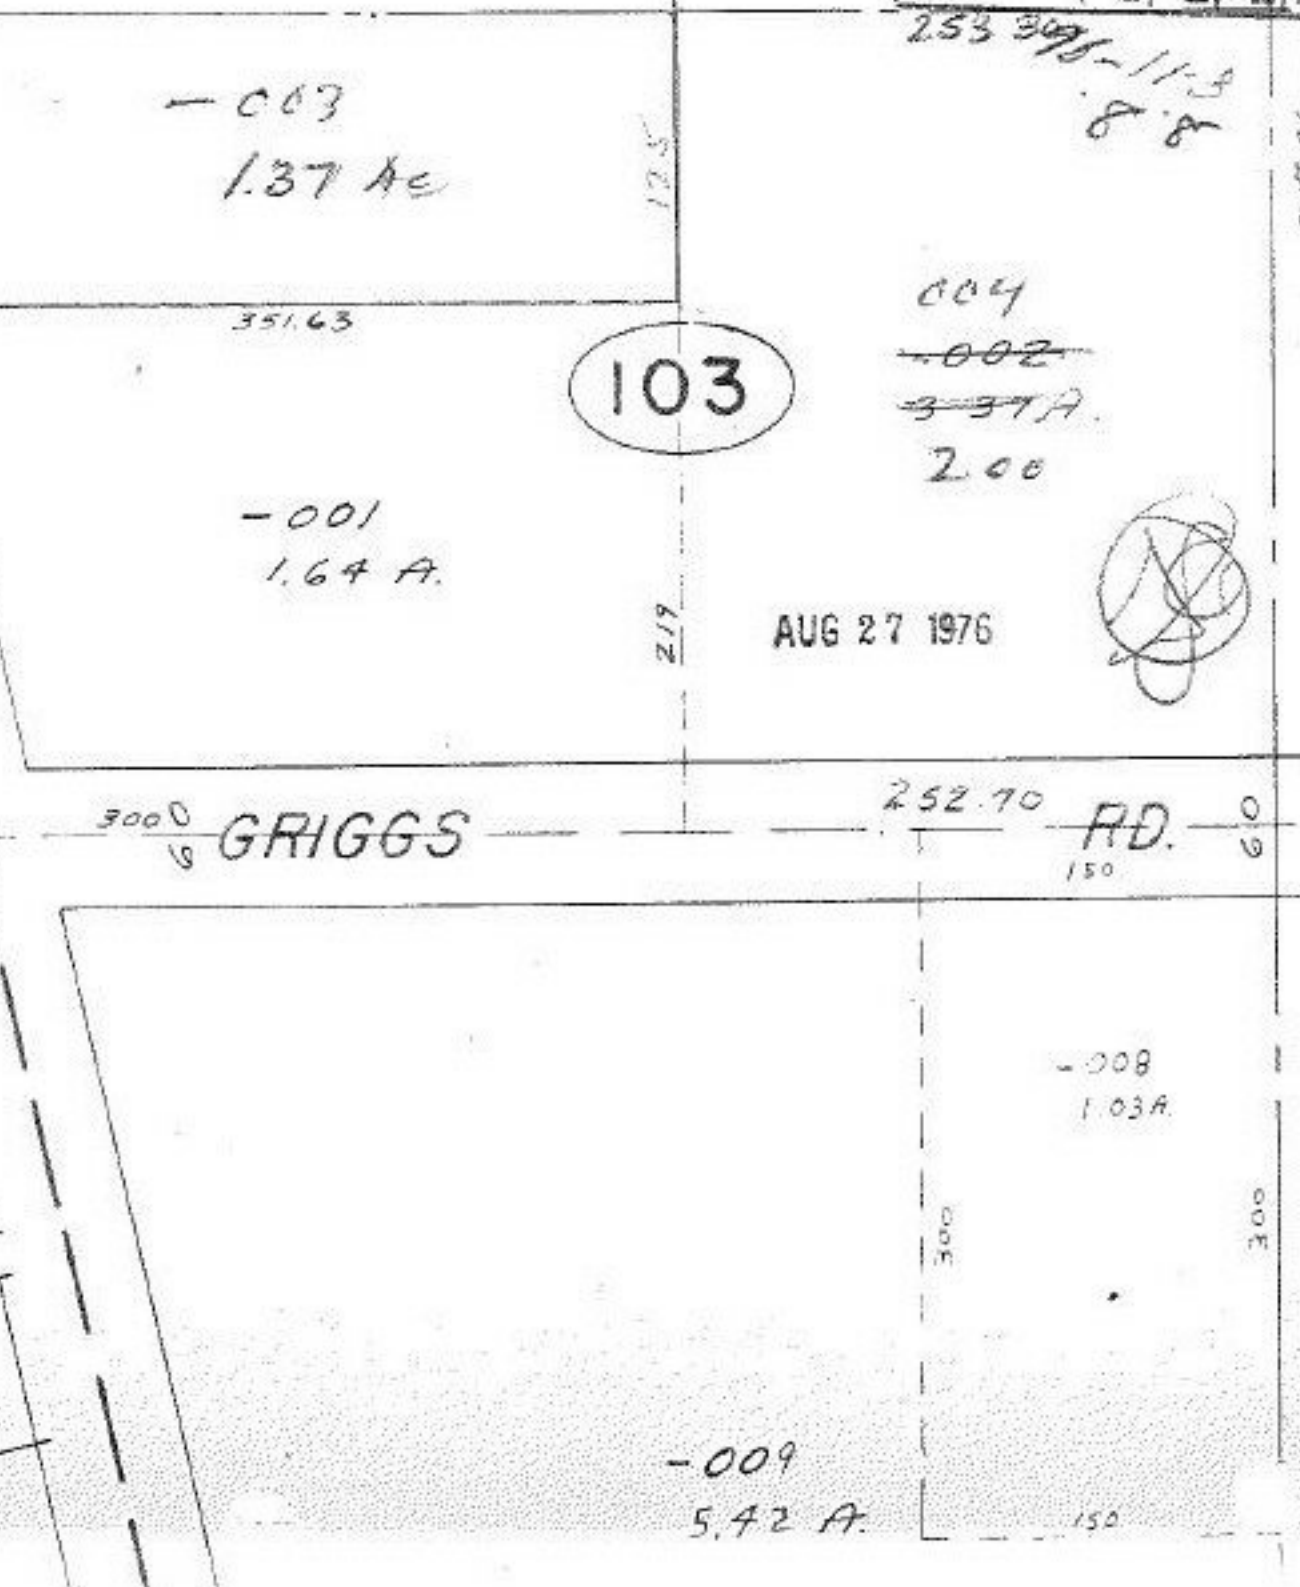

AUG 27 1976



253 396-113
8 8

7/7 36