


PORTMAN

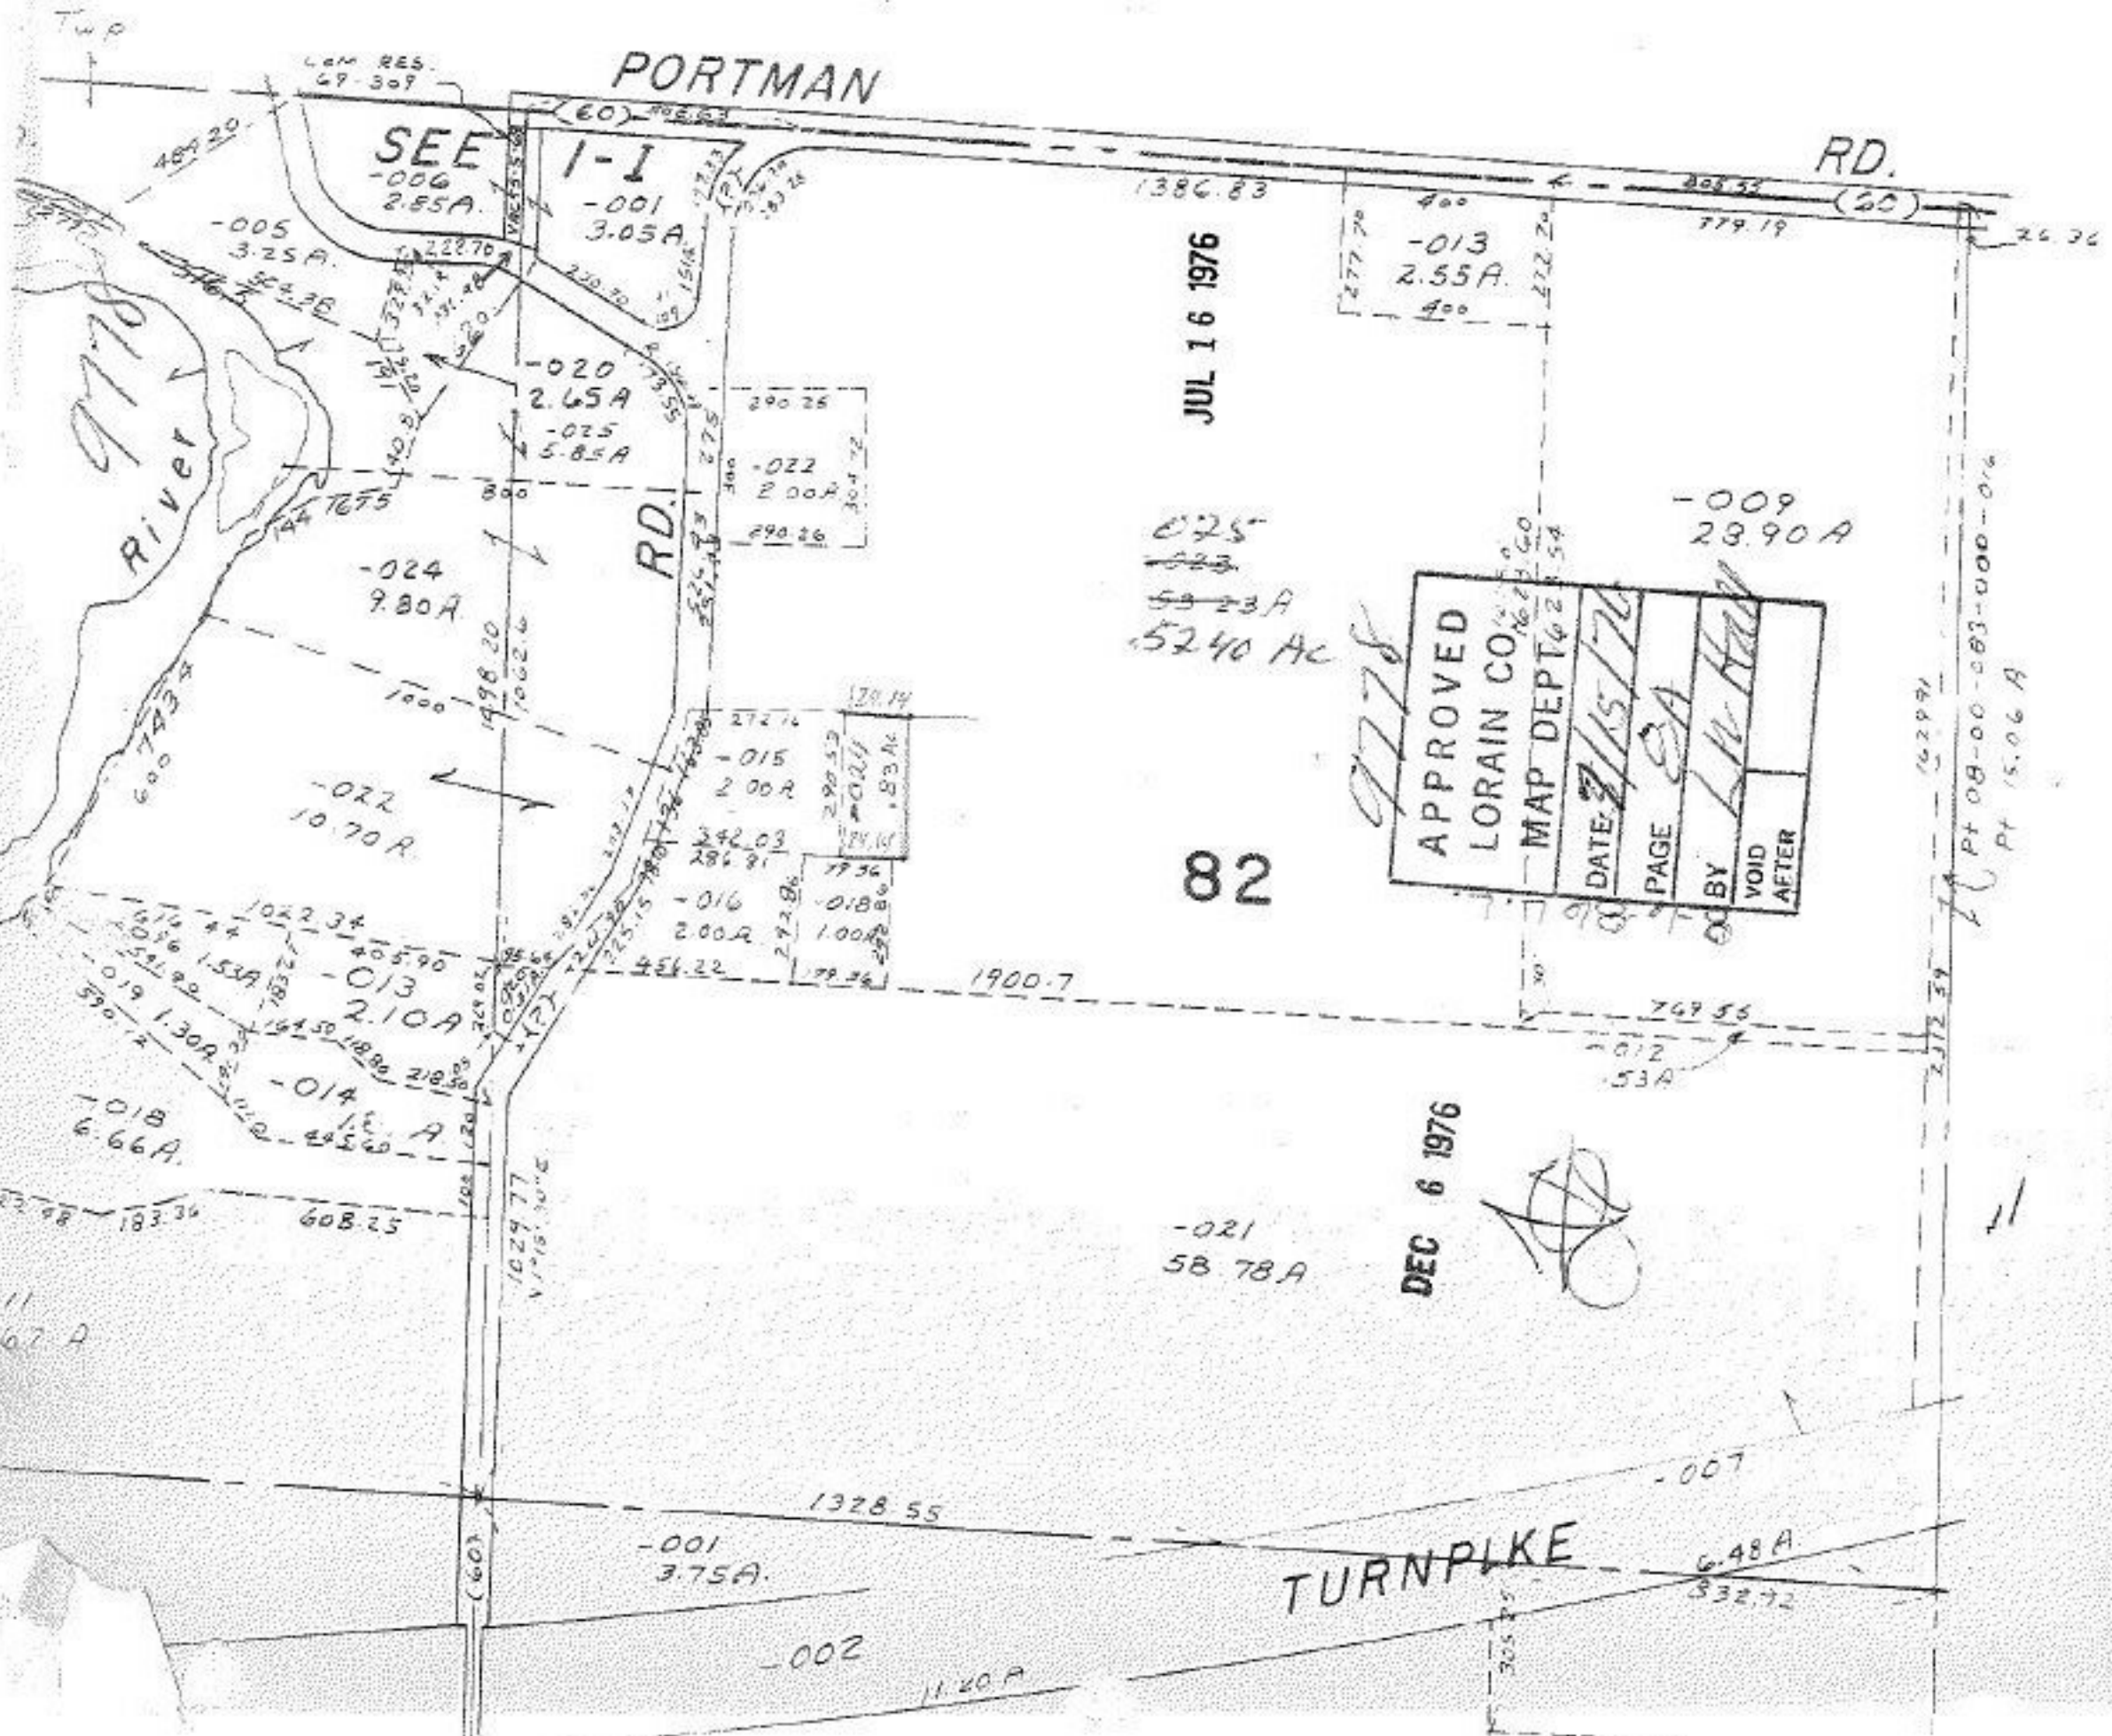

JUL 16 1976

025  
~~523~~  
523A  
5240 AC

82

APPROVED  
LORAIN CO  
MAP DEPT

DATE: 7/15/76  
PAGE: 5A  
BY: L.W. HALL  
VOID AFTER

DEC 6 1976

