


L a k e

9770

MAY 6 1977 JUL 23 1976

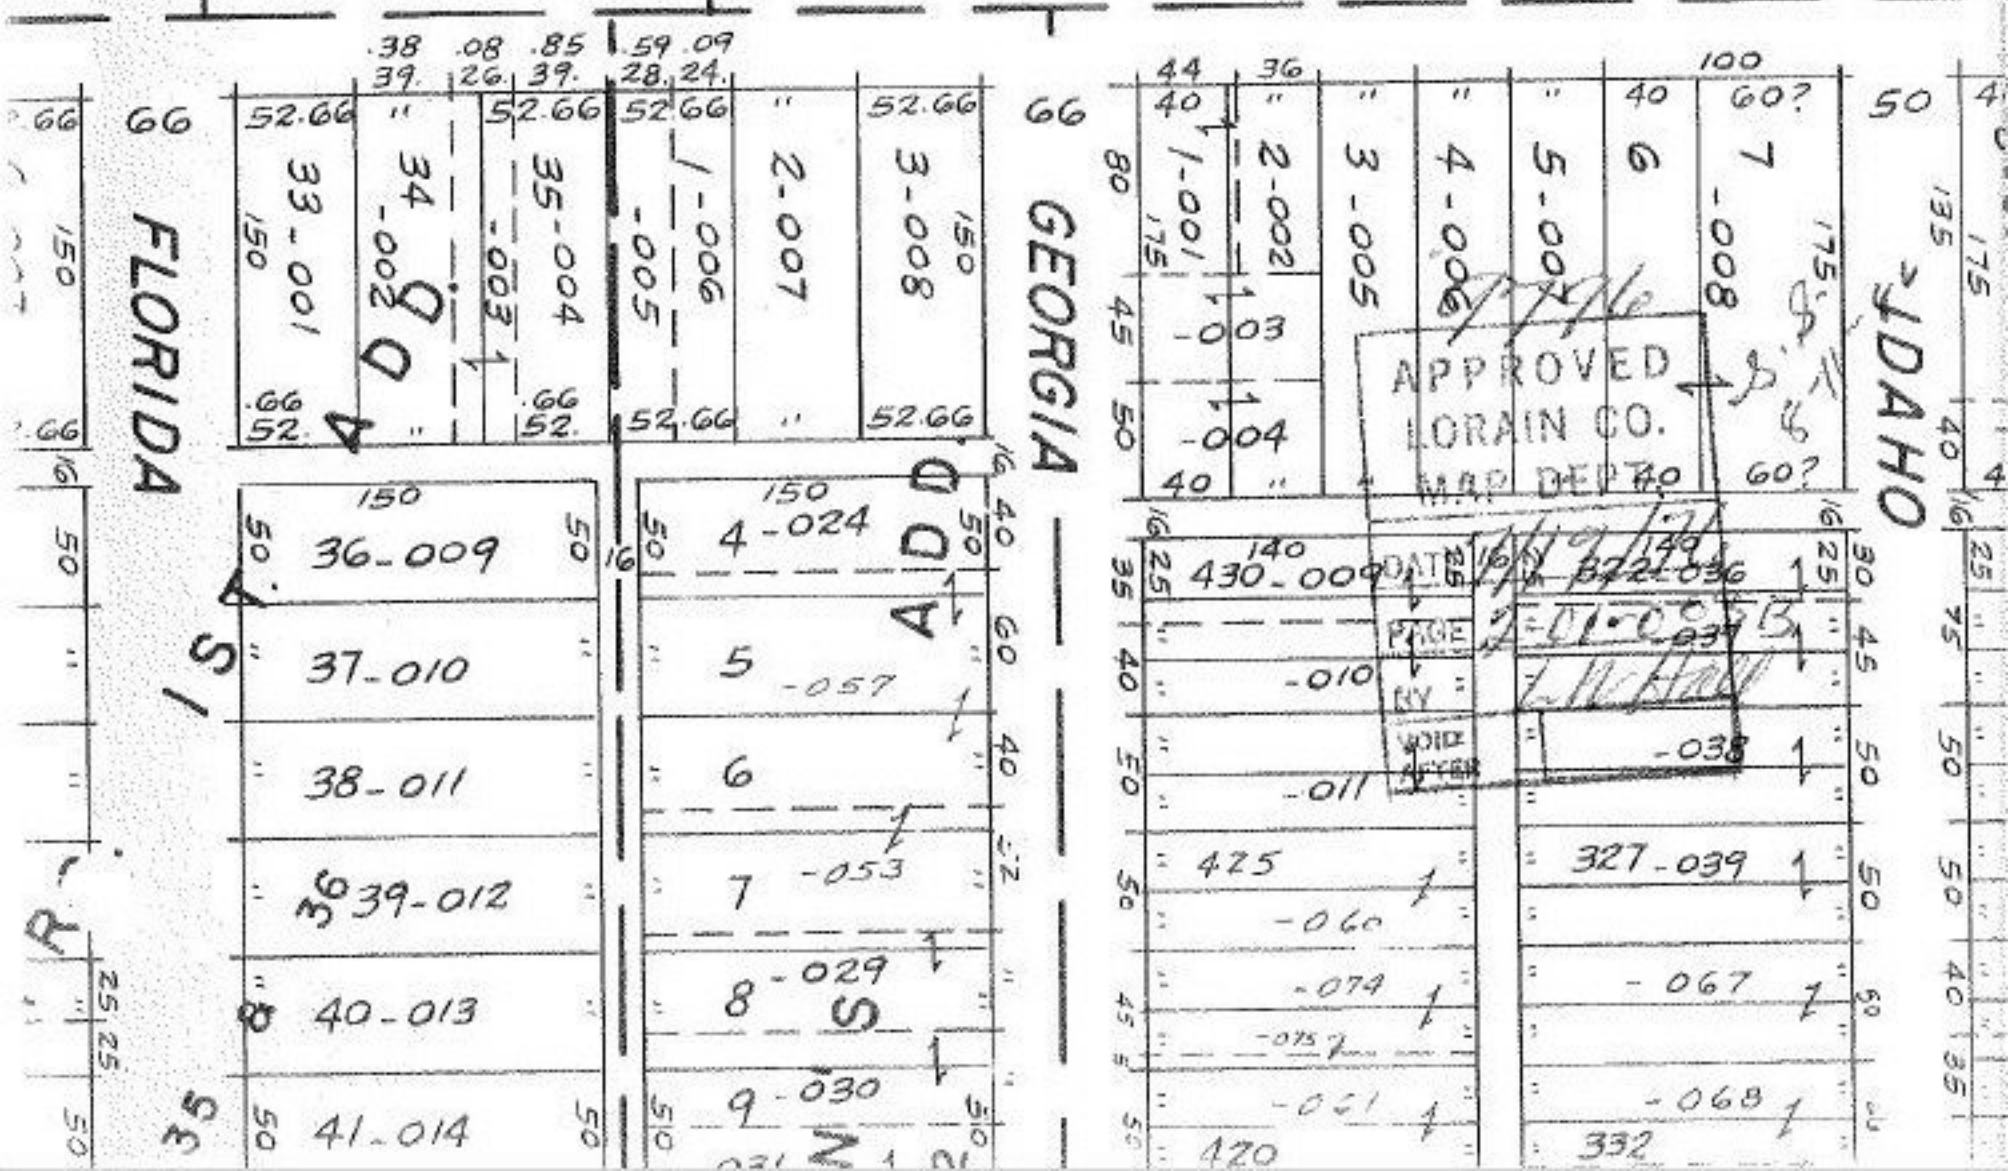

APPROVED
LORAIN CO.
MAP DEPT

DATE: 10/19/77
BY: [Signature]
WORD: [Signature]