
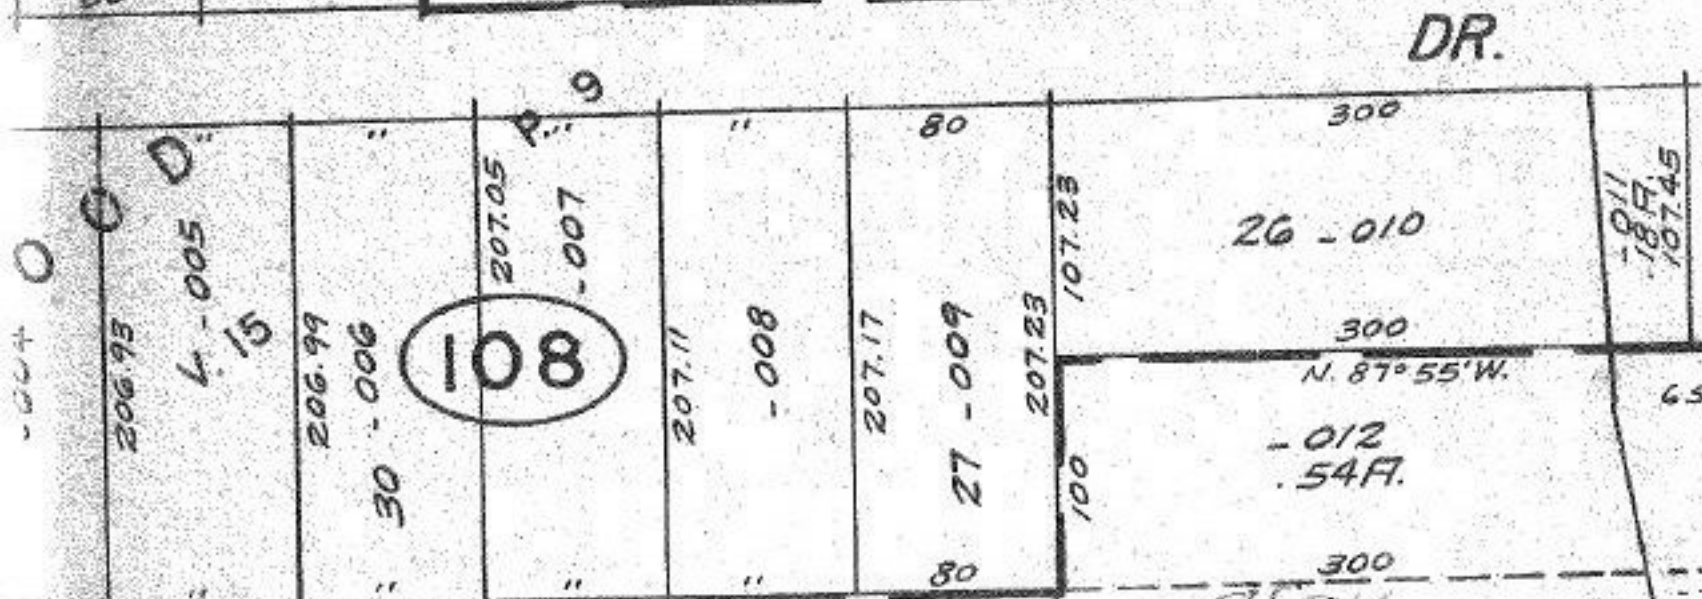


9804

TURNPIKE

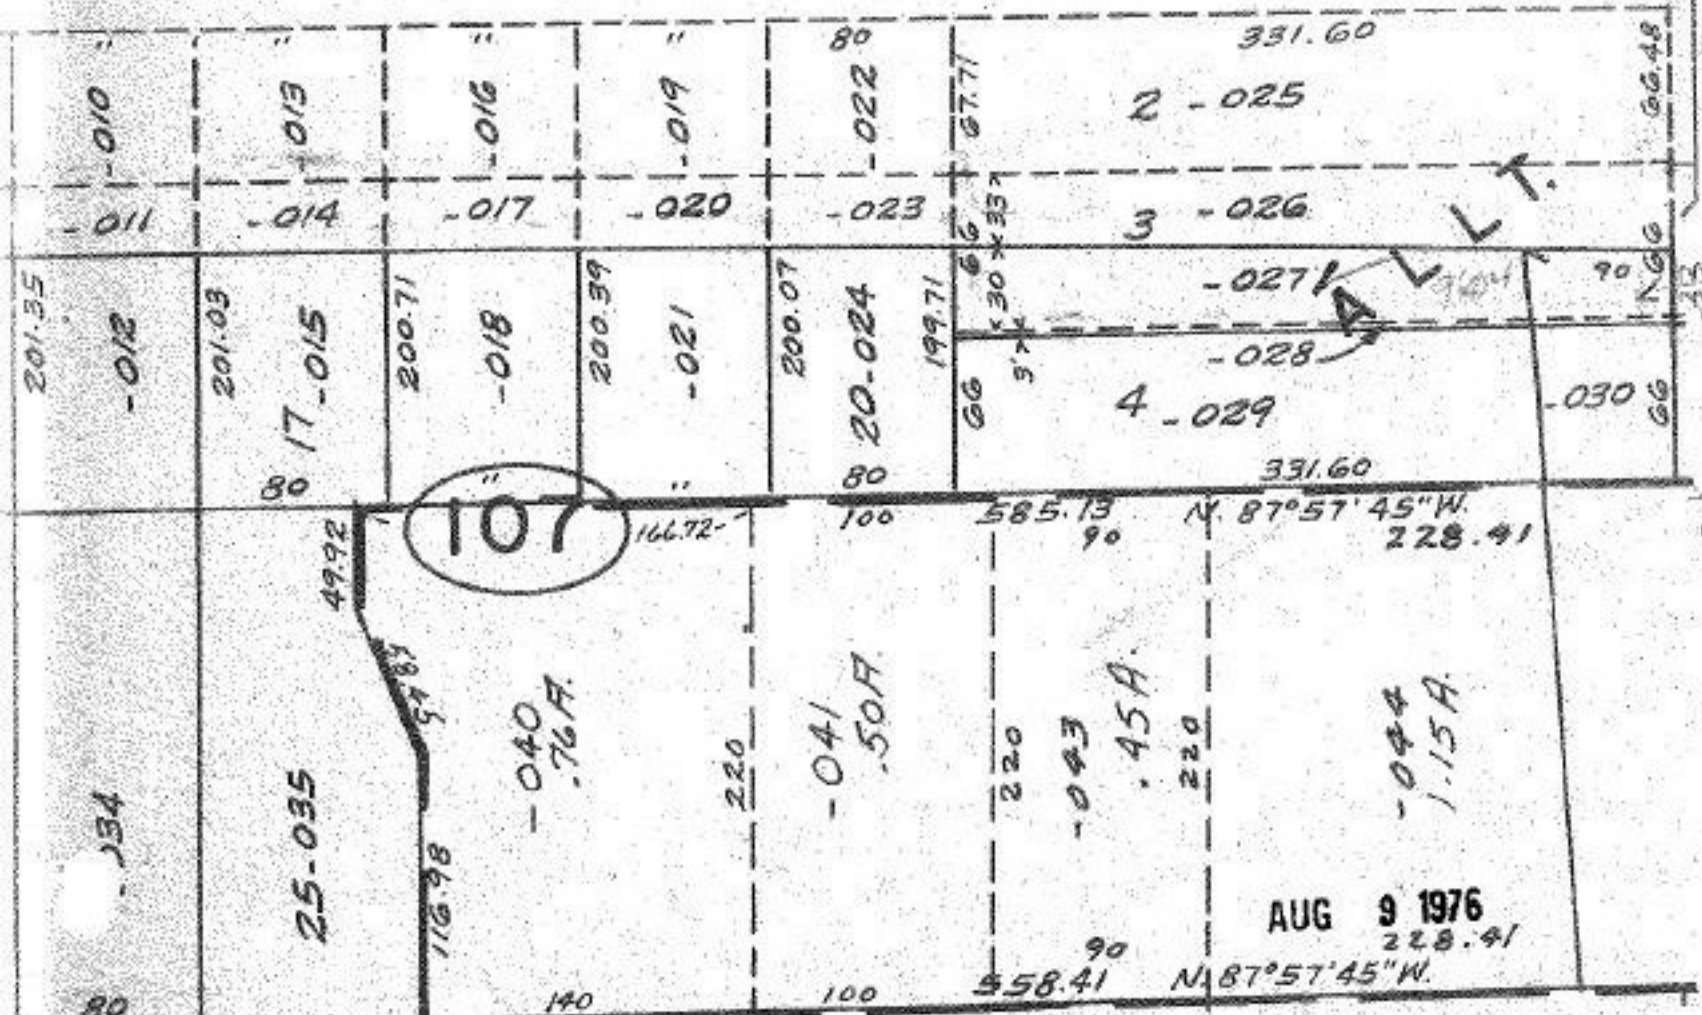

JAN 18 1977

2

9804

APPROVED
LORAIN CO.
MAP DEPT.

DATE 7/30/76

PAGE 7-00-027D

BY L. W. Hall

VOID AFTER

76

SEE 7-00-022-C