

9830

STEWART

268.37  
-004  
10 A.  
162.35  
268.37

(60) 238  
795.24

1000

3995±

2716.86

3546.76

9830 JUL 29 1976

APPROVED LORAIN CO. MAP DEPT.	
DATE	7/29/76
PAGE	214
BY	LW Hall
VOID AFTER	-001 52.00 A.

8.8.11.86 C

2700± 2634.42

30.00 Ac

35.00 Ac

35.00 Ac

~~003~~  
65.00 Ac

21

2654.27

-004

2643.42

±001

92.78 A. Map & D.  
93.00 A. Dup.

-001  
52.00 A.

A

20

005

AUG 27 1976


R

495.21

2964.21±  
885

Stewart R.  
3995±

23/3

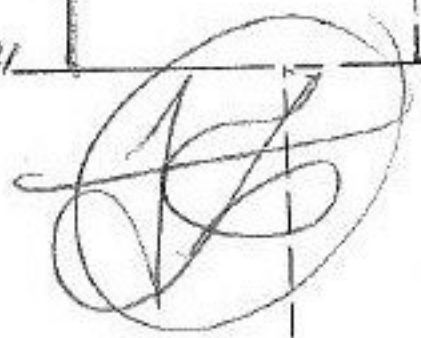

T