


MEADOW PT. 4.09A. PG. 51

7-00

SEE

JAYCOX

AVE.

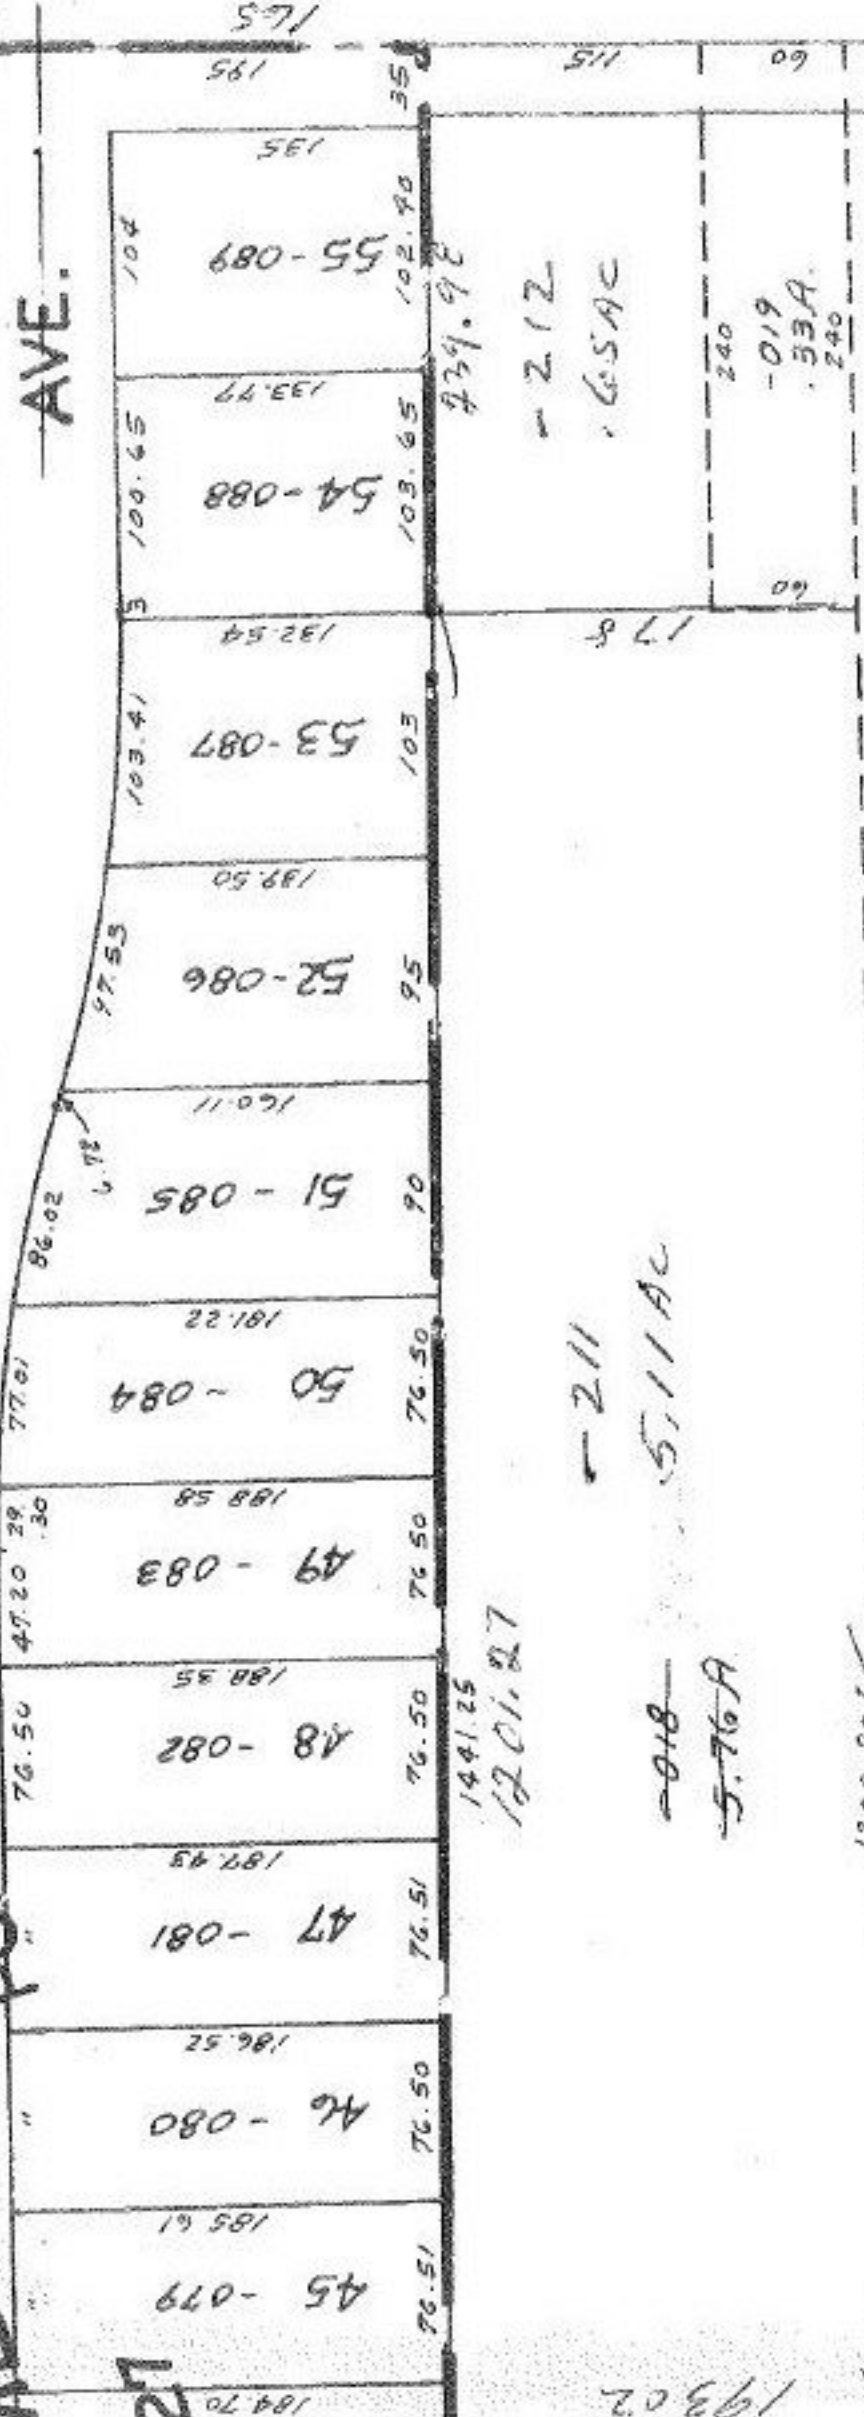

9853

JAN 18 1977

AUG 25 1976

SEE 7-00-019-D

9853

APPROVED
LORAIN CO.
MAP DEPT.
DATE 8/9/76
PAGE 7-00-019 B
BY L.W. Hall
VOID AFTER

193.02