

0-013-B

2225.90
Fr & Rec'd Rd


DV 1128 Pg 164
Located Easterly along E a distance
of 351.72 ft N.W. Cor of Land from rd to
70 Golden Water 179-61 DV 790 Pg 158
351.72

RD 100

05
50A

482.47

Tax map
Correction

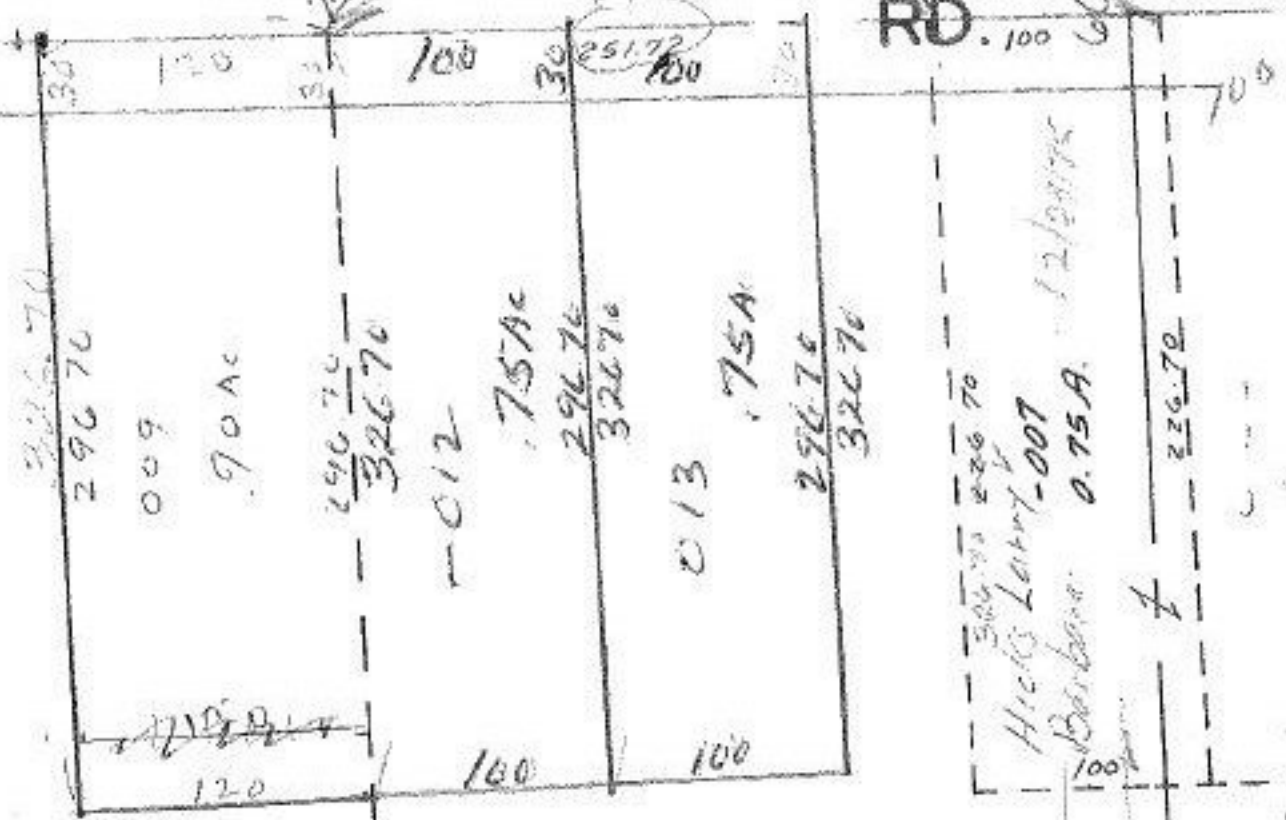

111

1436.82
1435.50

FEB 4 1977

AUG 30 1976

9890

APPROVED	
LORAIN CO.	
MAP DEPT.	
DATE	8/27/76
PAGE	11-00-014 R
BY	LW Hill
VOID	
AFTER	

808 - C14
936A 7.86 AC

(1128 Pg 164
7/18/76
More Value
M.F. Jander
To More Value
Hence
Known
as Parcel No. 11A-11-017

Sheriff Tho.
64 AC to 200
11A-11-017

12/19/75

Good Rich
Mary R 11-00-007-000-055
7-18-75
DV 1138 Pg 929

Pt. ~~006~~ - 011
of ~~4819A~~ 25A