


JAN 18 1977

9894

To Combine  
parcels  
025-200-24.05

SEP 1 1976

SEE 7-00-018-D

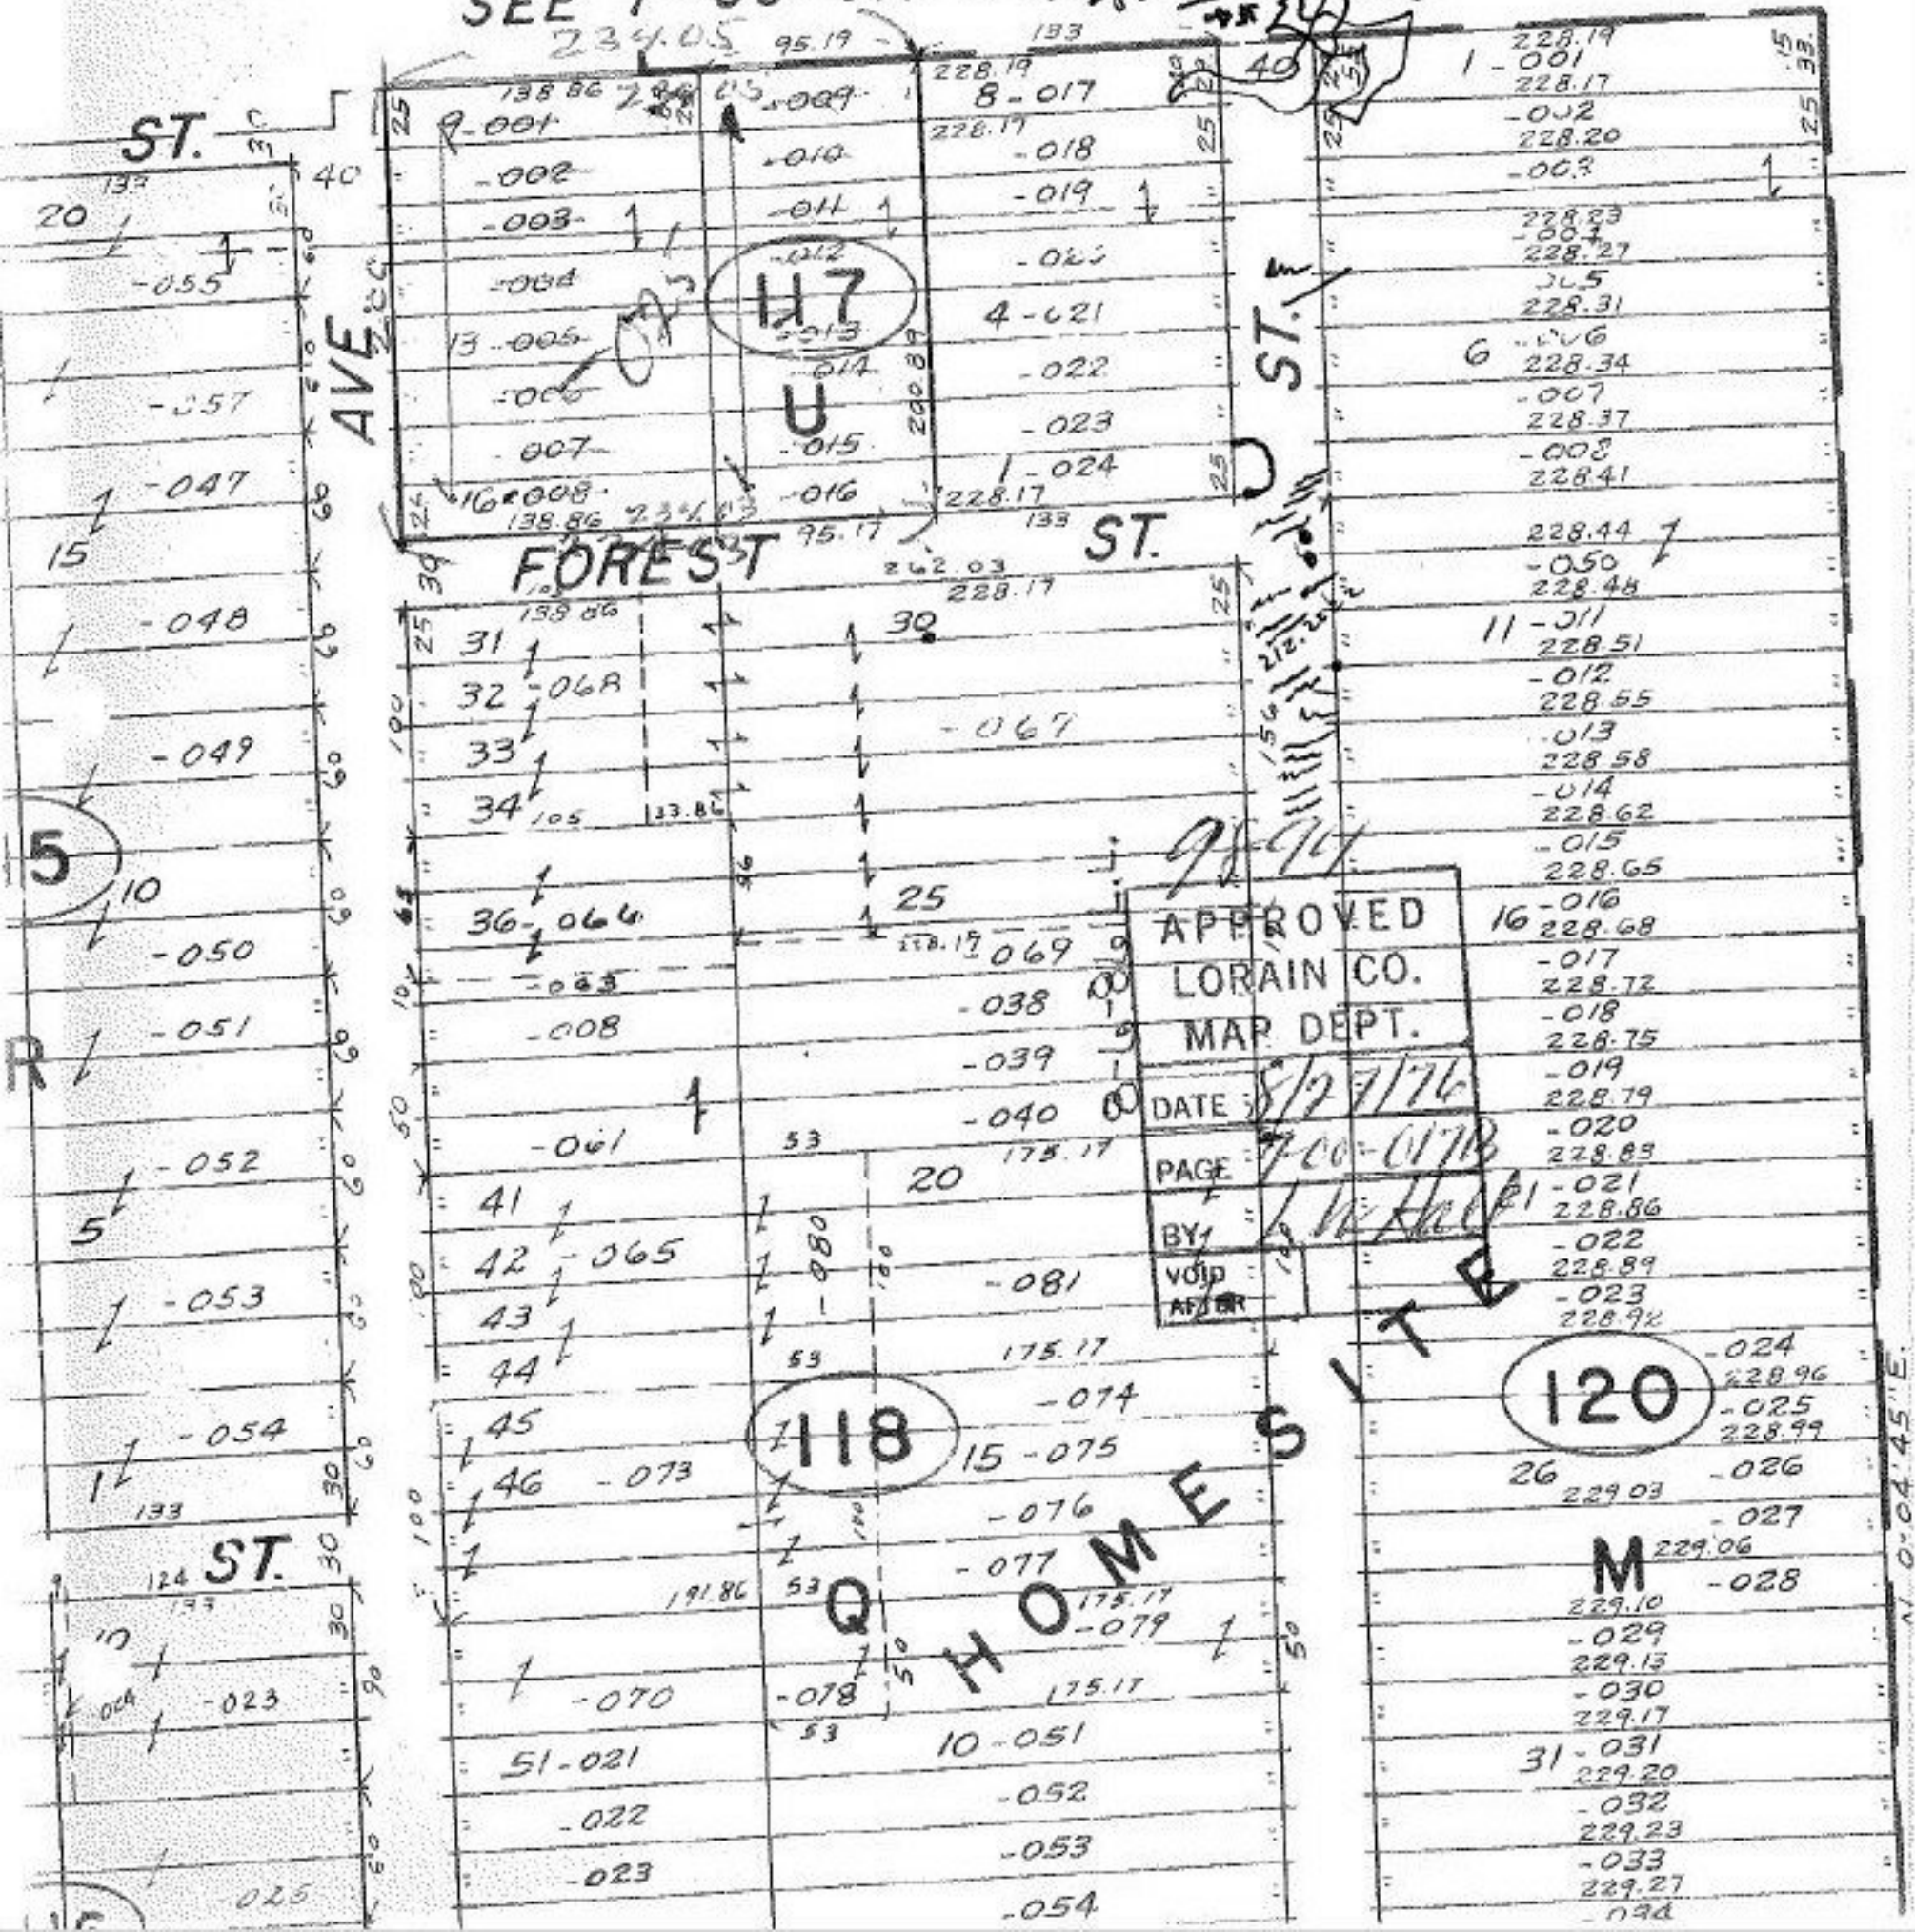

APPROVED  
LORAIN CO.  
MAP DEPT.

DATE: 8/27/76

PAGE: 7-00-017B

BY: [Signature]

VOID  
AFTER

118

120

HOMESITE

M

5

ST.

AVE

ST.

FOREST

ST.

N 0° 04' 45" E