

9896

St. F. Lee Nagle Rd
E 71.10

SEE 4-00-026-A

APR 15 1977




AUG 31 1976

9896

APPROVED	
LORAIN CO.	
MAP DEPT.	
DATE	8/30/76
PAGE	4-00-026
BY	L. W. [Signature]
VOID AFTER	

17798-9-8

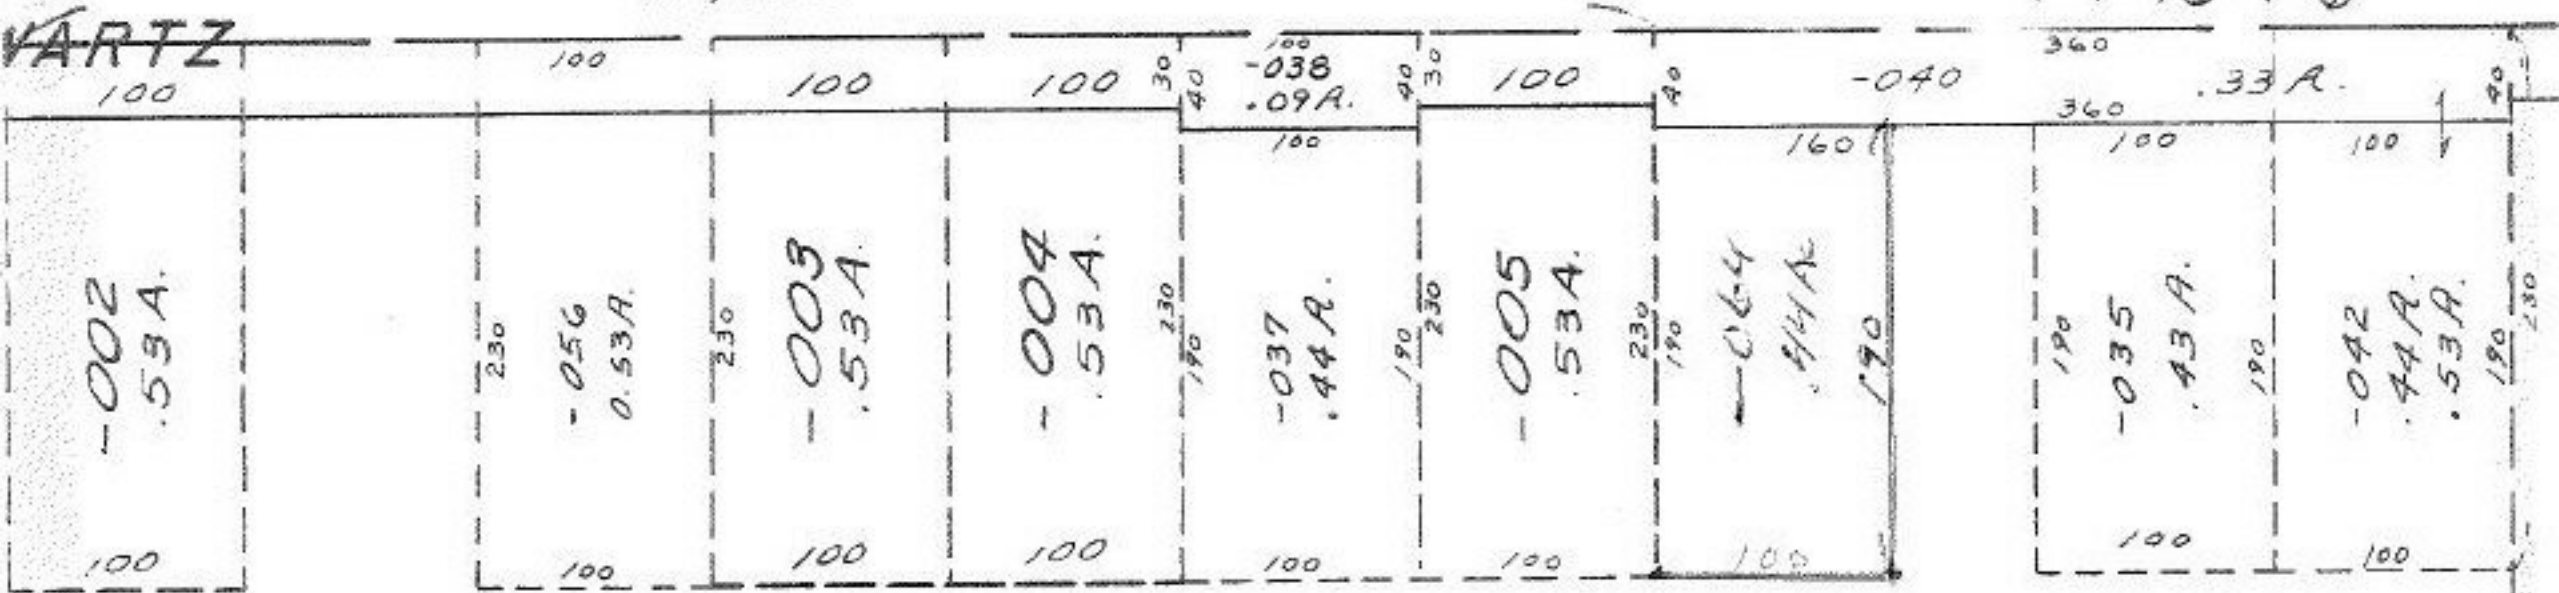

9767

~~663~~ C65
~~057~~ E.51
~~948A~~
~~8.75~~

1231.10

260